


COUNCIL NOTE:
Amend the vehicle crossover locations and car parking layout consistent with the approved "External Roadworks Plans Sheet 1" and "Sheet 2", Drawing No. C9-01 and C9-02, prepared by Robert Bird Group.

A minimum 24 car parking spaces must be identified for the exclusive use of the Office (2,385m²) as required by Condition 3.26.1 and in accordance with the minimum car parking requirements under the Logan Planning Scheme.

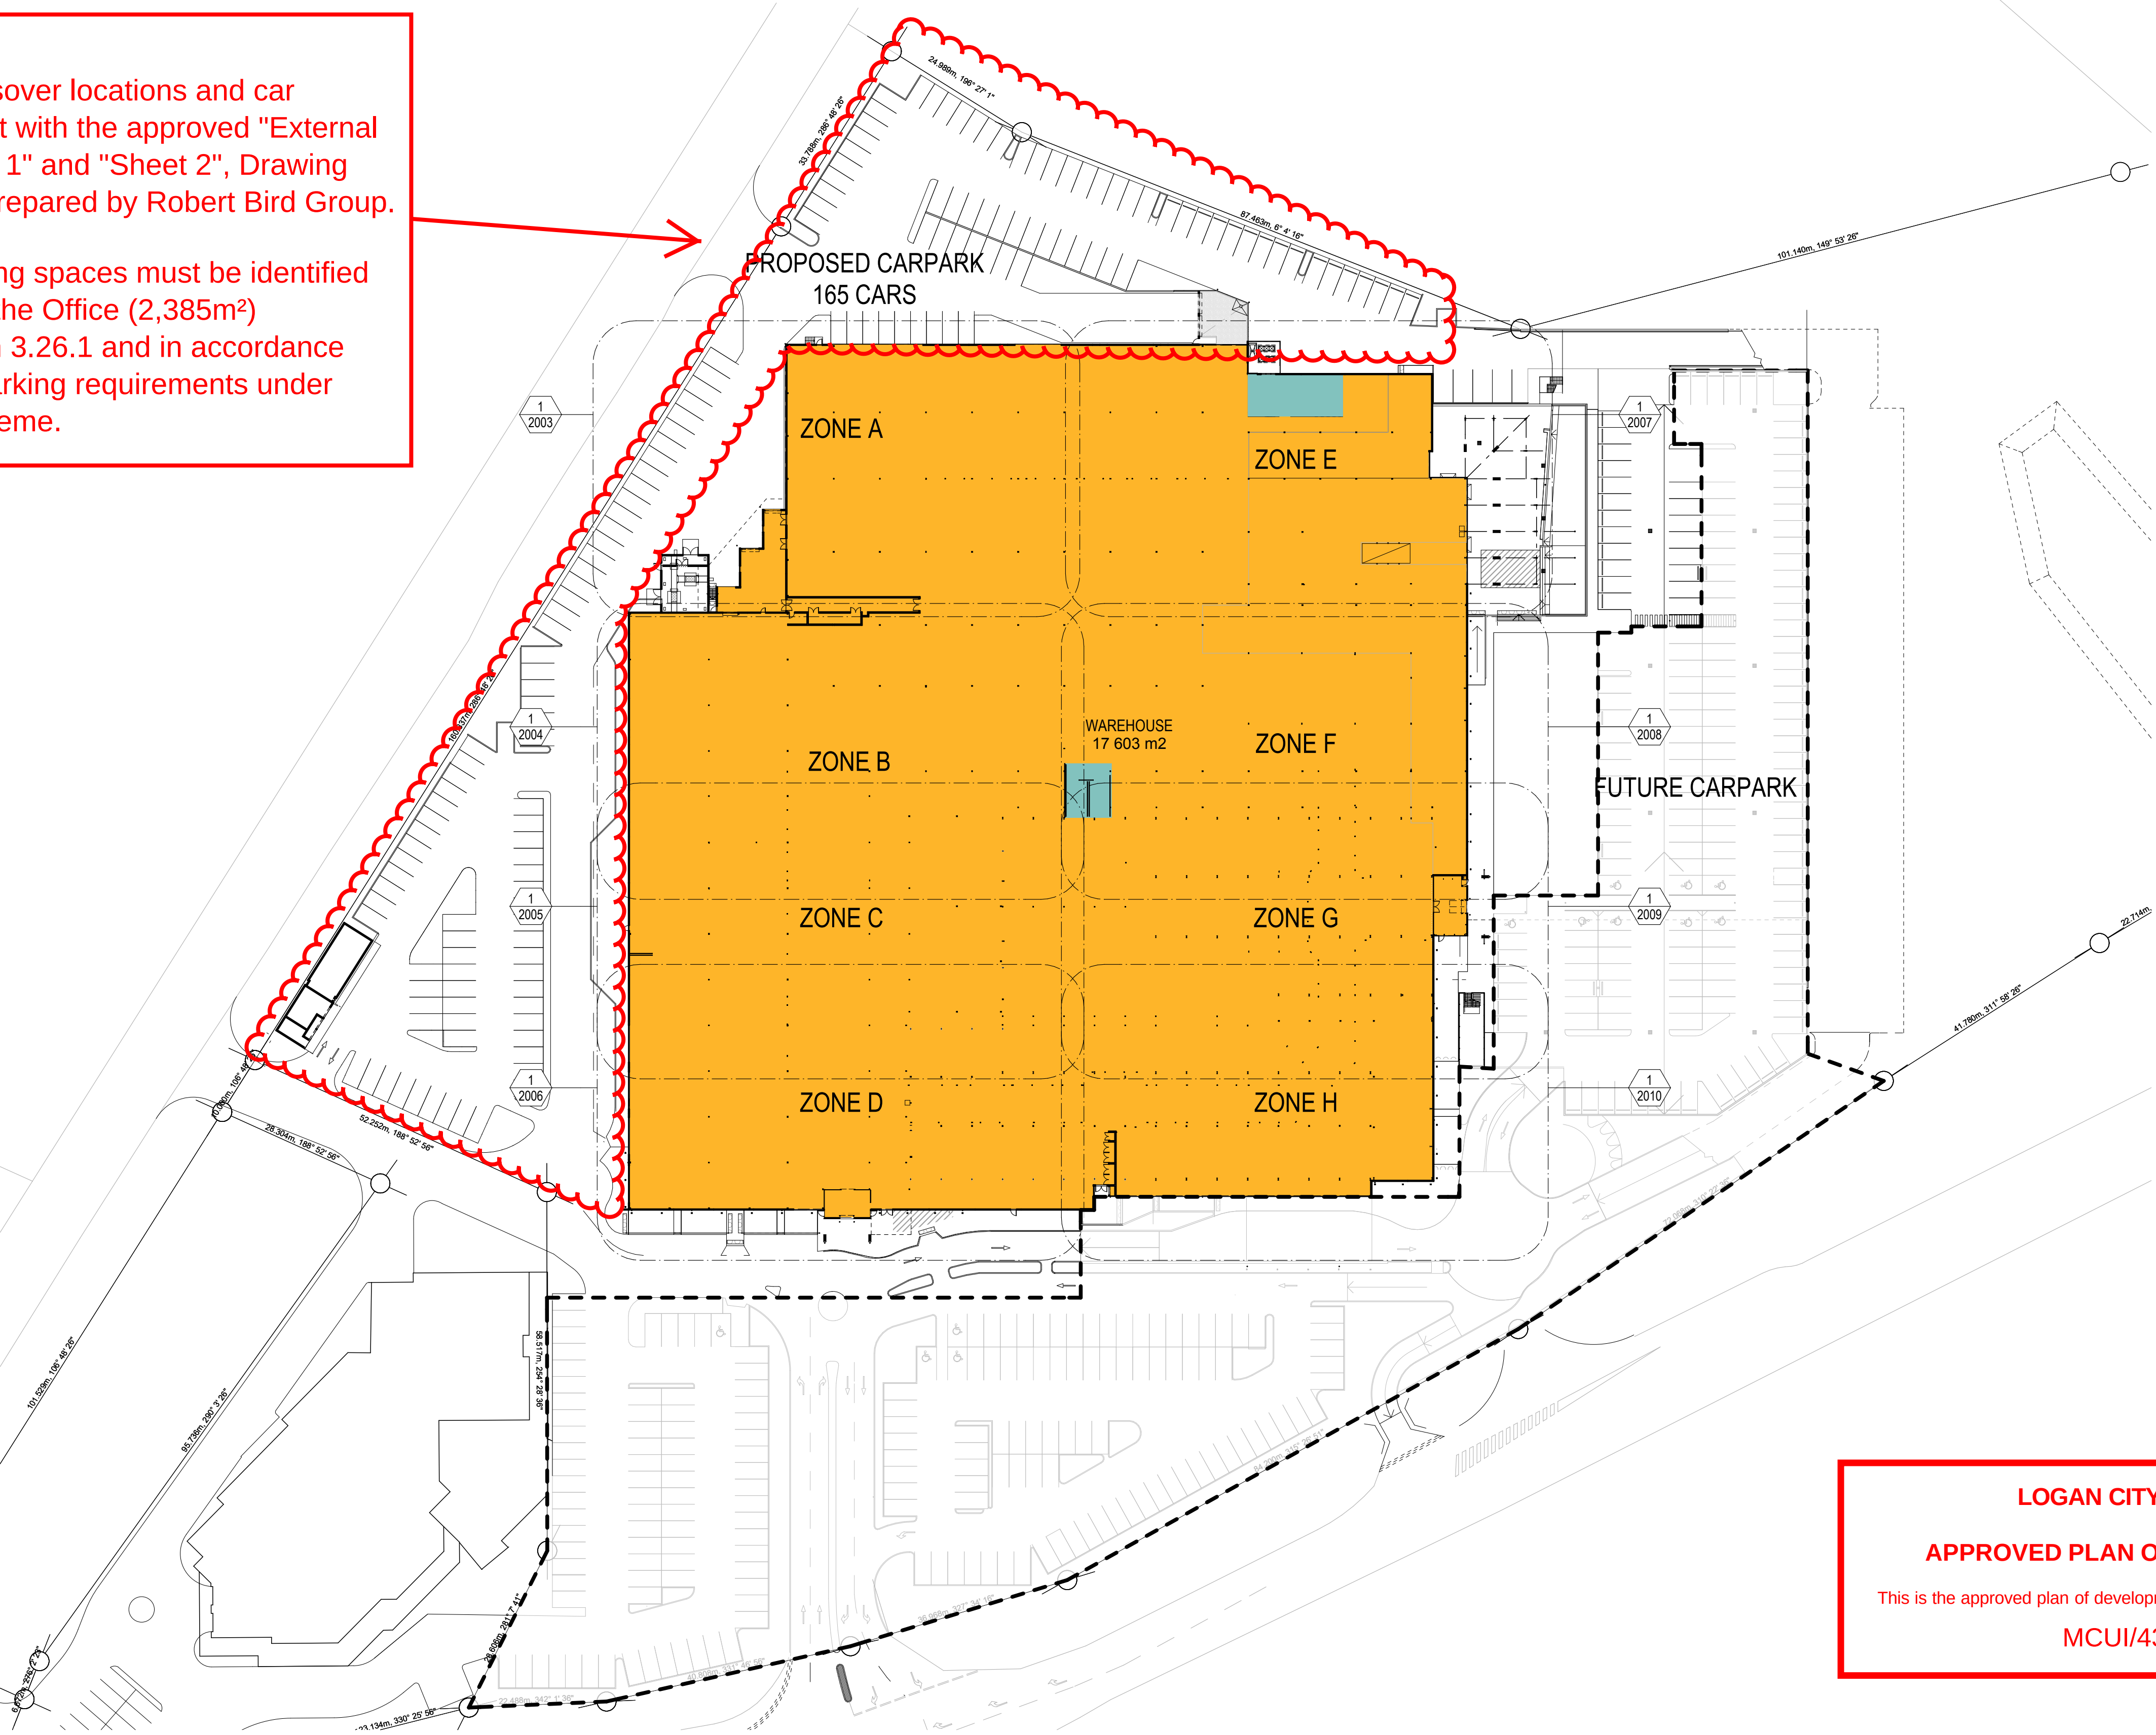

LOGAN CITY COUNCIL

APPROVED PLAN OF DEVELOPMENT

This is the approved plan of development for Development Application


MCUI/43/2016/B

1 SITE PLAN
SCALE 1:625 @ A1
SCALE 1:1250 @ A3

COTTEE PARKER

Brisbane
T 61 7 3846 7422
W coteeparker.com.au
Cottee Parker Architects Pty Ltd
ABN 77 010 924 106
COPYRIGHT COTTEE PARKER ARCHITECTS PTY LTD

TONKEN
PROPERTY GROUP

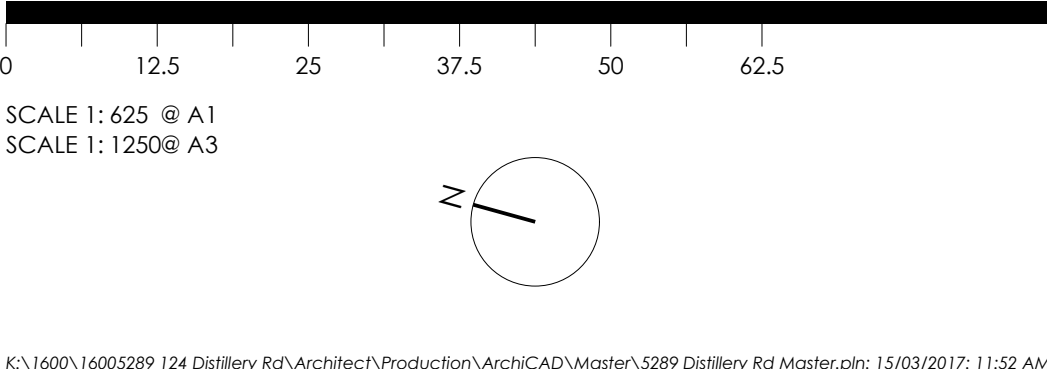

SCHEMATIC DESIGN

C	REVISED DA	15/03/17	CE	BM	BM
B	REVISED DA	10/03/17	CE	BM	BM
A	PRELIMINARY PLAN	28/02/17	CE	BM	BM
ISSUE	PURPOSE	DATE	D	C	A


JOB No 5289

DRAWING No DD1002

ISSUE C

DISTILLERY ROAD
124 DISTILLERY ROAD, BEENLEIGH
CLIENT - TONKEN PROPERTY GROUP

(COUNCIL AMENDMENTS) SITE PLAN

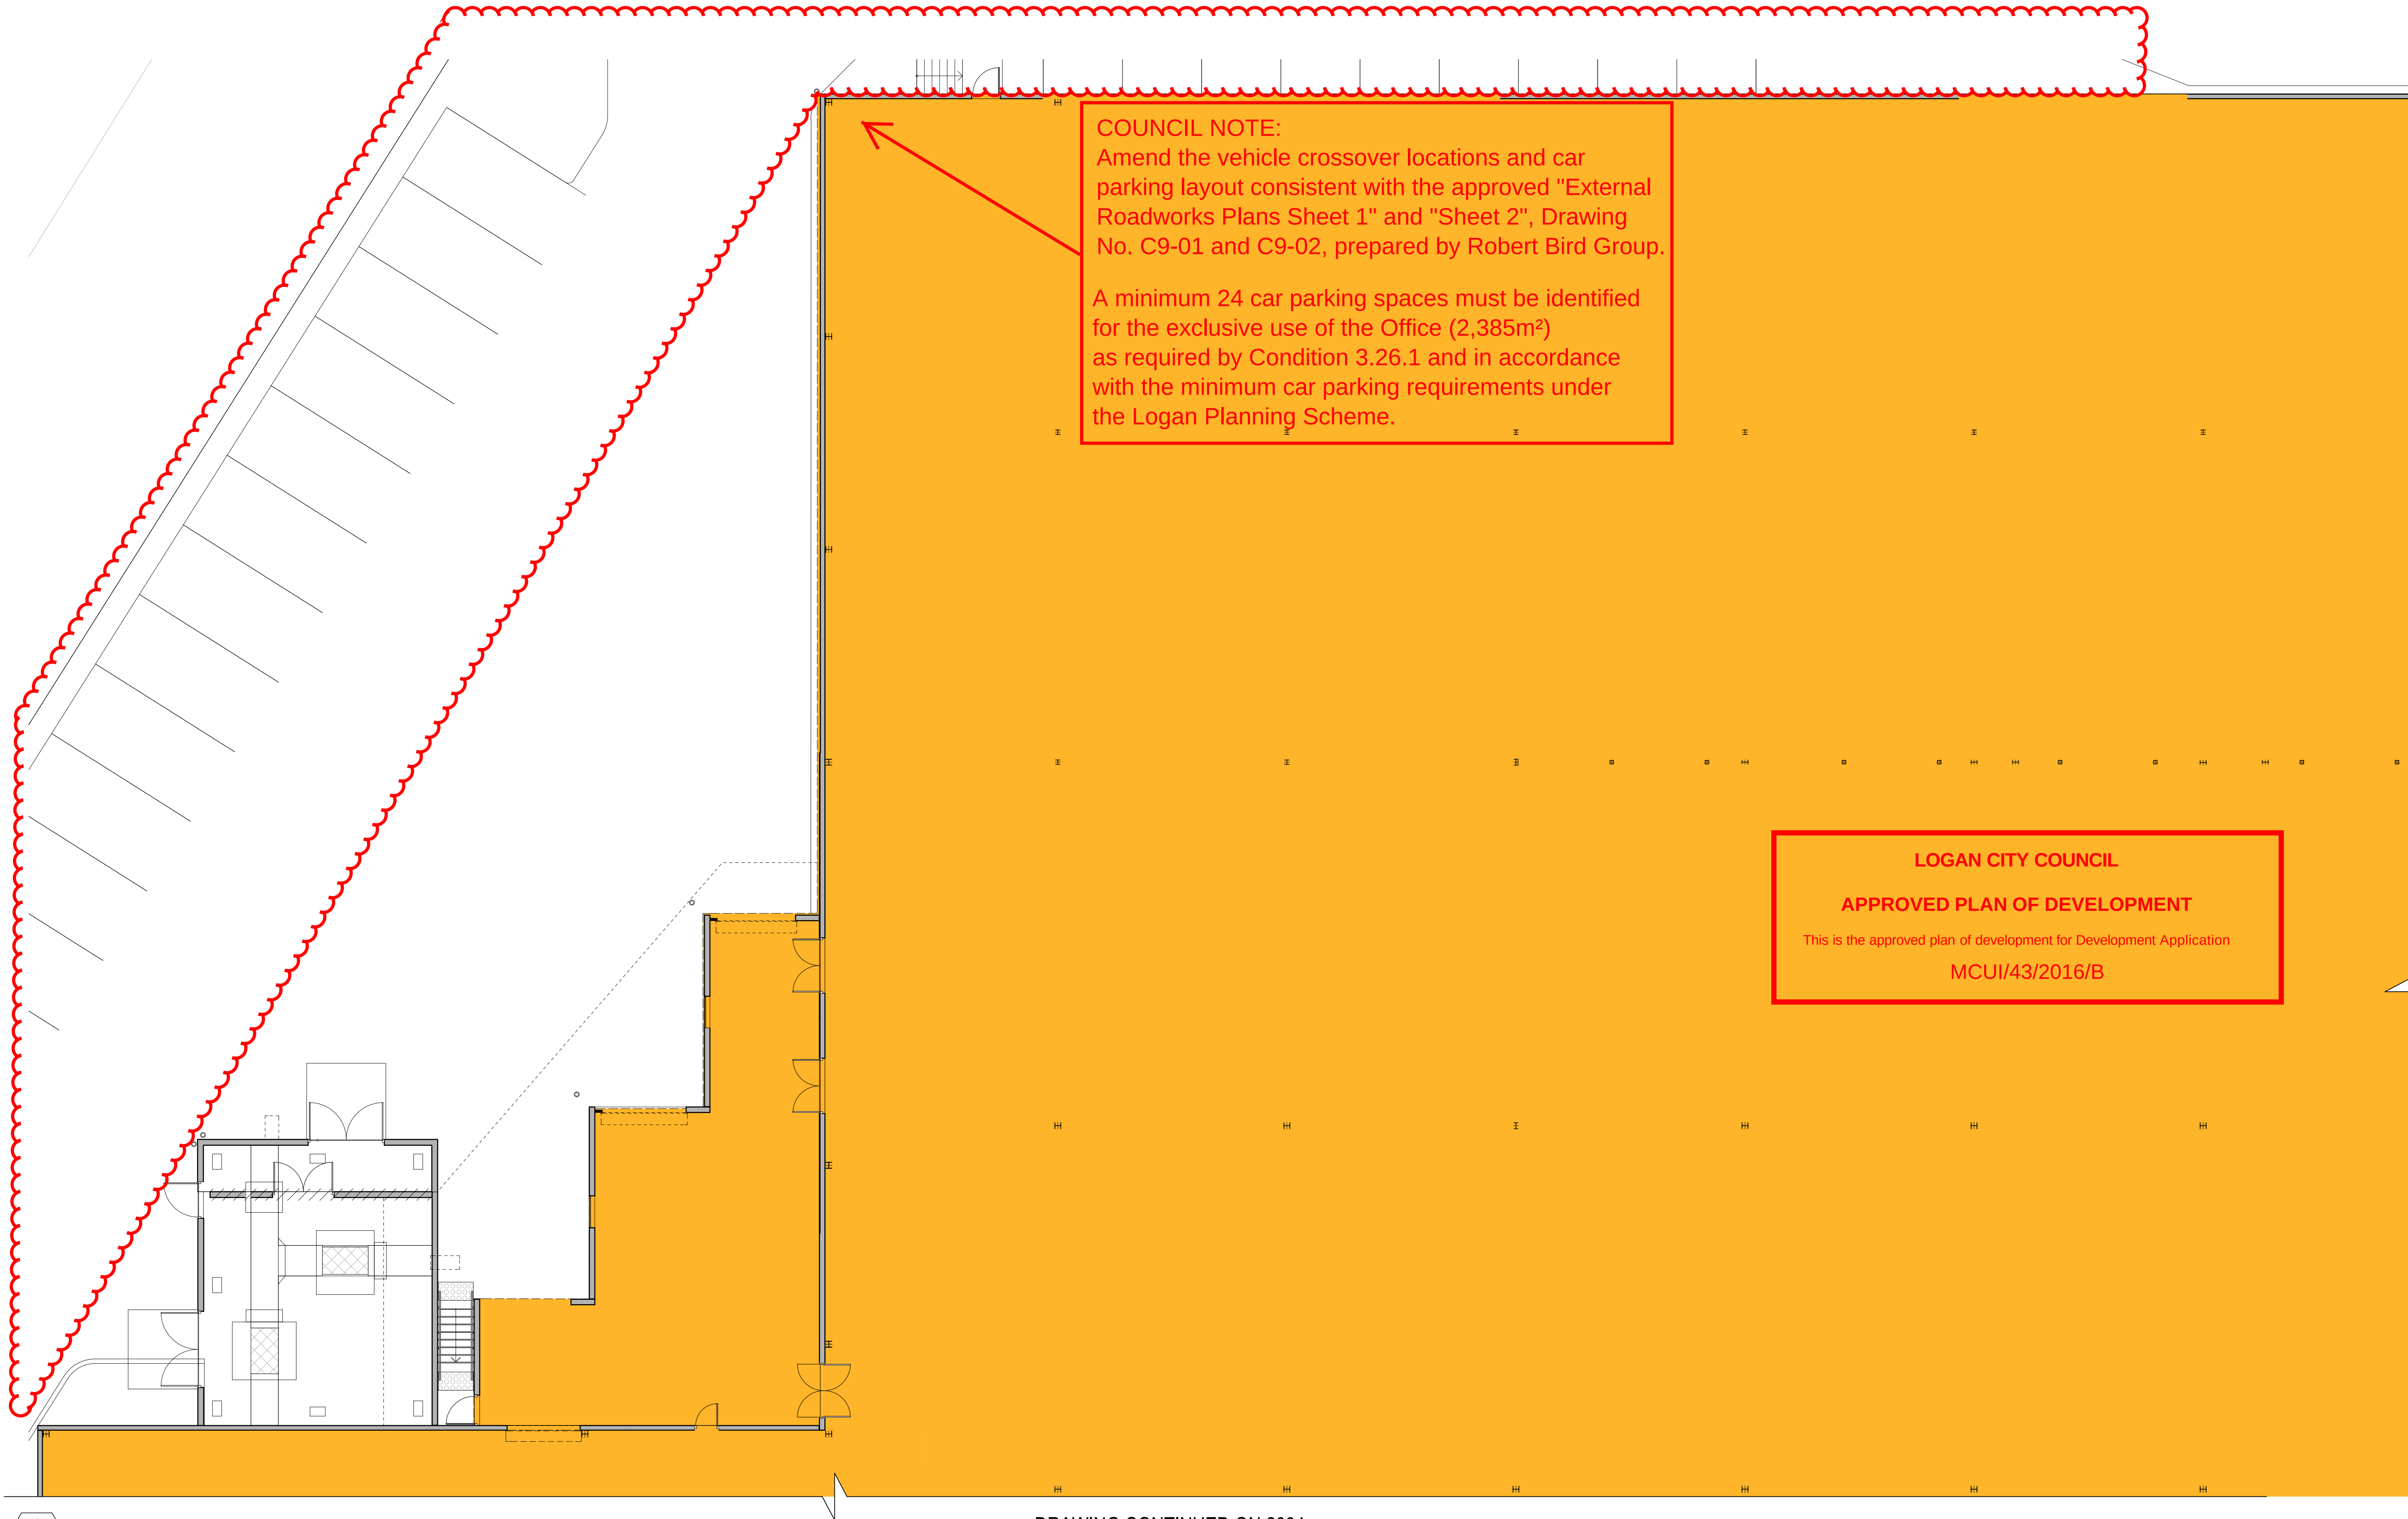

COUNCIL NOTE:
Amend the vehicle crossover locations and car parking layout consistent with the approved "External Roadworks Plans Sheet 1" and "Sheet 2", Drawing No. C9-01 and C9-02, prepared by Robert Bird Group.

A minimum 24 car parking spaces must be identified for the exclusive use of the Office (2,385m²) as required by Condition 3.26.1 and in accordance with the minimum car parking requirements under the Logan Planning Scheme.

LOGAN CITY COUNCIL

APPROVED PLAN OF DEVELOPMENT

This is the approved plan of development for Development Application
MCUI/43/2016/B

1
-
GROUND FLOOR- ZONE A
SCALE 1:100 @ A1
SCALE 1:200 @ A3

DRAWING CONTINUED ON 2004

DRAWING CONTINUED ON 2010

DRAWING CONTINUED ON 2003



DRAWING CONTINUED ON 2009

1 GROUND FLOOR- ZONE B
SCALE 1:100 @ A1
SCALE 1:200 @ A3

DRAWING CONTINUED ON 2005

COTTEE PARKER

Brisbane
T 61 7 3846 7422
W cotteeparker.com.au
Cottee Parker Architects Pty Ltd
ABN 77 010 924 106
COPYRIGHT COTTEE PARKER ARCHITECTS PTY LTD

TONKEN

PROPERTY GROUP

012345678910

SCALE 1: 100 @ A1
SCALE 1: 200 @ A3

N

K:\1600\16005289 124 Distillery Rd\Architect\Production\Arch\CAD\Master\5289 Distillery Rd Master.pln: 15/03/2017: 11:52 AM

SCHEMATIC DESIGN

A

REVISED DA

ISSUE PURPOSE

15/03/17

DATE

CE

BM

BM

D

C

A

JOB No

5289

DRAWING No

DD2004

ISSUE

A

DISTILLERY ROAD

124 DISTILLERY ROAD, BEENLEIGH
CLIENT - TONKEN PROPERTY GROUP

DRAWING TITLE

FLOOR PLAN - ZONE B

DRAWING CONTINUED ON 2004

LOGAN CITY COUNCIL
APPROVED PLAN OF DEVELOPMENT
This is the approved plan of development for Development Application
MCUI/43/2016/B

DRAWING CONTINUED ON 2008

DRAWING CONTINUED ON 2006

1
-
GROUND FLOOR- ZONE C
SCALE 1:100 @ A1
SCALE 1:200 @ A3

COTTEE PARKER

Brisbane
T 61 7 3846 7422
W cotteeparker.com.au
Cottee Parker Architects Pty Ltd
ABN 77 010 924 106
COPYRIGHT COTTEE PARKER ARCHITECTS PTY LTD

TONKEN

PROPERTY GROUP

012345678910

SCALE 1: 100 @ A1
SCALE 1: 200 @ A3

N

K:\1600\16005289 124 Distillery Rd\Architect\Production\Arch\CAD\Master\5289 Distillery Rd Master.pln: 15/03/2017: 11:52 AM

SCHEMATIC DESIGN

B	REVISED DA	15/03/17	CE	BM	BM
A	REVISED DA	10/03/17	CE	BM	BM
ISSUE PURPOSE	DATE	D.	C.	A.	

JOB No
5289

DRAWING No
DD2005

ISSUE
B

DISTILLERY ROAD
124 DISTILLERY ROAD, BEENLEIGH
CLIENT - TONKEN PROPERTY GROUP
DRAWING TITLE
FLOOR PLAN - ZONE C

LOGAN CITY COUNCIL
APPROVED PLAN OF DEVELOPMENT
This is the approved plan of development for Development Application
MCUI/43/2016/B

DRAWING CONTINUED ON 2007


1 GROUND FLOOR- ZONE D
SCALE 1:100 @ A1
SCALE 1:200 @ A3

COTTEE PARKER


Brisbane
T 61 7 3846 7422
W cotteeparker.com.au
Cottee Parker Architects Pty Ltd
ABN 77 010 924 106
COPYRIGHT COTTEE PARKER ARCHITECTS PTY LTD

TONKEN
PROPERTY GROUP

0 1 2 3 4 5 6 7 8 9 10
SCALE 1: 100 @ A1
SCALE 1: 200 @ A3

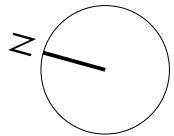


K:\1600\16005289 124 Distillery Rd\Architect\Production\Arch\CAD\Master\5289 Distillery Rd Master.pln: 15/03/2017: 11:52 AM

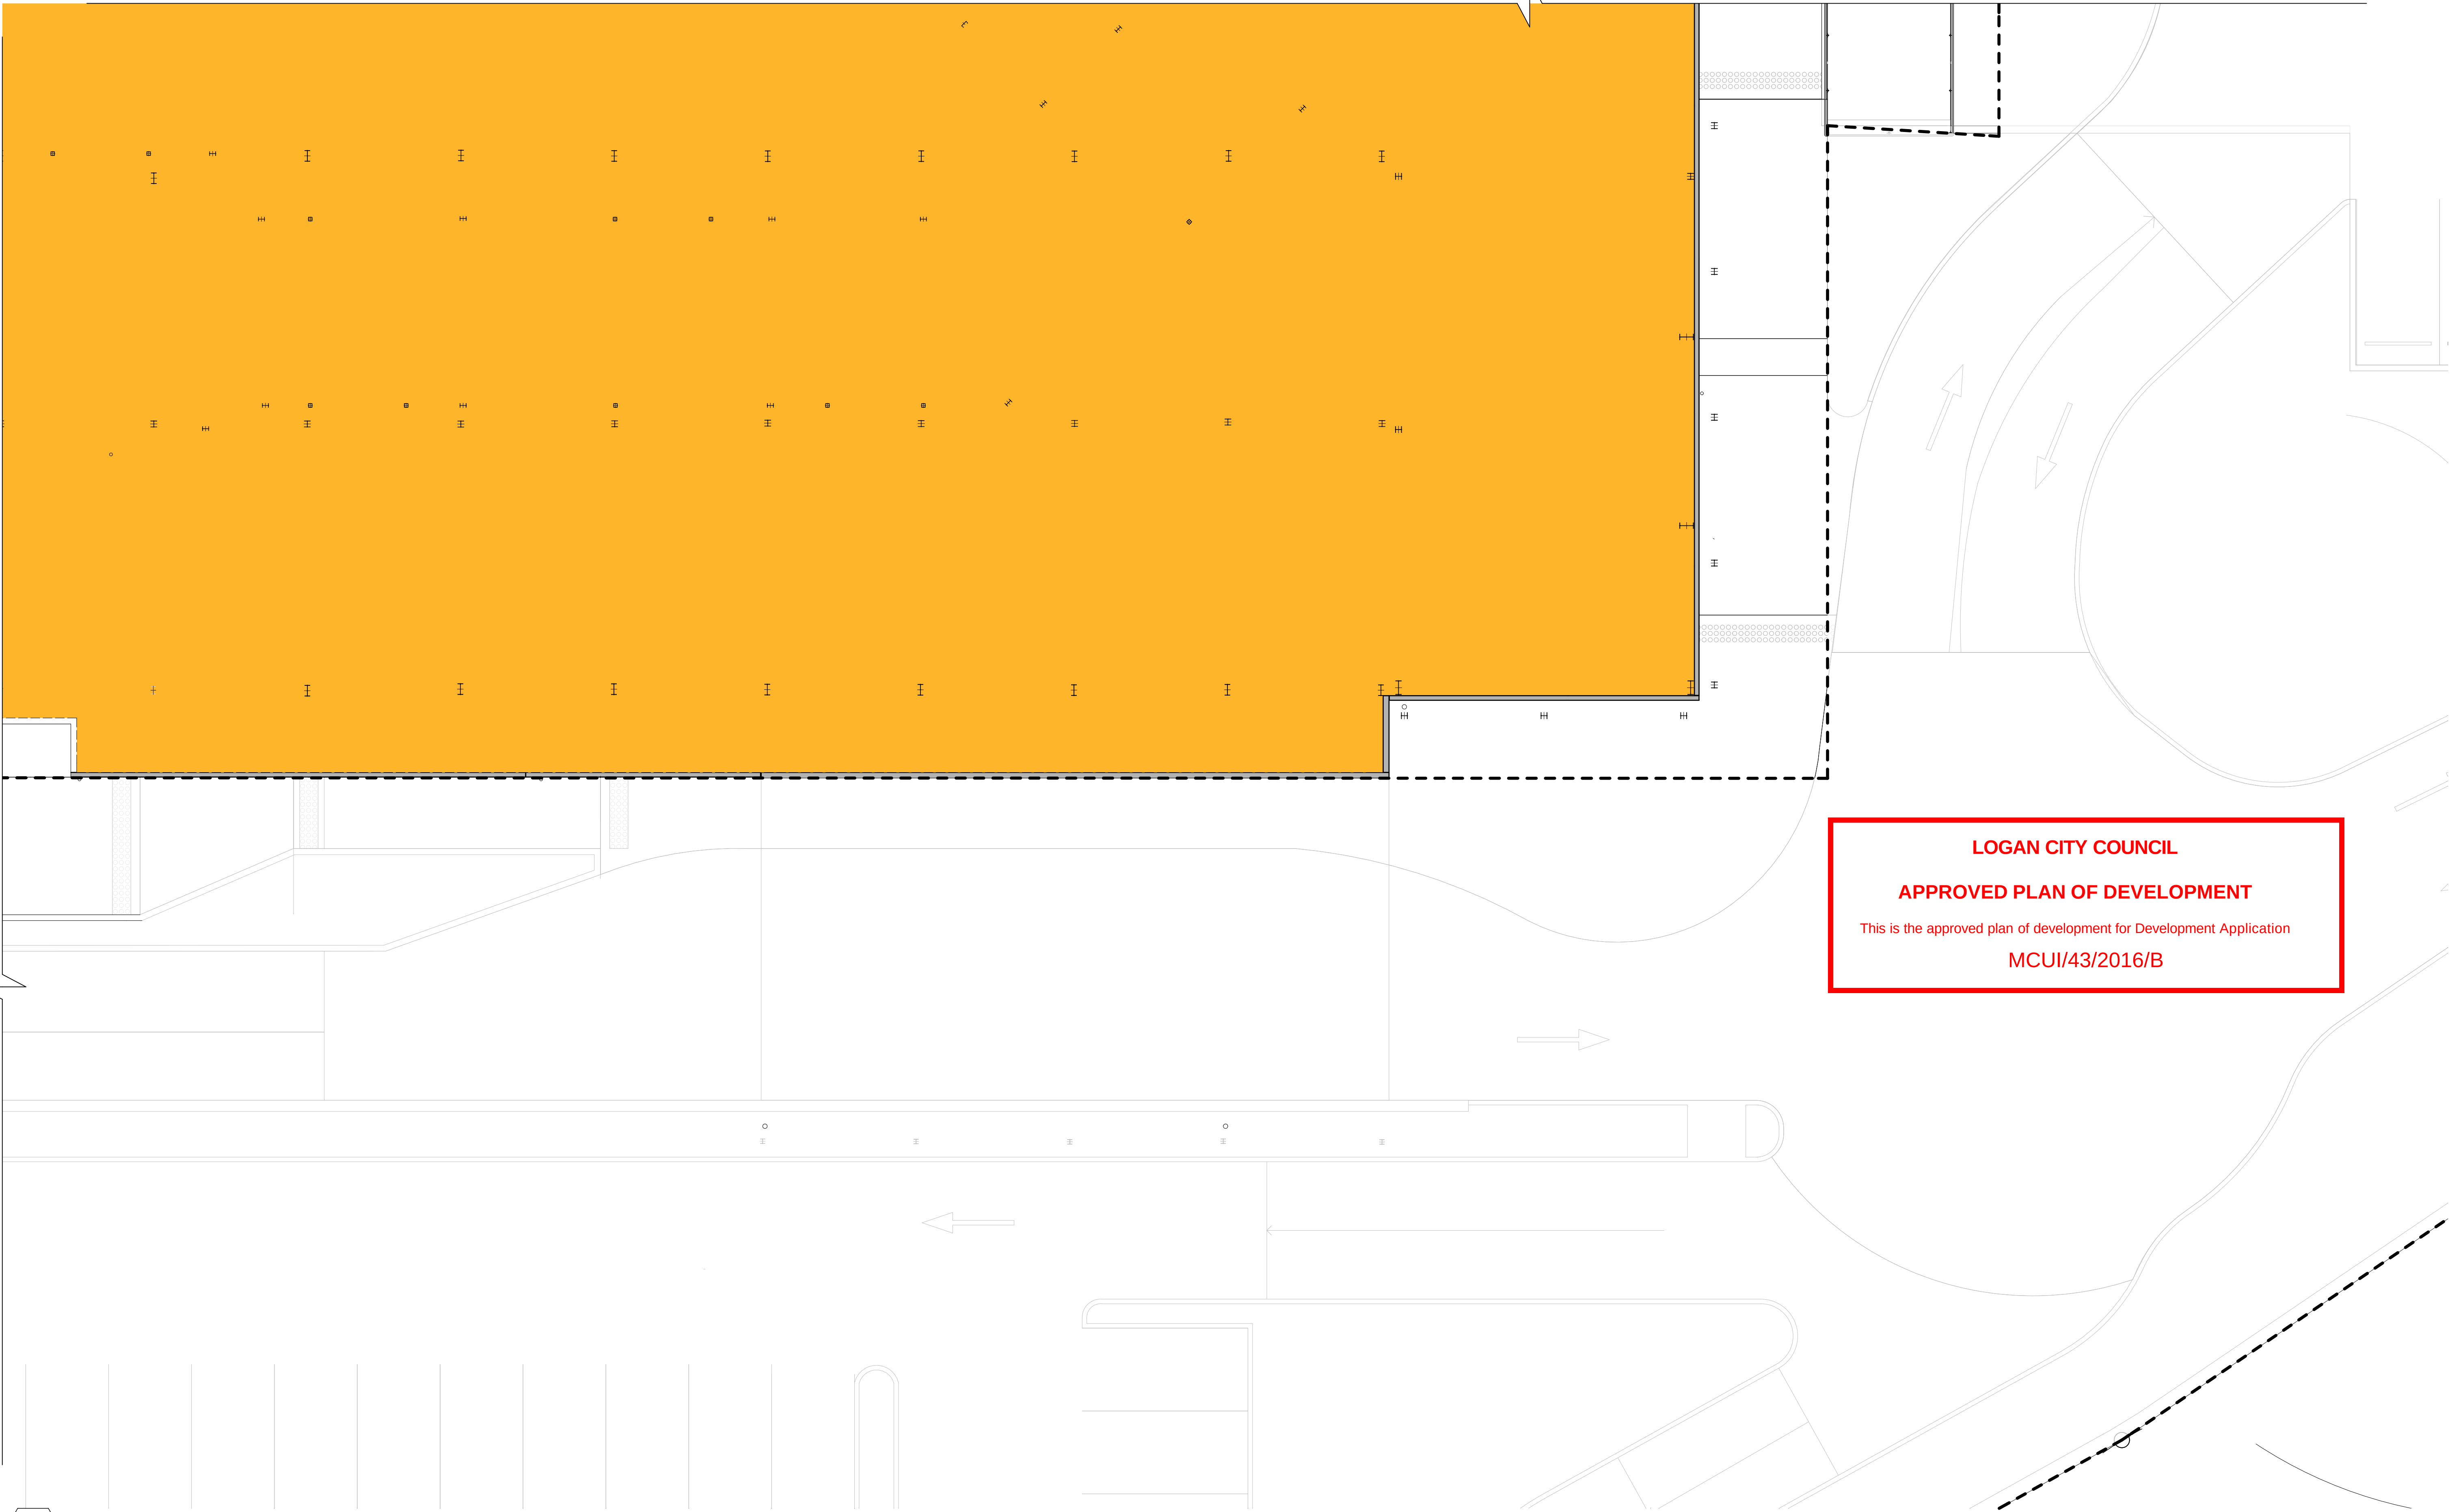

1 GROUND FLOOR- ZONE E
SCALE 1:100 @ A1
SCALE 1:200 @ A3

DRAWING CONTINUED ON 2005

DRAWING CONTINUED ON 2009

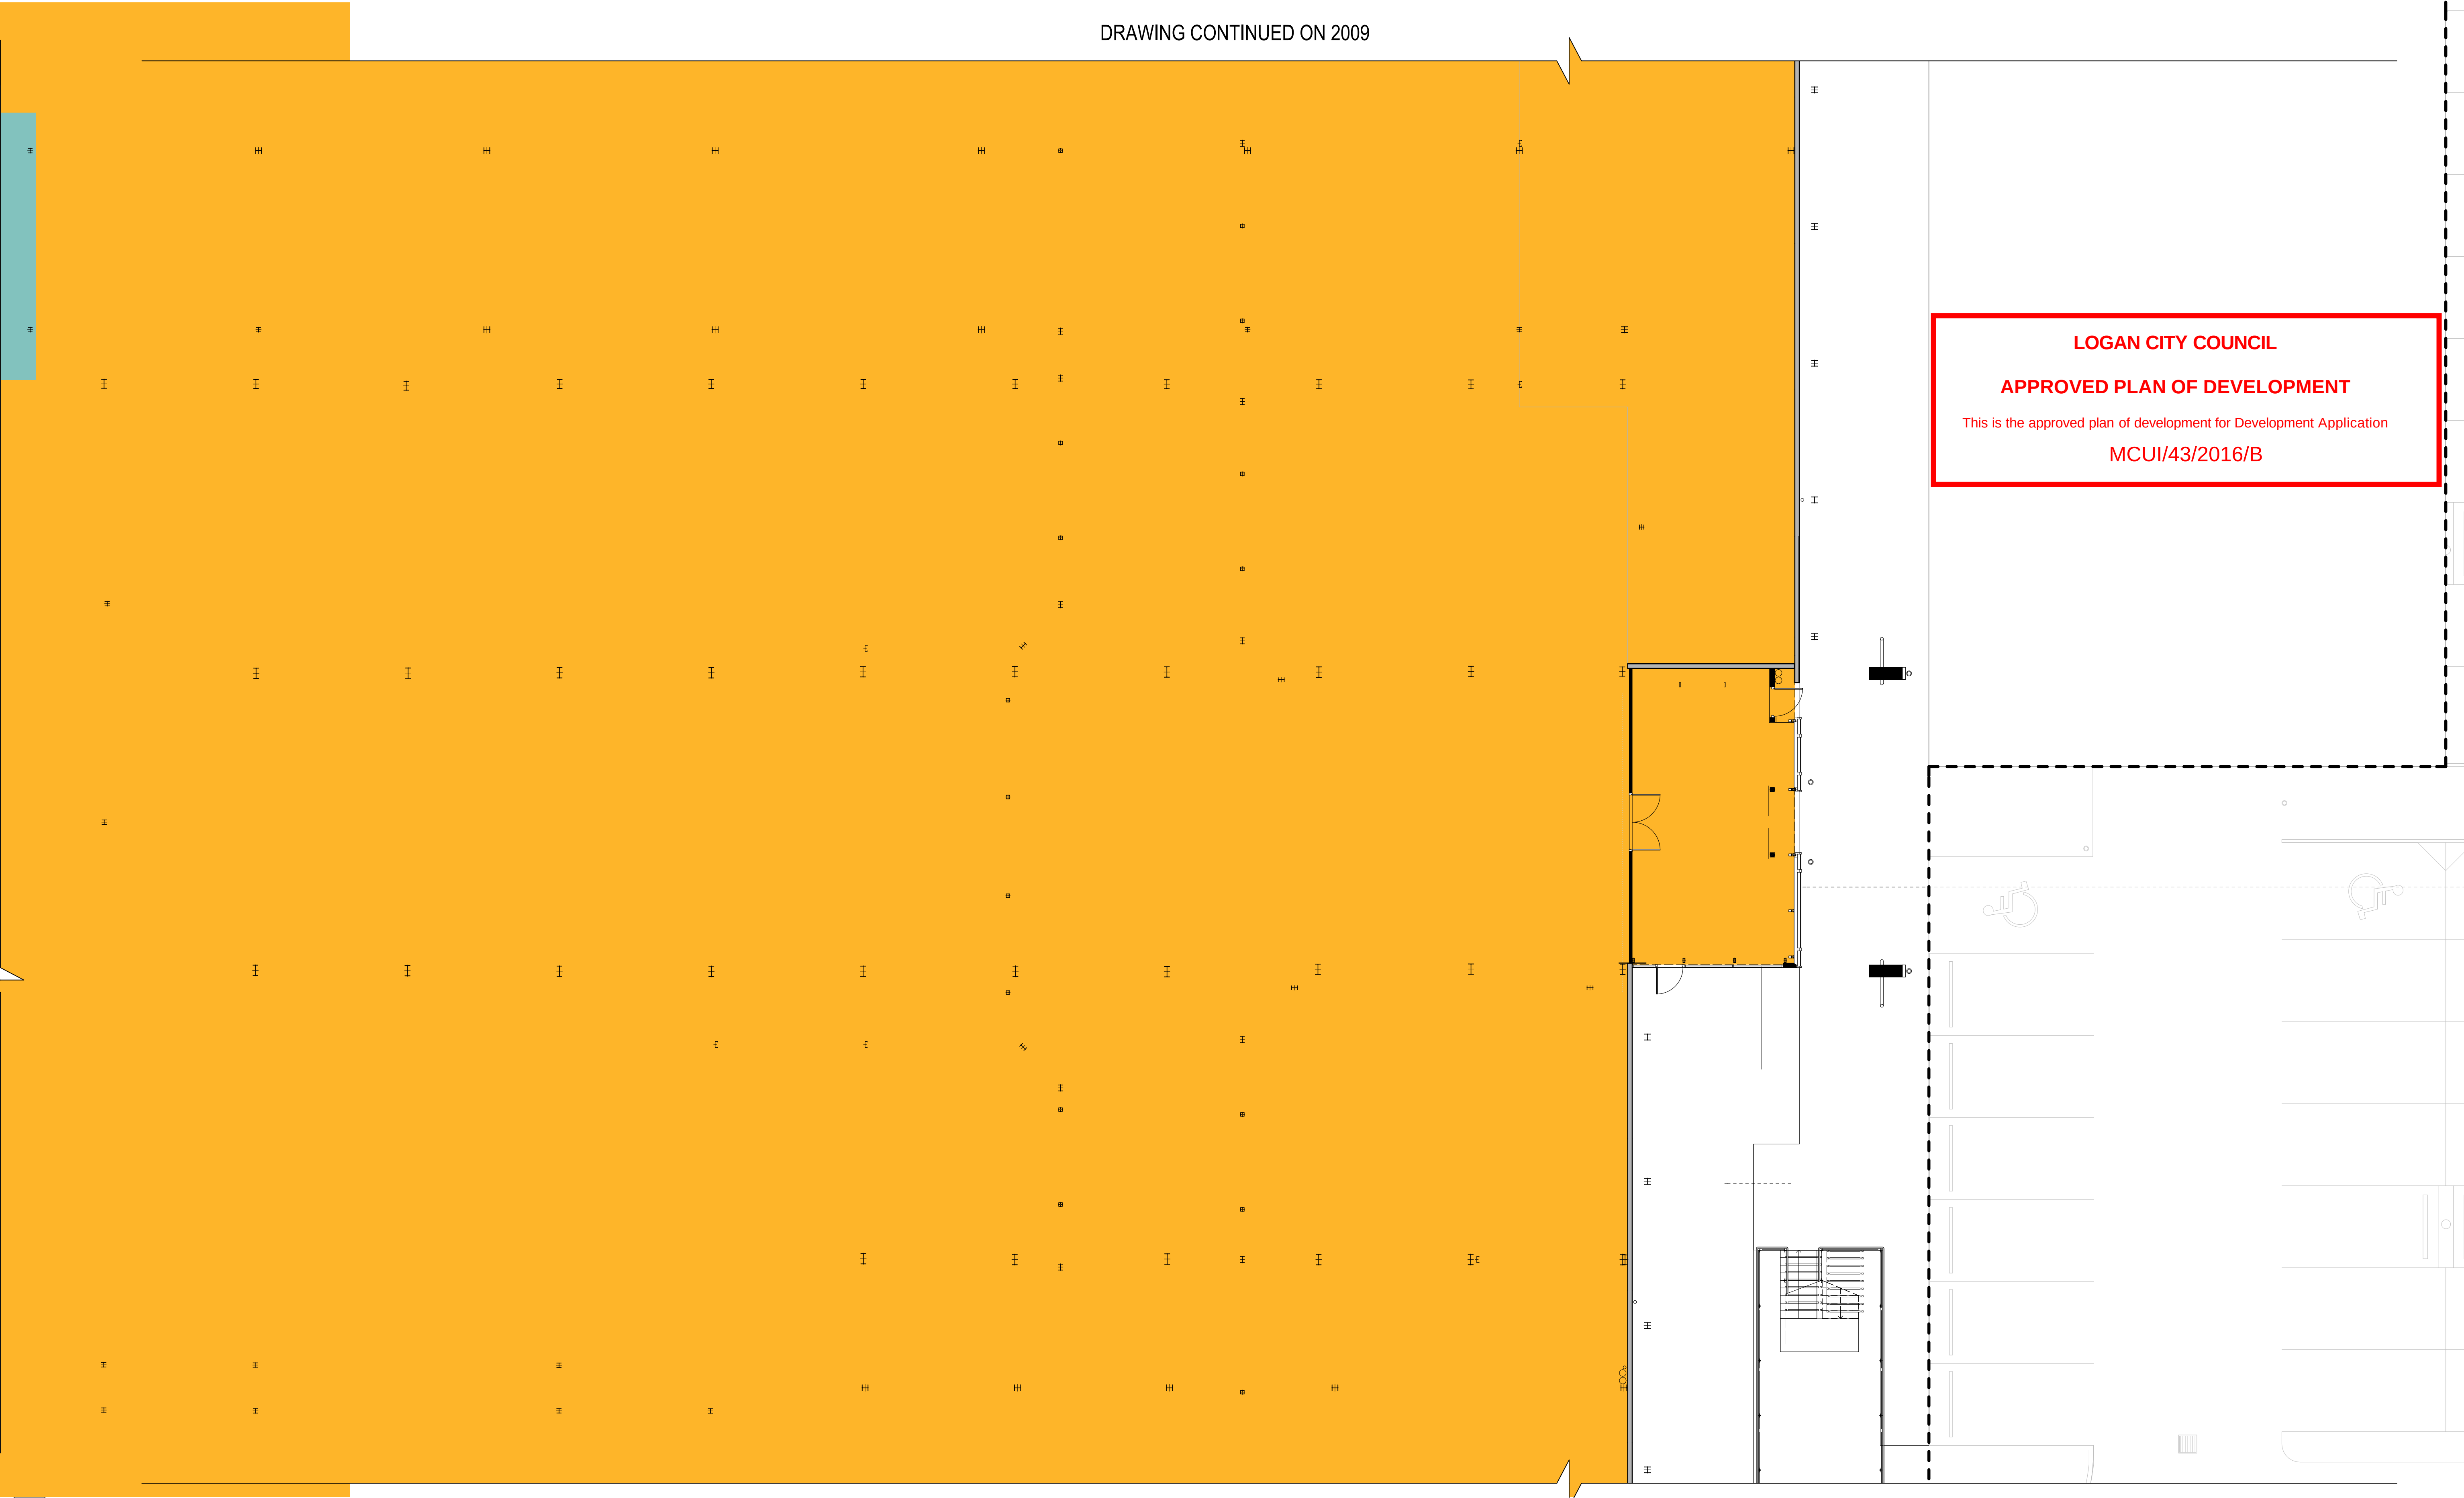


1 GROUND FLOOR- ZONE F
SCALE 1:100 @ A1
SCALE 1:200 @ A3

DRAWING CONTINUED ON 2007

DRAWING CONTINUED ON 2010

DRAWING CONTINUED ON 2004

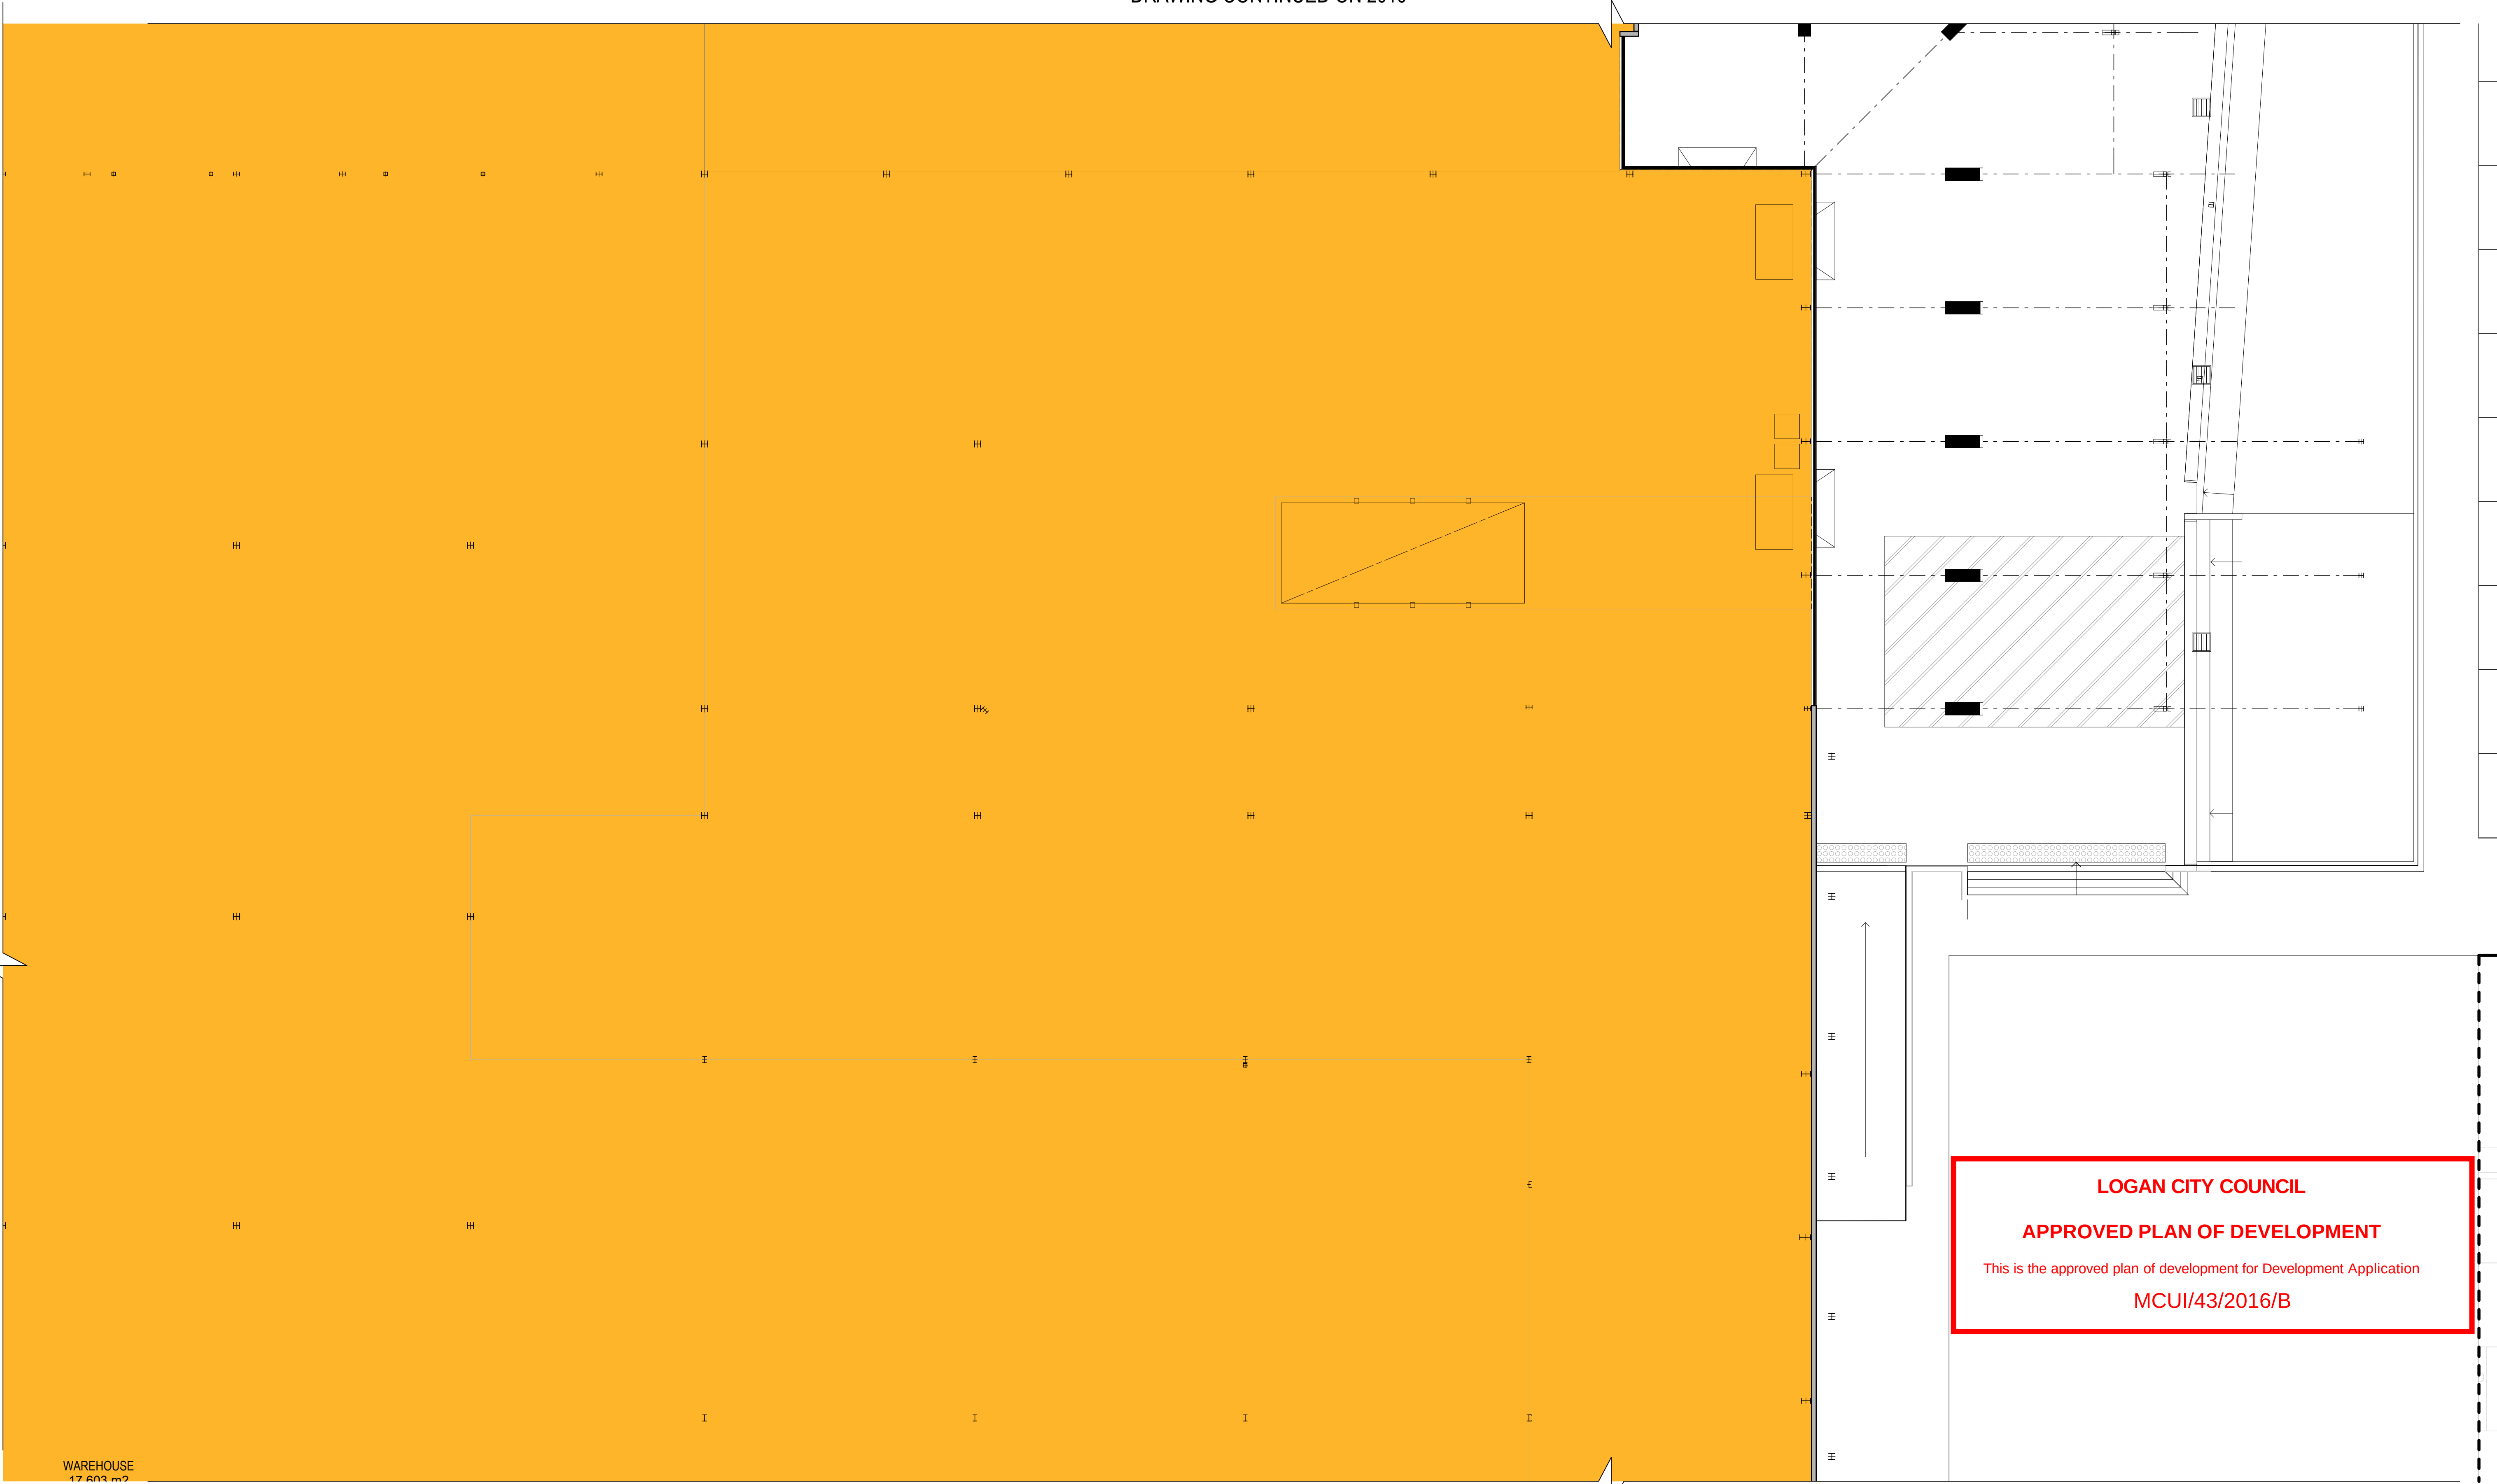

DRAWING CONTINUED ON 2008


1
-
GROUND FLOOR- ZONE G
SCALE 1:100 @ A1
SCALE 1:200 @ A3

COTTEE PARKER
Brisbane
T 61 7 3846 7422
W coteeparker.com.au
Cottee Parker Architects Pty Ltd
ABN 77 010 924 106
COPYRIGHT COTTEE PARKER ARCHITECTS PTY LTD

TONKEN
PROPERTY GROUP

0 1 2 3 4 5 6 7 8 9 10
SCALE 1:100 @ A1
SCALE 1:200 @ A3
N
K:\1600\16005289 124 Distillery Rd\Architect\Production\ArchCAD\Master\5289 Distillery Rd Master.pln: 15/03/2017: 11:52 AM

SCHEMATIC DESIGN
B REVISED DA 15/03/17 CE BM BM
A REVISED DA 10/03/17 CE BM BM
ISSUE PURPOSE DATE D. C. A.
JOB No 5289
DRAWING No DD2009
DRAWING TITLE FLOOR PLANS- ZONE G
CLIENT - TONKEN PROPERTY GROUP
124 DISTILLERY ROAD, BEENLEIGH
DISTILLERY ROAD
ISSUE B

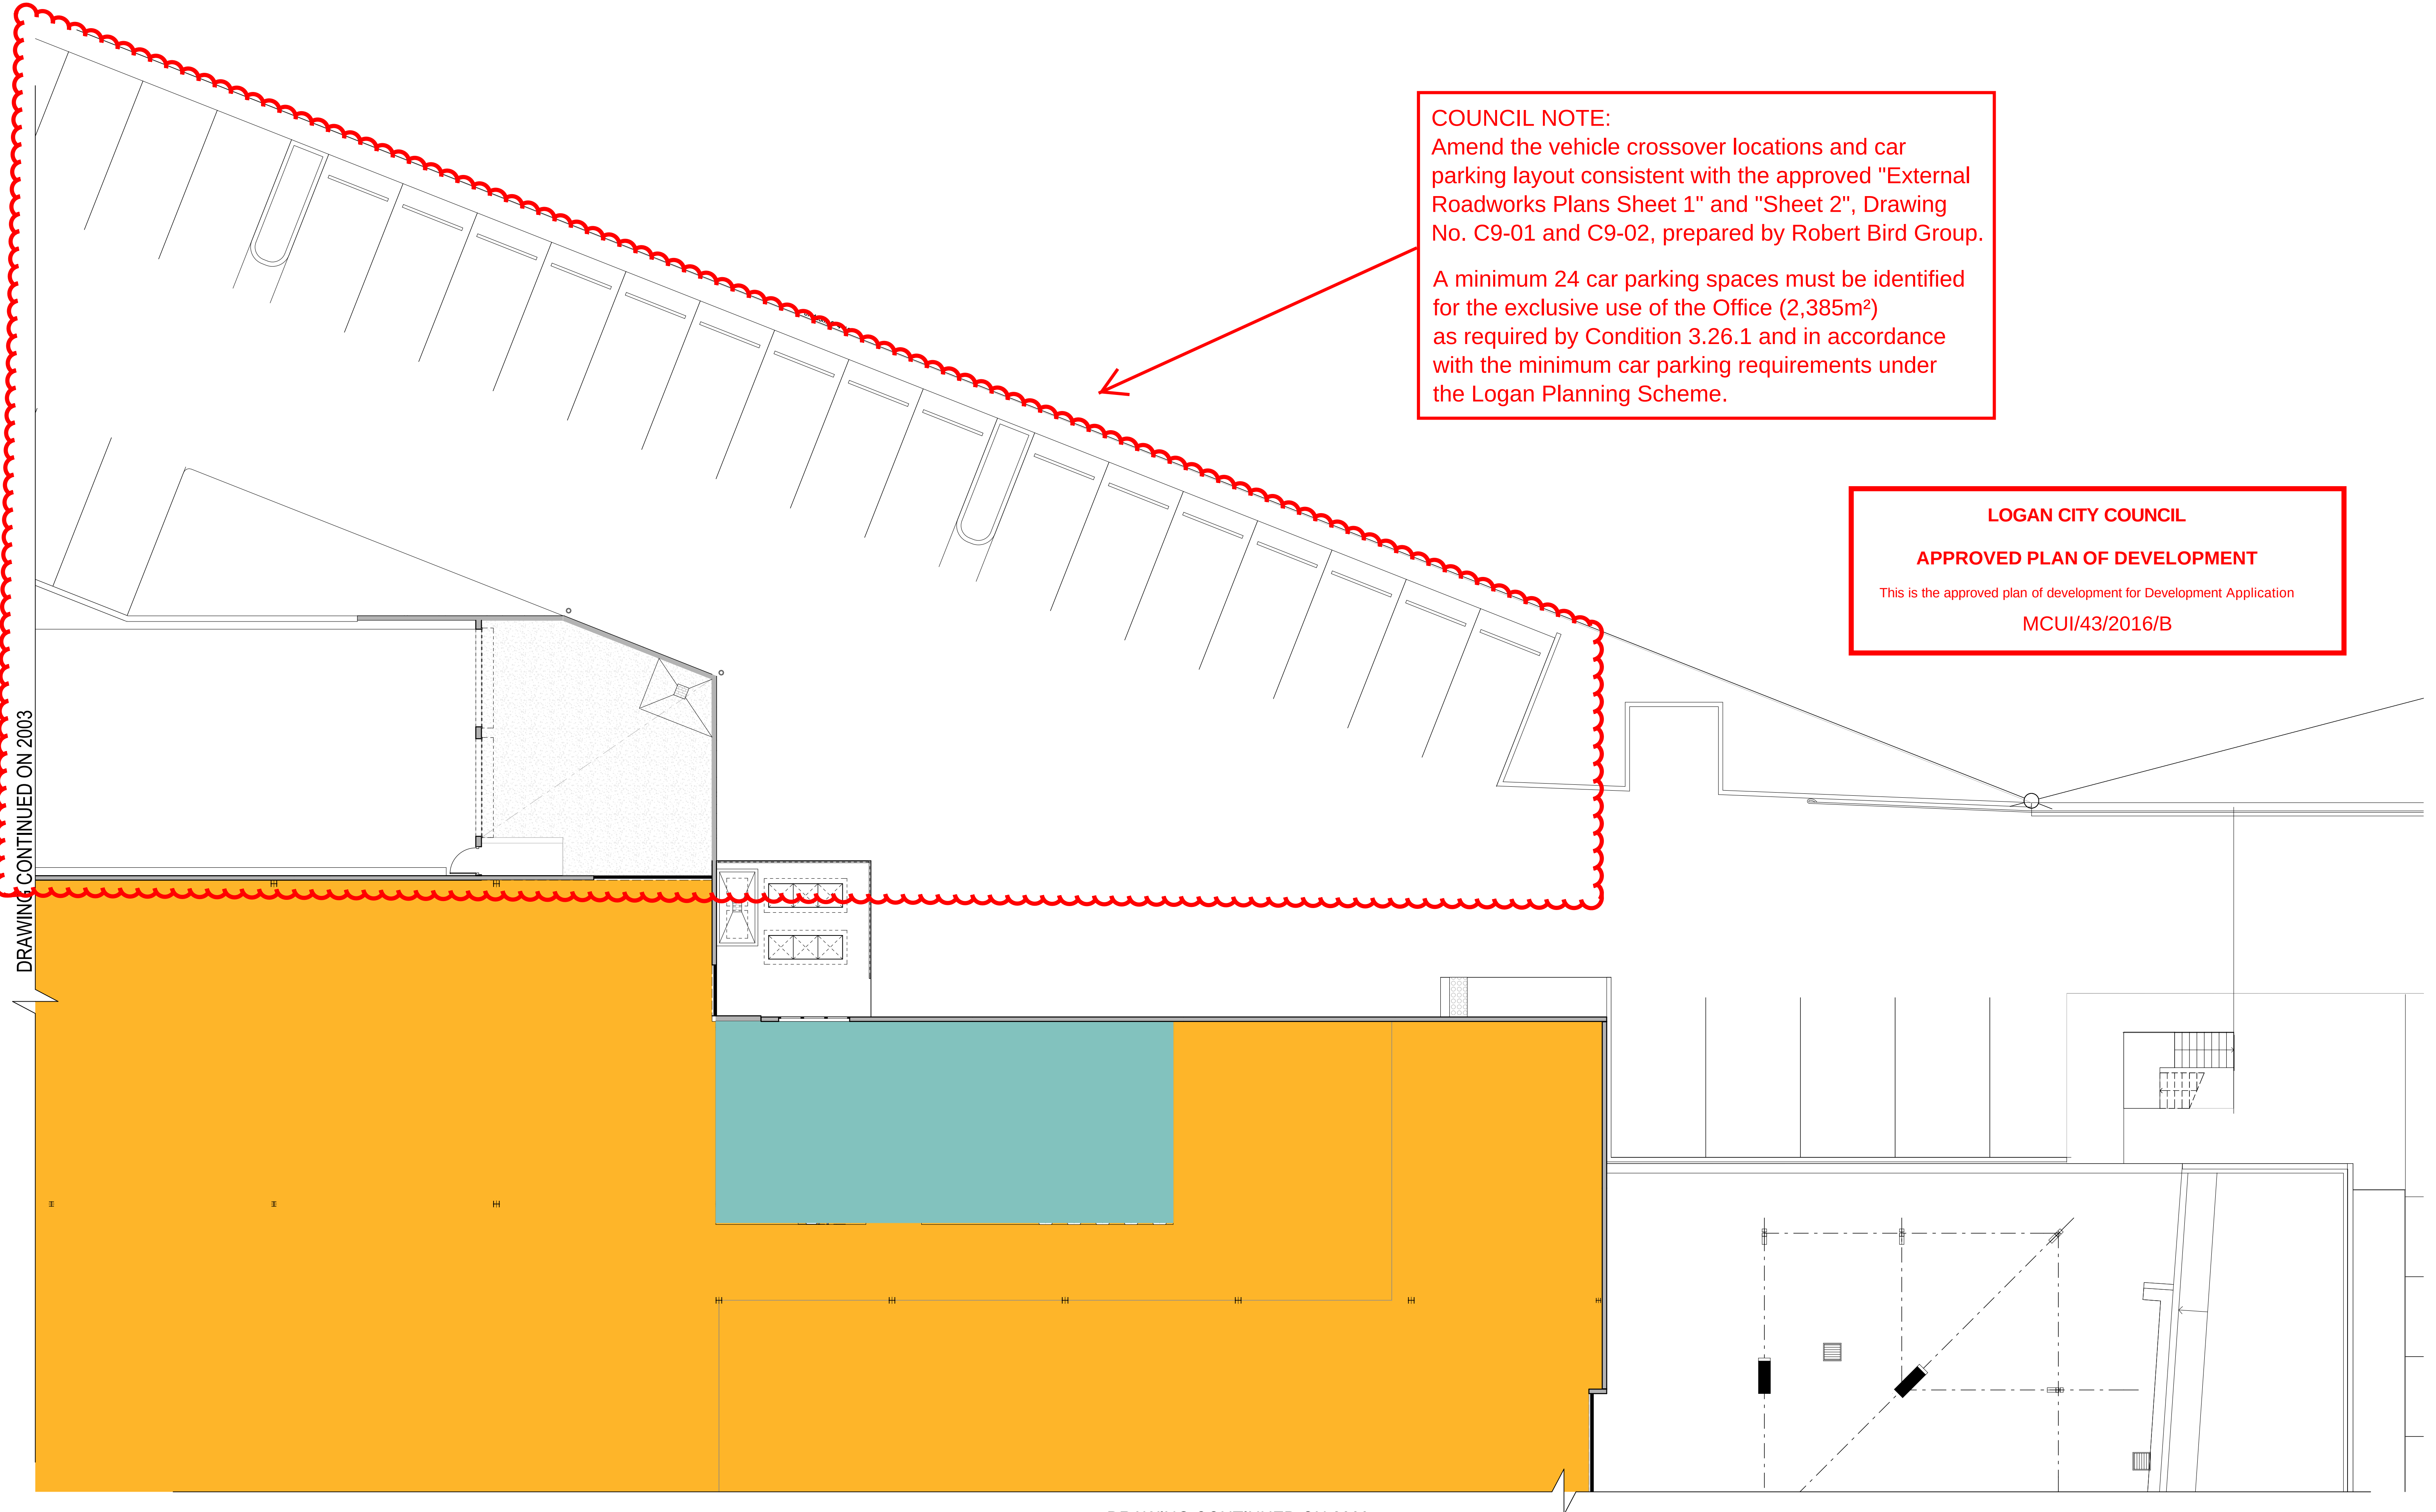

COUNCIL NOTE:
Amend the vehicle crossover locations and car parking layout consistent with the approved "External Roadworks Plans Sheet 1" and "Sheet 2", Drawing No. C9-01 and C9-02, prepared by Robert Bird Group.

A minimum 24 car parking spaces must be identified for the exclusive use of the Office (2,385m²) as required by Condition 3.26.1 and in accordance with the minimum car parking requirements under the Logan Planning Scheme.

LOGAN CITY COUNCIL

APPROVED PLAN OF DEVELOPMENT

This is the approved plan of development for Development Application
MCUI/43/2016/B

DRAWING CONTINUED ON 2003


DRAWING CONTINUED ON 2009


1 **GROUND FLOOR- ZONE H**
SCALE 1:100 @ A1
SCALE 1:200 @ A3

COTTEE PARKER

Brisbane
T 61 7 3846 7422
W coteeparker.com.au
Cottee Parker Architects Pty Ltd
ABN 77 010 924 106
COPYRIGHT COTTEE PARKER ARCHITECTS PTY LTD

TONKEN
PROPERTY GROUP

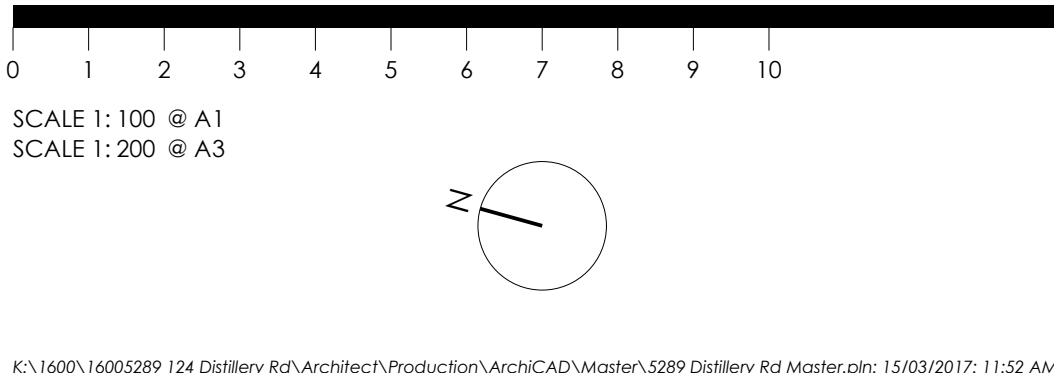

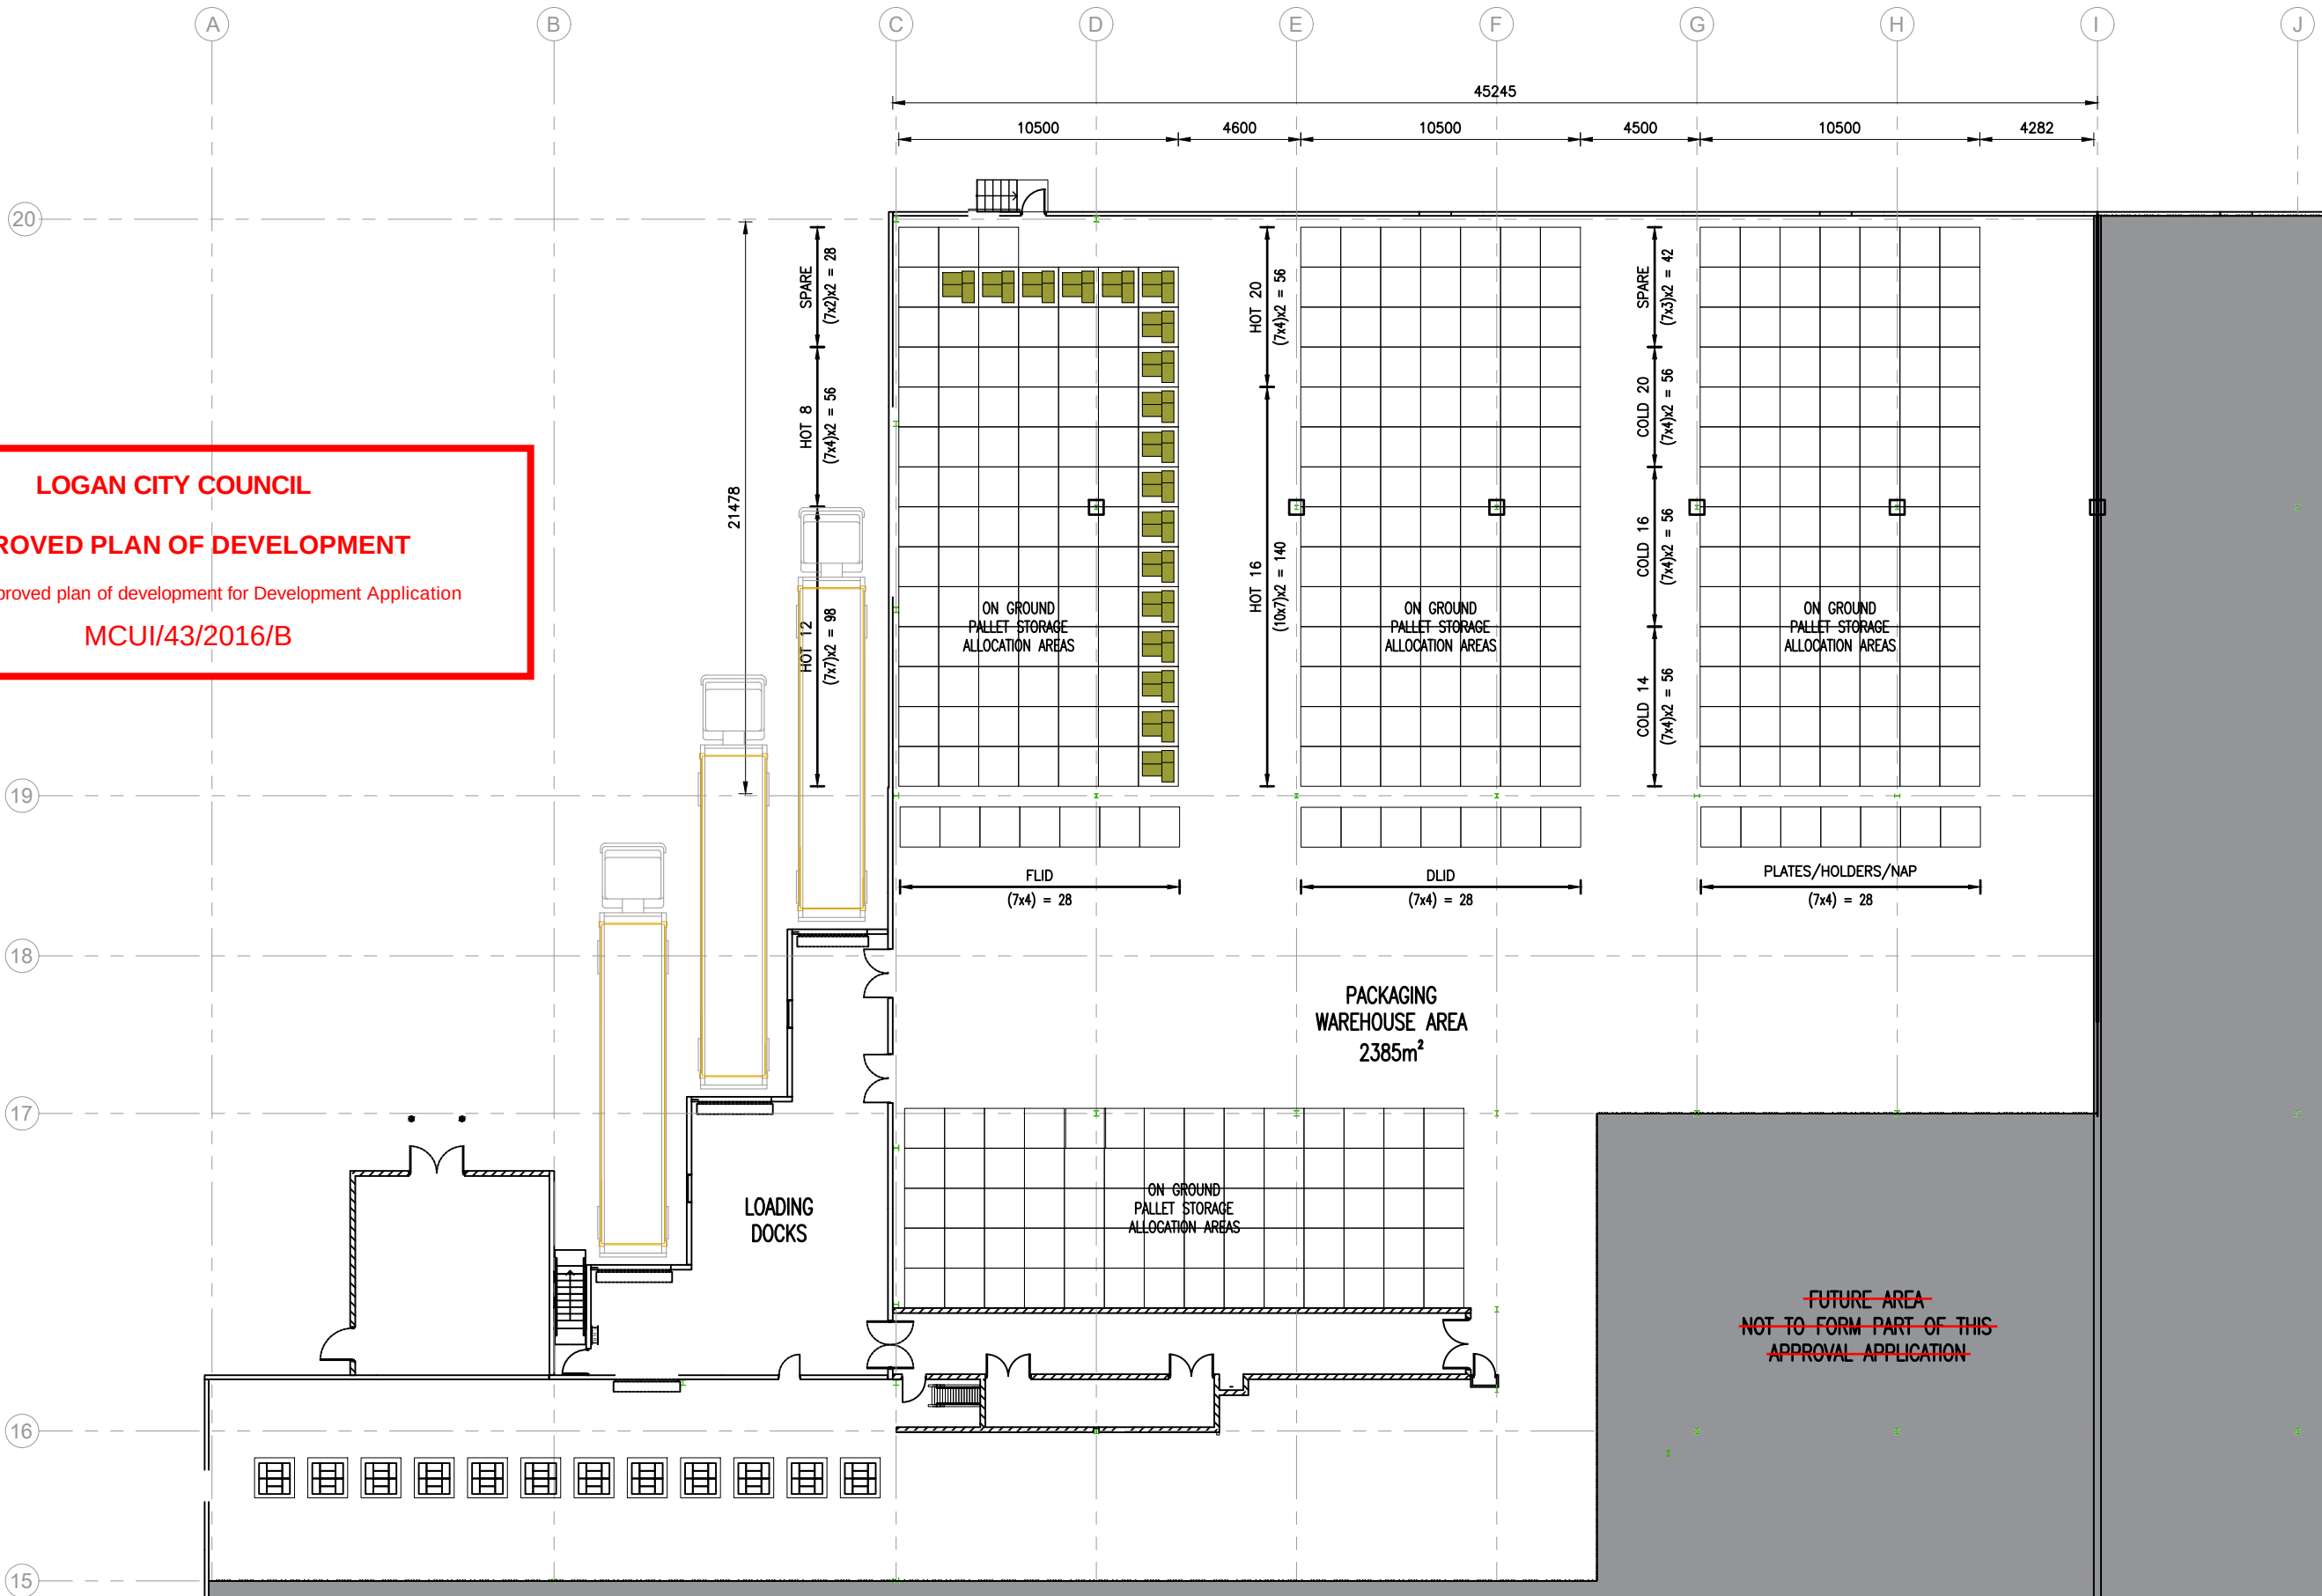

PACKAGING LAYOUT PLAN
Scale 1:250

PRELIMINARY
NOT FOR CONSTRUCTION

COPYRIGHT
These designs and plans are subject to Copyright, and not to be reproduced wholly or in part without the written consent of the designer at Tonken Property Group Pty. Ltd. Do no scale from drawing. All dimensions to be verified on site. Check all discrepancies with Tonken Property Group Pty. Ltd.



Project:
NEW MULTI PURPOSE CENTRE
EXIT 35
PACIFIC HIGHWAY
BEENLEIGH

Title:
PACKAGING LAYOUT PLAN

Created Date:	28.10.15	Drawn by:	KW
Scale:	AS SHOWN	Page Size:	A3
Drawing No.	2500 - P02	Rev.	P8

- LEGEND**
- SITE BOUNDARY
 - 2.50 EXISTING CONTOURS
 - CATCH DRAIN
 - SEDIMENT FENCE
 - ROCK CHECK DAM
 - GULLY INLET PROTECTION
 - SHAKER GRID

NOTE
REFER DRG. No. C1-02 FOR FURTHER DETAILS.

SEDIMENT BASIN CALCULATION DETAILS:

SEDIMENT BASIN No.2
VOLUMETRIC RUNOFF COEFFICIENT (Cv) = 0.5
AREA (A) = 1.07ha
SETTLING VOLUME = 400 Cv.A = 214m³
SEDIMENT STORAGE VOLUME = HALF SETTLING VOLUME = 107m³
TOTAL SEDIMENT BASIN VOLUME REQUIRED = 321m³

SEDIMENT BASIN DIMENSIONS:
18.0m LONG X 18.0m WIDE X 1.4m DEEP
INCLUDING 1:3 SIDE BATTERS
SURFACE AREA = 321m²

SEDIMENT STORAGE DEPTH = 0.300m
SETTLING DEPTH = 1.0m
FREEBOARD = 0.1m
(ACTUAL TOTAL SEDIMENT BASIN VOLUME = 321m³)

COUNCIL NOTE:
Amend the external works, vehicle crossover locations and car parking layout consistent with the approved "External Roadworks Plans Sheet 1" and "Sheet 2", Drawing No. C9-01 and C9-02, prepared by Robert Bird Group.

JOINS DRG. No. C1-02

PROPOSED BUILDING PAD

EXISTING BUILDING

LOWER LEVEL CARPARK

SEDIMENT BASIN No.2

EXISTING TAVERN

SITE ENTRY

SERVICE ROAD

LOGAN CITY COUNCIL


APPROVED PLAN OF DEVELOPMENT

This is the approved plan of development for Development Application

MCUI/43/2016/B

EROSION AND SEDIMENT CONTROL NOTES

1. SEDIMENTATION DEVICES MUST COMPLY WITH:
 - SOIL AND EROSION CONTROL ENGINEERING GUIDELINES FOR QUEENSLAND CONSTRUCTION SITES 1996 OR LATER VERSION (THE INSTITUTE OF ENGINEERS AUSTRALIA (Q.L.D.))
 - SEDIMENT BASIN DESIGN, CONSTRUCTION AND MAINTENANCE GUIDELINES FEB. 2000 OR LATER VERSION (BRISBANE CITY COUNCIL)
 - EROSION AND SEDIMENT CONTROL STANDARD VERSION 9 OR LATER (BRISBANE CITY COUNCIL)
2. ALL EROSION AND SEDIMENT CONTROL DEVICES ARE TO BE INSPECTED AT LEAST WEEKLY, PRIOR TO EXPECTED RAINFALL AND AFTER RAINFALL. ANY DAMAGE OR EXCESS EROSION/SEDIMENT IS TO BE REPAIRED/MANAGED AS REQUIRED TO MAINTAIN CONTROL DEVICES.
3. WATER QUALITY SAMPLES MUST BE TAKEN AND ANALYSED PRIOR TO RELEASE OF ANY WATER FROM THE SITE. WATER QUALITY MUST SATISFY THE FOLLOWING CRITERIA AT ALL TIMES: TSS < 20NTU, PH BETWEEN 6.5 AND 8.5 AT ALL TIMES. RESULTS ARE REQUIRED WITHIN 48 HOURS OF SAMPLING. ALL WATER QUALITY DATA INCLUDING DATES OF RAINFALL AND WATER RELEASE, MUST BE MAINTAINED IN AN ON-SITE REGISTER. THIS REGISTER IS TO BE MAINTAINED FOR THE DURATION OF THE APPROVED WORKS, AND BE AVAILABLE ON-SITE FOR INSPECTION BY COUNCIL OFFICERS ON REQUEST.
IF TSS (TOTAL SUSPENDED SOLIDS) OF 20NTU CAN NOT BE ACHIEVED THEN THE TRAPPED SILT LADEN WATER SHALL BE FLOCCULATED WITH GYPSUM APPLIED AT A RATE OF APPROXIMATELY 32KG/100m³.
4. THE CONTRACTOR SHALL PROVIDE A PLAN TO COUNCIL SPECIFYING CONTROLS FOR THE VARIOUS CONSTRUCTION PHASES.
5. EROSION AND SEDIMENT CONTROL MEASURES SHALL BE SUPPLEMENTED AS REQUIRED TO COMPLY WITH I.E. AUST. (QUEENSLAND DIVISION) "SOIL EROSION AND SEDIMENT ENGINEERING GUIDELINES FOR QUEENSLAND CONSTRUCTION SITES" (JUNE 1996)
6. ALL SEDIMENT AND EROSION CONTROL WORKS TO BE MAINTAINED AT ALL TIMES. ALL SUCH WORKS TO BE REMOVED IMMEDIATELY PRIOR TO FINAL COMPLETION OR AS DIRECTED BY THE SUPERINTENDANT, INCLUDING RESTORATION OF ALL SURFACES TO PRE-EXISTING CONDITION.
7. UNDER NO CIRCUMSTANCES IS FILL TO BE PLACED ON OR ALLOWED TO ESCAPE INTO ADJOINING PROPERTY.
8. TOP SOIL STOCKPILES TO BE NOT GREATER THAN 1.0M HIGH. ALL TEMPORARY STOCKPILES (OVER FOUR WEEKS) TO BE GRASSED WITH RYE, OATS OR MILLET (20KG/HA). ALL STOCKPILES TO BE LOCATED CLEAR OF WATERCOURSES AND DRAINAGE WORKS.
9. ALL DISTURBED SURFACES, BOTH CUT & FILL INCLUDING FOOTPATHS, ARE TO BE REVEGETATED TO THE LANDSCAPE ARCHITECTS REQUIREMENTS.
10. CONTRACTOR TO RETAIN VEGETATION COVER TO ALL LANDSCAPED AREAS OF THE SITE WHERE POSSIBLE.
11. PROVIDE GULLY INLET PROTECTION TO THE NEXT DOWNSTREAM PIT.

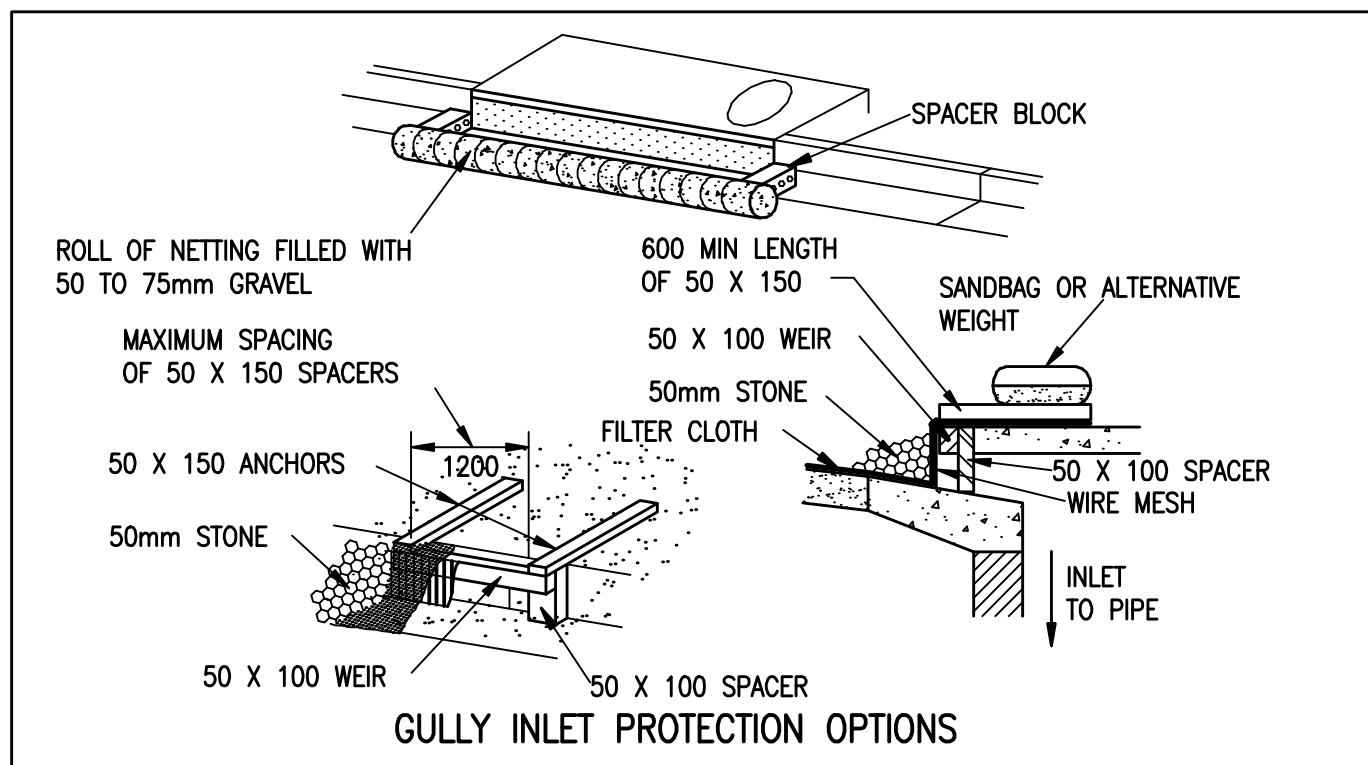

This information shall be copyright except for the sole purpose of assisting the organisation named in this document in performing tasks associated with the nominated project. This drawing and associated or derived information shall not be used for other purposes or transferred to others without written permission of 'Robert Bird Group'

DO NOT SCALE DRAWINGS, USE FIGURED DIMENSIONS
REFER COVER SHEET FOR NOTES UNLESS NOTED OTHERWISE

SCALE 1:500

0 10 20 30 m

Rev.	Revision Description	By.	App.	Date	Rev.	Revision Description	By.	App.	Date
P1	PRELIMINARY ISSUE	CR	NF	07.09.07					
A1	OPERATIONAL WORKS APPROVAL	CR	NF	11.09.07					
P2	UPDATED LAYOUTS - PRELIM ISSUE	SJ	BR	16.10.07					
T1	ISSUE FOR TENDER	AW	CR	22.10.07					
C1	ISSUE FOR CONSTRUCTION	AW	CR	21.02.08					

Structural & Civil
Engineering Consultant



RobertBirdGroup

BRISBANE OFFICE:
Robert Bird Group Pty Ltd
PO Box 7035, Riverside Centre,
Brisbane, QLD 4001
Level 16 ANZ Centre
334 Queen St, Brisbane QLD
Ph. (07) 3319 2777
Fax. (07) 3319 2799
ACN 010 100 248

Web Site: www.robertbird.com


Client
QUINN GROUP

Title
**EROSION AND
SEDIMENT CONTROL
PLAN 1 OF 2**

Project
OC @ EXIT 35

APPROVED FOR CONSTRUCTION

Date 13.09.07	Design CR	Checked ---
Scale @ A1 1:500	Drawn GF	Approved ---
Job Number 07365	Drawing Number C1-01	Revision C1

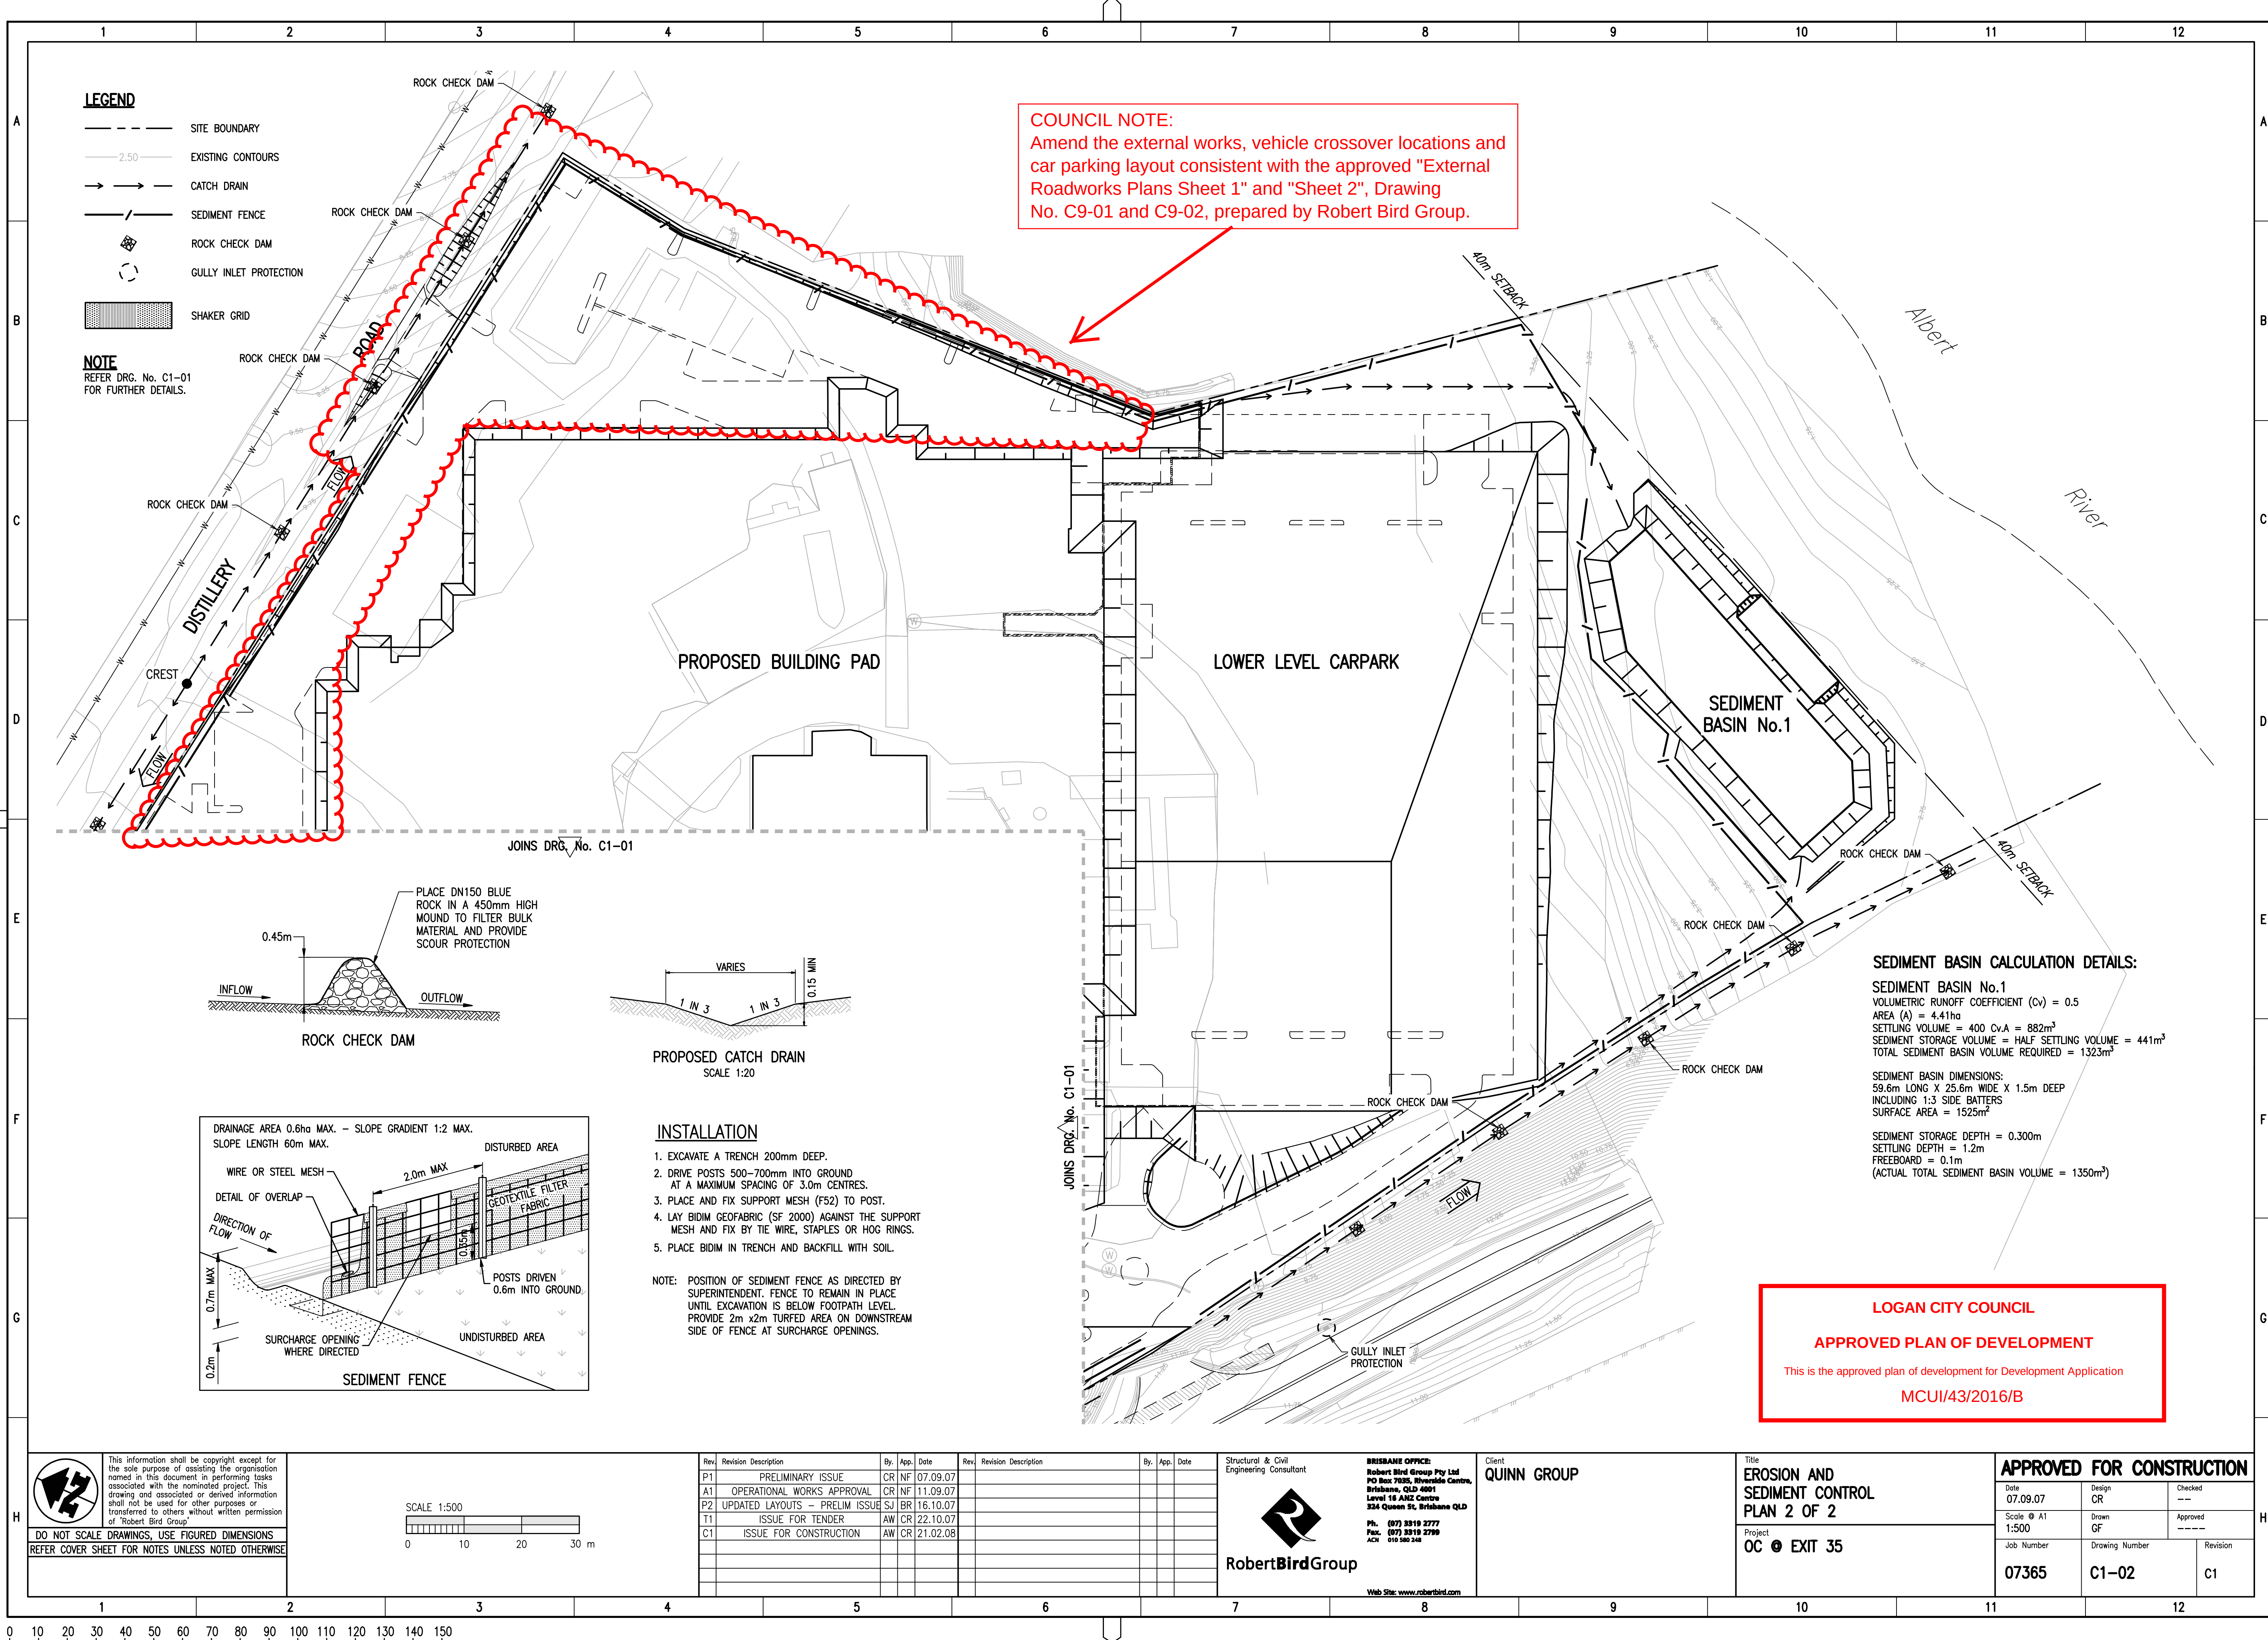

LEGEND

- SITE BOUNDARY
- 2.50 — EXISTING CONTOURS
- — — — — EXTENT OF WORKS
- BE 10.125 BULK EARTHWORKS LEVEL
- — — — — TOP OF BATTER
- — — — — BOTTOM OF BATTER

COUNCIL NOTE:

Amend the external works, vehicle crossover locations and car parking layout consistent with the approved "External Roadworks Plans Sheet 1" and "Sheet 2", Drawing No. C9-01 and C9-02, prepared by Robert Bird Group.

LOGAN CITY COUNCIL

APPROVED PLAN OF DEVELOPMENT

This is the approved plan of development for Development Application

MCUI/43/2016/B

BULK EARTHWORKS NOTES

- THE CONTRACTOR SHALL BE RESPONSIBLE FOR THE REMOVAL, COMPACTION AND DISPOSAL OF ALL EXCAVATED MATERIAL AS REQUIRED.
- ALL TOPSOIL CONTAINING ORGANIC MATTER IS TO BE STRIPPED FROM EARTHWORKS AREA TO DEPTH OF 100mm MINIMUM AND STOCKPILED AS DIRECTED.
- EXCAVATION LEVELS SHOWN ON THIS DRAWING ARE BULK EXCAVATION LEVELS. (TO A.H.D.)
- CONTOURS SHOWN ARE EXISTING
- THE LOCATION AND LEVELS OF ALL EXISTING SERVICES ARE TO BE VERIFIED WITH THE RELEVANT AUTHORITY BY THE CONTRACTOR PRIOR TO COMMENCEMENT OF ANY CONSTRUCTION. THE LOCATION OF ALL EXISTING SERVICES SHOWN ARE APPROXIMATE ONLY. THE CONTRACTOR SHALL ARRANGE RELOCATION OF EXISTING SERVICES, WHERE NECESSARY FOR EARTHWORKS CONSTRUCTION, WITH THE RELEVANT SERVICE AUTHORITY.
- EXTREME CARE TO BE USED WHILE EARTHWORKS ARE BEING CARRIED OUT IN THE VICINITY OF EXISTING SERVICES THAT ARE TO REMAIN. THE CONTRACTOR IS TO CONFIRM POSITION AND LEVELS PRIOR TO COMMENCING WORK.
- ALL TEMPORARY EARTHWORKS BATTERS SHOWN AT 1:1.5. ALL PERMANENT BATTERS SHOWN AT 1:2. ALL BATTERS TO BE CONFIRMED ON SITE BY THE GEOTECHNICAL ENGINEER.
- THE CONTRACTOR SHALL LIAISE WITH THE GEOTECHNICAL ENGINEER TO VERIFY THE STABILITY OF ALL BATTERS AS EXCAVATION PROCEEDS. THE CONTRACTOR IS RESPONSIBLE FOR THE MAINTENANCE OF BATTERS DURING CONSTRUCTION OF BULK EARTHWORKS AND RETAINING WALLS.
- WHERE ANY CLAY IS EXPOSED ON THE FOOTPATH ALIGNMENT, IT SHALL BE OVER EXCAVATED (100mm MIN.) AND A LAYER OF COMPACTED COARSE GRAVEL PLACED UP TO THE EARTHWORKS LEVEL TO PROVIDE A WORKING SURFACE. THE THICKNESS OF THE GRAVEL LAYER IS DEPENDANT ON EXPECTED CONSTRUCTION ACTIVITY LOADS AND SHALL BE CONFIRMED ON SITE.
- ALL EARTHWORKS TO BE COMPACTED TO 98% ROD (STANDARD COMPACTION). THE CONTRACTOR SHALL BE RESPONSIBLE FOR ENGAGING THE GEOTECHNICAL ENGINEER TO CARRY OUT LEVEL 1 SUPERVISION OF ALL EARTHWORKS IN ACCORDANCE WITH AS 3788. MINIMUM FILL MATERIAL CBR15 TO BE APPROVED BY GEOTECHNICAL ENGINEER PRIOR TO PLACING.
- THE CONTRACTOR SHALL BE RESPONSIBLE FOR THE DISPOSAL OF ALL ABANDONED UNDERGROUND SERVICES OFF THE SITE TO THE LOCAL AUTHORITY APPROVAL.
- ALL EARTHWORKS AREAS TO BE LEFT IN A FREE DRAINING STATE.
- SETOUT INFORMATION WILL BE PROVIDED ON ELECTRONIC FORMAT (AUTOCAD).
- THE CONTRACTOR'S ATTENTION IS DRAWN TO THE REFERENCE OF ACID SULPHATE SOILS ON THE SITE AND THE LEGISLATION REQUIREMENT IN THIS REGARD.
- ALL AREAS OF UNCONTROLLED FILL IDENTIFIED BY THE GEOTECHNICAL ENGINEER ON SITE SHALL BE REMOVED UNLESS AGREED WITH THE ENGINEER. ALL AREAS IDENTIFIED BELOW THE BUILDING ARE TO BE REMOVED.


This information shall be copyright except for the sole purpose of assisting the organisation named in this document in performing tasks associated with the nominated project. This drawing and associated or derived information shall not be used for other purposes or transferred to others without written permission of "Robert Bird Group".

DO NOT SCALE DRAWINGS. USE FIGURED DIMENSIONS. REFER COVER SHEET FOR NOTES UNLESS NOTED OTHERWISE

SCALE 1:500



Rev	Revision Description	By	App.	Date	Rev	Revision Description	By	App.	Date
P1	PRELIMINARY ISSUE	CR	NF	10.09.07	P3	ISSUE FOR DISCUSSION	AW	CR	19.08.08
A1	OPERATIONAL WORKS APPROVAL	CR	NF	11.09.07	C3	ISSUE FOR CONSTRUCTION	AW	CR	20.08.08
P2	UPDATED LAYOUTS - PRELIM ISSUE	SJ	BR	16.10.07					
T1	ISSUE FOR TENDER	AW	CR	22.10.07					
T2	ISSUE FOR TENDER	AW	CR	29.10.07					
T3	ISSUE FOR TENDER	AW	CR	27.11.07					
T4	BULK EARTHWORKS PAD RAISED	AW	CR	13.12.07					
C1	UPDATED LAYOUT AND LEVELS	AW	CR	05.02.08					
C2	UPDATED LEVELS	AW	CR	15.02.08					

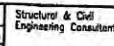

Robert Bird Group
Structural & Civil Engineering Consultant

BRISBANE OFFICE:
Robert Bird Group Pty Ltd
PO Box 7035, Riverside Centre,
Brisbane, QLD 4001
Level 16 ABB Centre
324 Queen St, Brisbane QLD
Ph: (07) 3319 2777
Fax: (07) 3319 2779
ACN: 910 500 244

Client
QUINN GROUP

Title
BULK EARTHWORKS
LAYOUT PLAN
SHEET 1 OF 2

Project
OC @ EXIT 35

APPROVED FOR CONSTRUCTION

Date 10.09.07	Design CR	Checked —
Scale @ A1 1:500	Drawn GF	Approved —
Job Number 07365	Drawing Number C2-01	Revision C3

LEGEND

- SITE BOUNDARY
- - - EXISTING CONTOURS
- EXTENT OF WORKS
- BE 10.125 BULK EARTHWORKS LEVEL
- TOP OF BATTER
- BOTTOM OF BATTER

COUNCIL NOTE:

Amend the external works, vehicle crossover locations and car parking layout consistent with the approved "External Roadworks Plans Sheet 1" and "Sheet 2", Drawing No. C9-01 and C9-02, prepared by Robert Bird Group.

LOGAN CITY COUNCIL

APPROVED PLAN OF DEVELOPMENT

This is the approved plan of development for Development Application

MCUI/43/2016/B

This information shall be copyright except for the sole purpose of assisting the development named in this document in performing tasks associated with the nominated project. This drawing and associated or derived information shall not be used for other purposes or transferred to others without written permission of Robert Bird Group.

DO NOT SCALE DRAWINGS. USE FIGURED DIMENSIONS. REFER COVER SHEET FOR NOTES UNLESS NOTED OTHERWISE.

SCALE 1:500
0 10 20 30 m

Rev	Revision Description	By	App.	Date	Rev	Revision Description	By	App.	Date
P1	PRELIMINARY ISSUE	CR	NF	10.09.07					
A1	OPERATIONAL WORKS APPROVAL	CR	NF	11.09.07					
P2	UPDATED LAYOUTS - PRELIM ISSUE	SJ	BR	16.10.07					
T1	ISSUE FOR TENDER	AW	CR	22.10.07					
T2	ISSUE FOR TENDER	AW	CR	27.11.07					
T3	BULK EARTHWORKS PAD RAISED	AW	CR	13.12.07					
C1	UPDATED LAYOUT AND LEVELS	AW	CR	05.02.08					
C2	UPDATED LEVELS	AW	CR	15.02.08					
C3	UPDATED LEVELS	JF	CR	20.02.08					

Structural & Civil Engineering Consultant



Robert Bird Group

COMPANIES OFFICE:
Robert Bird Group Pty Ltd
PO Box 1000, Queensland Centre,
Brisbane, QLD 4001
Level 10 A&M Centre
204 Queen St, Brisbane QLD
Ph: (07) 3710 3777
Fax: (07) 3710 3771
Web: www.rbg.com.au

Client
QUINN GROUP

Title
BULK EARTHWORKS
LAYOUT PLAN
SHEET 2 OF 2
Project
OC @ EXIT 35

APPROVED FOR CONSTRUCTION

Date 10.09.07	Drawn CR	Checked ---
Scale @ A1 1:500	Drawn GF	Approved ---
Job Number 07385	Drawing Number C2-02	Revision C3


1. ALL DIMENSIONS ON THE DRAWINGS ARE IN METRES UNLESS SHOWN OTHERWISE.
2. ANY ROADWORKS SET-OUT AND DIMENSIONS ARE REFERENCED TO THE NOMINAL KERB LINE (FACE OF KERB).
3. ALL ROAD PAVEMENT LEVELS SHOWN ARE LIP LEVEL OF KERB AND CHANNEL OR PAVEMENT LEVEL OF KERB.
4. ROAD PAVEMENT LEVELS ON INTERSECTION DETAILS ARE AT TP's, MIDPOINTS OR QUARTER POINTS UNLESS SHOWN OTHERWISE.
5. ASPHALTIC CONCRETE SURFACING SHALL BE TO GOLD COAST CITY COUNCIL STANDARDS.
6. FINAL PAVEMENT DEPTHS SHALL BE DETERMINED BY THE SUPERINTENDENT AFTER SUBGRADE TESTING RESULTS HAVE BEEN EXAMINED.
7. SIDE DRAINS ARE TO BE INSTALLED UNDER ALL KERB & CHANNEL AND KERB ONLY, AND SHALL DRAIN TO A GULLY PIT. SIDE DRAINS ARE TO BE INSTALLED UNDER ALL LANDSCAPED TRAFFIC ISLANDS.
8. ALL WORKS SHALL BE CARRIED OUT IN ACCORDANCE WITH CURRENT GOLD COAST CITY COUNCIL SPECIFICATIONS AND STANDARD DRAWINGS UNLESS SHOWN OTHERWISE.
9. THE CONTRACTOR SHALL VERIFY LOCATIONS OF EXISTING SERVICES WITH ALL RELEVANT AUTHORITIES BEFORE COMMENCING CONSTRUCTION.(PROVIDE A COPY OF THE INFORMATION TO THE SITE SUPERINTENDENT.) IN PARTICULAR PROPOSED SERVICE CROSSINGS, EG. PROPOSED SEWER RETICULATION CROSSING EXISTING TELSTRA LINES.
10. ANY RELOCATION OF EXISTING SERVICES REQUIRED IS TO BE UNDERTAKEN BY THE RELEVANT SERVICE AUTHORITY, THE CONTRACTOR SHALL BE RESPONSIBLE FOR AND INCLUDE COSTS IN HIS CONTRACT PRICE FOR ANY RELOCATION OF EXISTING SERVICES.
11. SUB-GRADE GRAVEL SHALL EXCEED 100mm MIN. BELOW AND 150mm BEHIND REAR OF ANY TYPE OF KERB OR KERB & CHANNEL ON ALL PAVEMENTS.
12. THE CONTRACTOR SHALL VERIFY OFFSET PEGS AND BENCH MARK LEVELS AND ADVISE THE SUPERINTENDENT OF ANY DISCREPANCY BEFORE COMMENCING CONSTRUCTION.
13. ALL NEW WORK SHALL JOIN NEATLY TO AND MATCH EXISTING WORK. EXISTING ROAD PAVEMENT SHALL BE CUT BACK 300mm FOR NEW PAVEMENT TO JOIN TO.
14. THE CONTRACTOR SHALL BE RESPONSIBLE FOR & INCLUDE COSTS FOR THE FOLLOWING IN HIS CONTRACT PRICE:
 - A. GOLD COAST CITY COUNCIL INSPECTION FEES.
 - B. MAINTENANCE BONDS REQUIRED BY COUNCIL.
 - C. THE COLLECTION OF AS CONSTRUCTED DATA IN ACCORDANCE GOCC GUIDELINES.
 - D. PREPARATION OF AS CONSTRUCTED DRAWINGS IN ACCORDANCE WITH GOCC GUIDELINES.
 - E. QUALITY CONTROL DOCUMENTATION FOR GOCC'S RECORDS.

The legend defines the following symbols:

- SITE BOUNDARY**: Represented by two parallel dashed lines.
- EXISTING CONTOURS**: Represented by a solid line with a horizontal scale bar labeled "2.50".
- EXTENT OF WORKS**: Represented by four adjacent rectangular blocks.
- PROPOSED RETAINING WALL**: Represented by a rectangle filled with diagonal hatching.
- BARRIER KERB AND CHANNEL**: Represented by two thick parallel solid lines, with the label "K&C" centered between them.
- BARRIER KERB ONLY**: Represented by two thick parallel solid lines, with the label "KO" centered between them.
- EXISTING KERB & CHANNEL**: Represented by two thin parallel solid lines.
- FINISHED PAVEMENT LEVEL**: Represented by a solid line with a horizontal scale bar labeled "F9.80".
- GUARD RAIL**: Represented by a series of small circles or dots.

 This information shall be copyright except for the sole purpose of assisting the organization named in this document in performing tasks associated with the nominated project. This drawing and associated or derived information shall not be used for other purposes or transferred to others without written permission of "Robert Bird Group"

DO NOT SCALE DRAWINGS, USE FIGURED DIMENSIONS
REFER COVER SHEET FOR NOTES UNLESS NOTED OTHERWISE

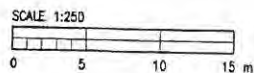

Rev.	Revision Description	By	App.	Date	Rev.	Revision Description	By	App.	Date
P1	PRELIMINARY ISSUE	CR	NF	07.08.07					
A1	OPERATIONAL WORKS APPROVAL	CR	NF	11.08.07					
P2	UPDATED LAYOUTS - PRELIM ISSUE	SJ	BR	16.10.07					
T1	ISSUE FOR TENDER	AW	CR	22.10.07					
T2	ISSUE FOR TENDER	AW	CR	27.11.07					
T3	ISSUE FOR TENDER	AW	CR	12.12.07					
P3	FOR INFORMATION	AW	CR	06.02.08					
C1	UPDATED FINISHED LEVELS	JP	CR	20.02.08					




Robert Bird Group

BRISBANE OFFICE:
Robert Bird Group Pty Ltd
PO Box 7035, Riverside Centre
Brisbane, QLD 4001
Level 16 ANZ Centre
324 Queen St. Brisbane QLD
Ph. (07) 3319 2777
Fax. (07) 3319 2798

Client
QUINN GROUP

COUNCIL NOTE:
Amend the external works, vehicle crossover locations and car parking layout consistent with the approved "External Roadworks Plans Sheet 1" and "Sheet 2", Drawing No. C9-01 and C9-02, prepared by Robert Bird Group.

NOTE: BARRIERS SHALL BE CONSTRUCTED TO PREVENT VEHICLES RUNNING OVER THE EDGE OF A RAISED PLATFORM ABOVE GROUND LEVEL. THEY ARE REQUIRED WHEREVER THE DROP FROM THE EDGE TO LOWER LEVEL EXCEEDS 600mm.

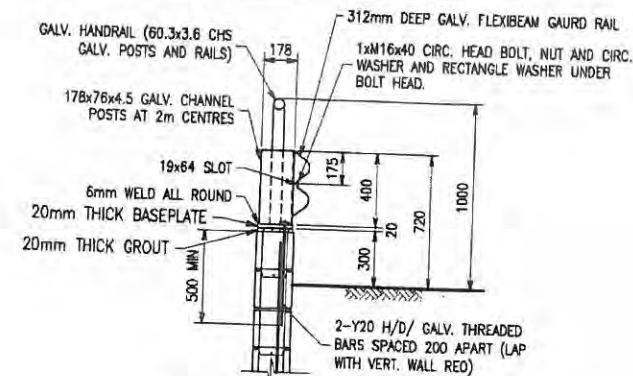

PROPOSED GUARDRAIL ON WALL
DETAIL - ELEVATION
SCALE 1:20



LOGAN CITY COUNCIL
APPROVED PLAN OF DEVELOPMENT
is the approved plan of development for Development Application
MCUI/43/2016/B

Title
SITWORKS LAYOUT PLAN
SHEET 1 OF 5

Project
OC © EXIT 35

APPROVED FOR CONSTRUCTION		
Date	Design	Checked

07.09.07	CR	Uncheck
Scale @ A1 1:250	Drawn GF	Approved
Job Number 07365	Drawing Number C3-01	Revision C1

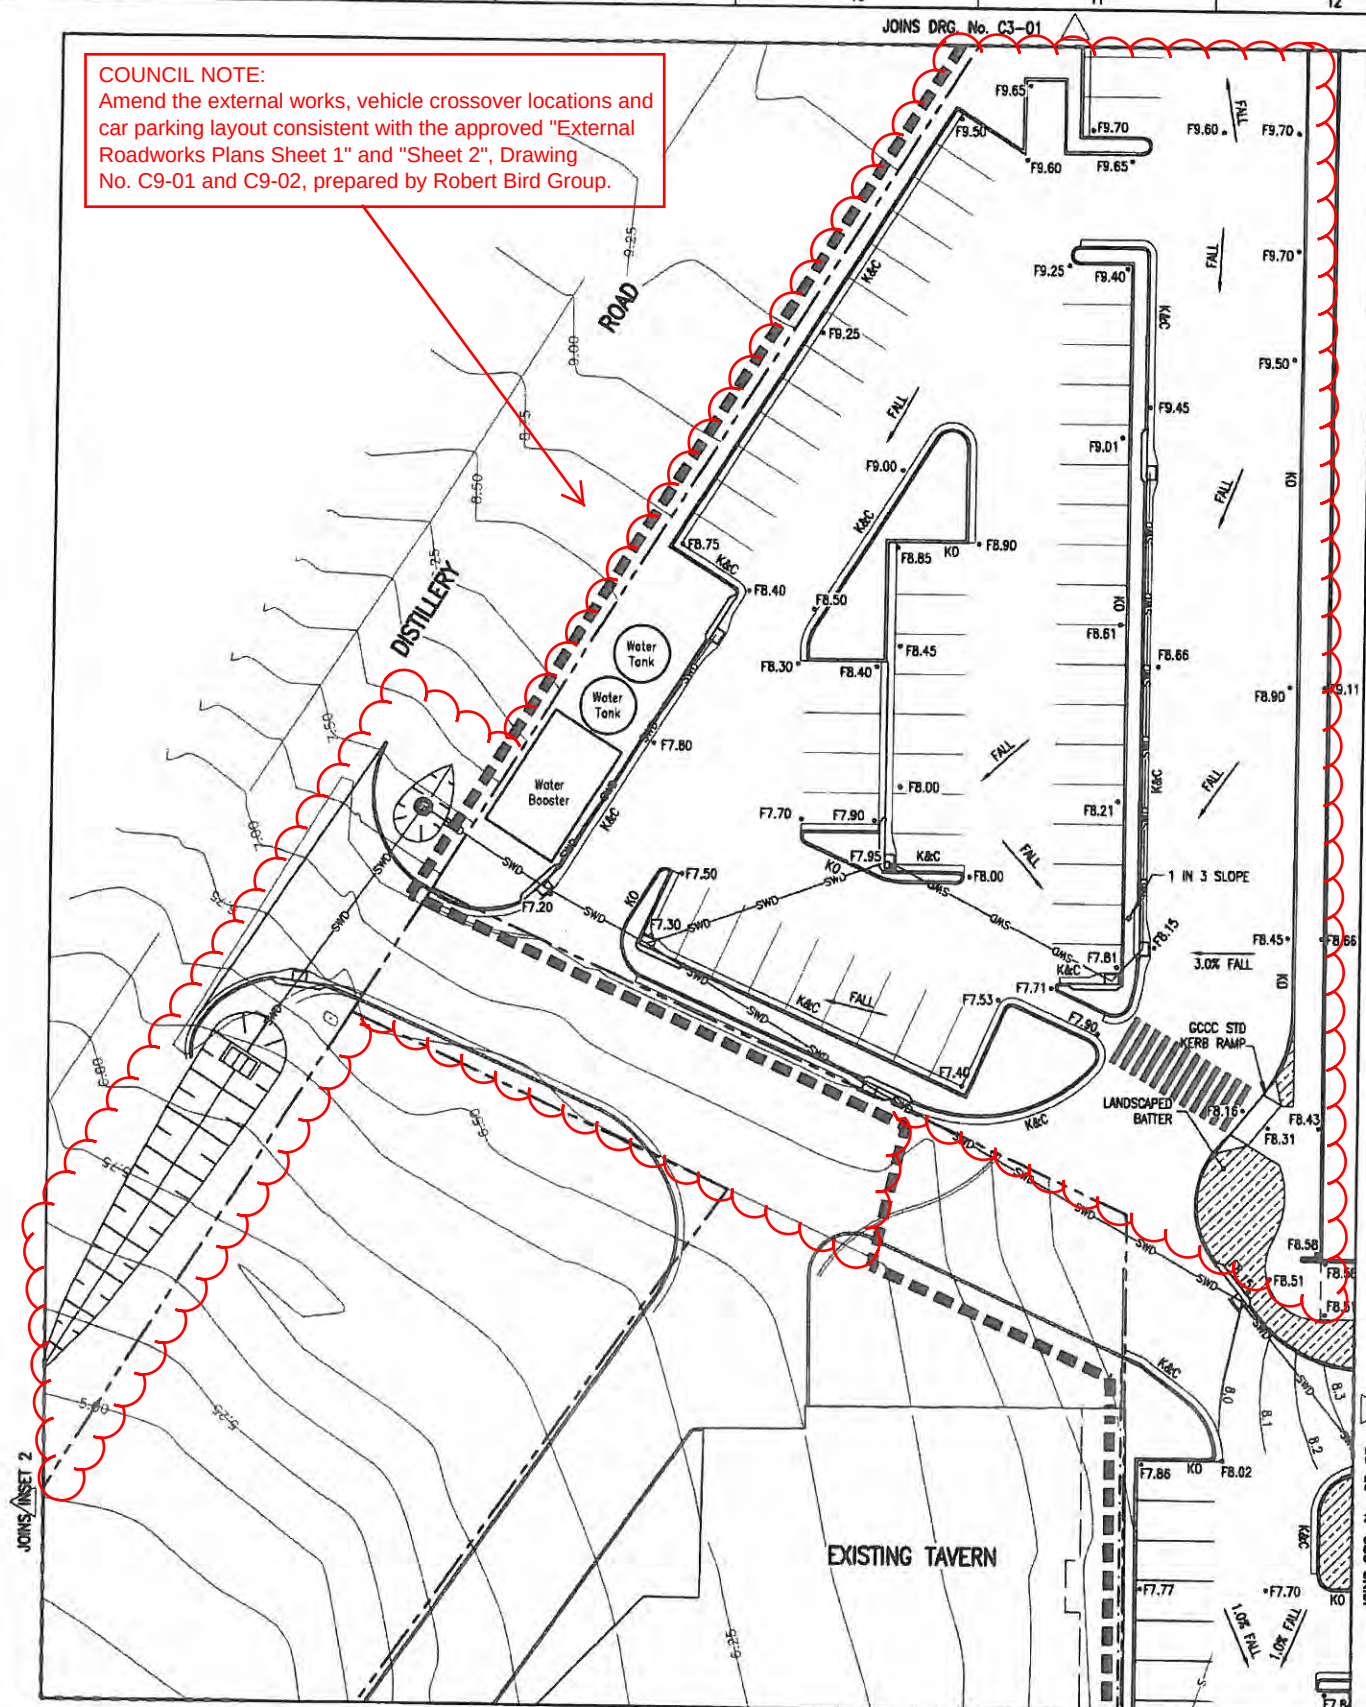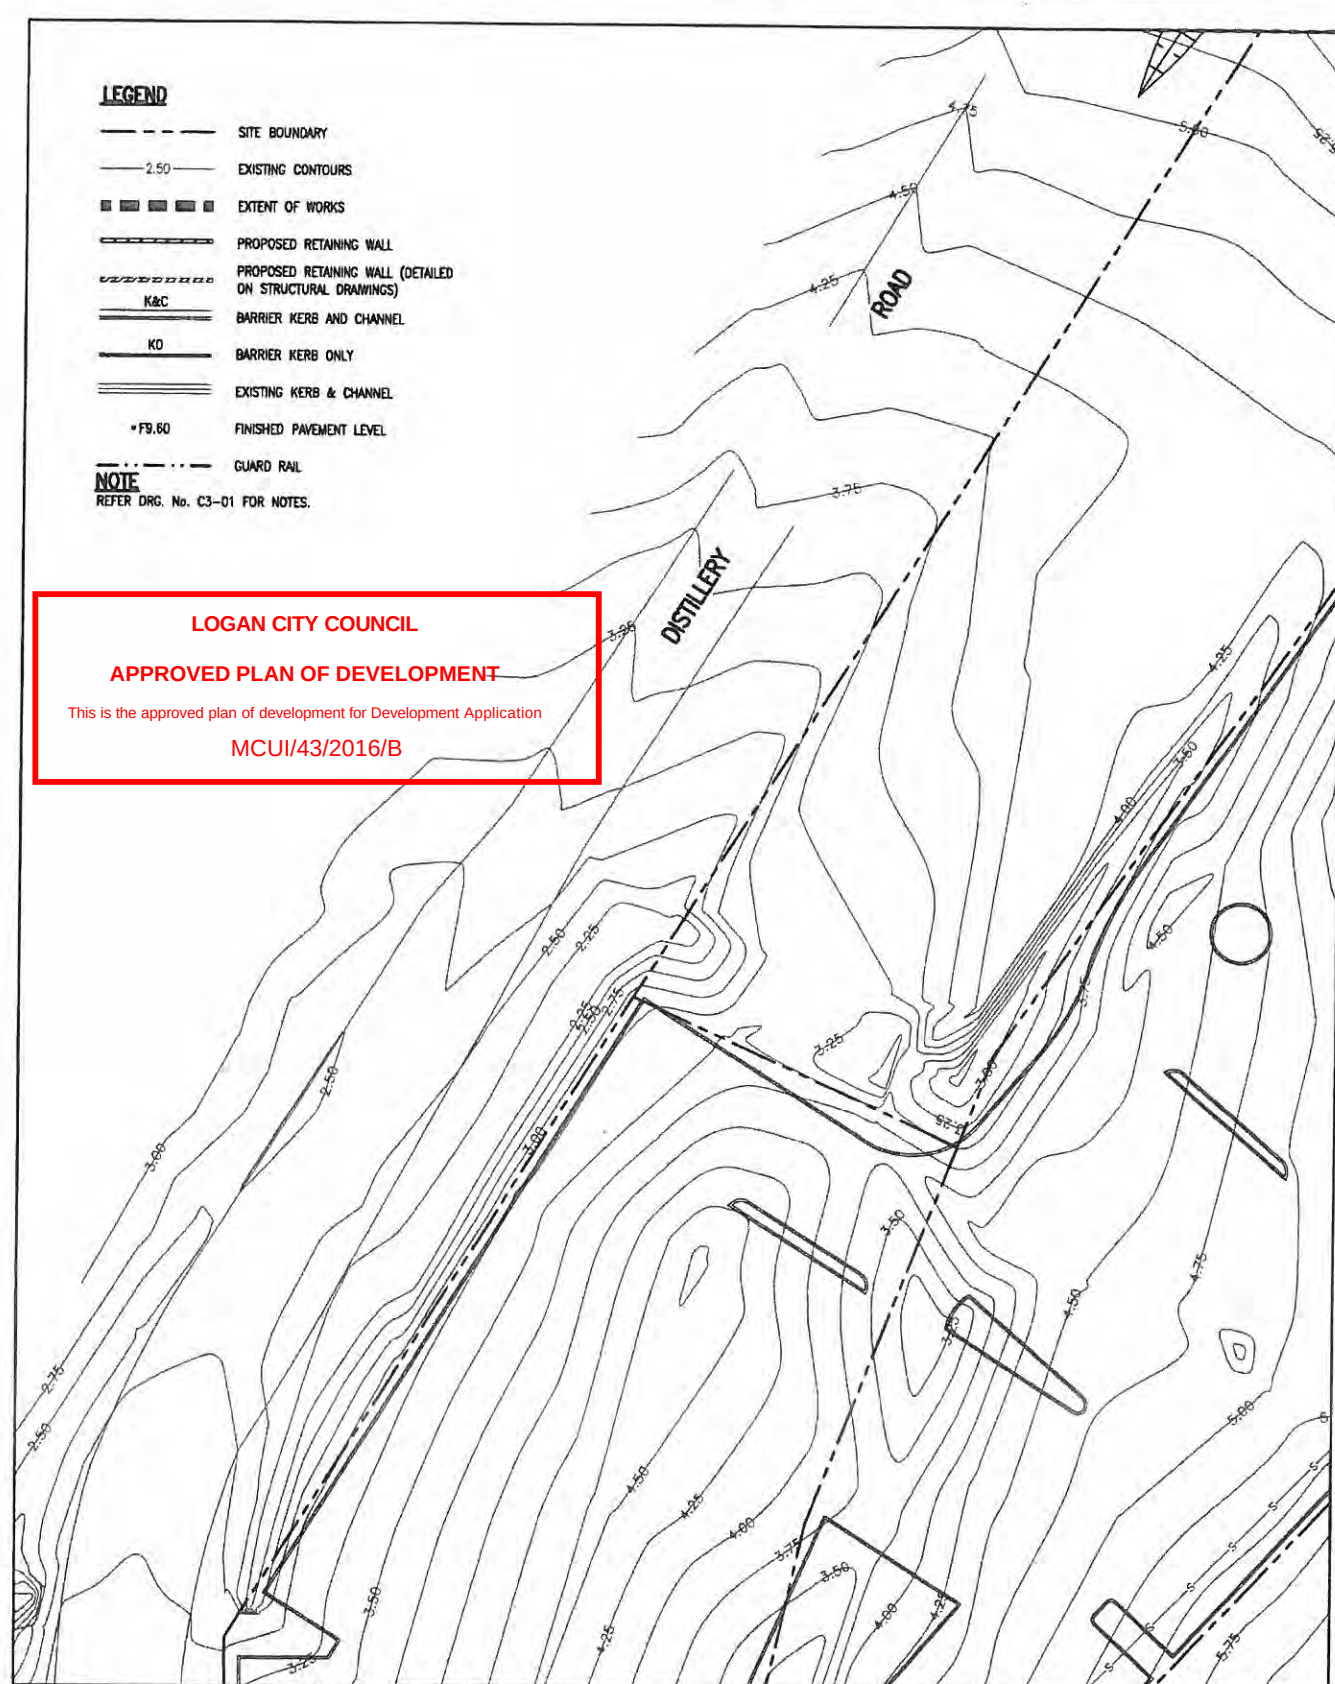

DO NOT SCALE DRAWINGS. USE FIGURED DIMENSIONS
REFER COVER SHEET FOR NOTES UNLESS NOTED OTHERWISE

SCALE 1:250

Rev	Revision Description	By	App	Date
P1	PRELIMINARY ISSUE	CR	NF	07.09.07
A1	OPERATIONAL WORKS APPROVAL	CR	NF	11.09.07
P2	UPDATED LAYOUTS - PRELIM ISSUE	SJ	BR	16.10.07
T1	ISSUE FOR TENDER	AW	CR	22.10.07
T2	ISSUE FOR TENDER	AW	CR	27.11.07
C1	ISSUED FOR CONSTRUCTION	AW	CR	12.03.08
P3	ISSUED FOR DISCUSSION	AW	CR	19.08.08
C2	ISSUED FOR CONSTRUCTION	AW	CR	20.08.08

Robert Bird Group
Structural & Civil Engineering Consultant

BRISBANE OFFICE:
Robert Bird Group Pty Ltd
PO Box 7035, Riverside Centre,
Brisbane, QLD 4001
Level 16 ANZ Centre
324 Queen St, Brisbane QLD
Ph: (07) 3310 2777
Fax: (07) 3310 2793
ACN: 010 590 344
Web Site: www.robertbird.com

Client:
QUINN GROUP

Title:
STEWORKS LAYOUT PLAN
SHEET 2 OF 5


Project:
OC @ EXIT 35

APPROVED FOR CONSTRUCTION

Date	Design	Checked
07.08.07	CR	

Scale @ A1: 1:250

Job Number	Drawing Number	Revision
07365	C3-02	C2

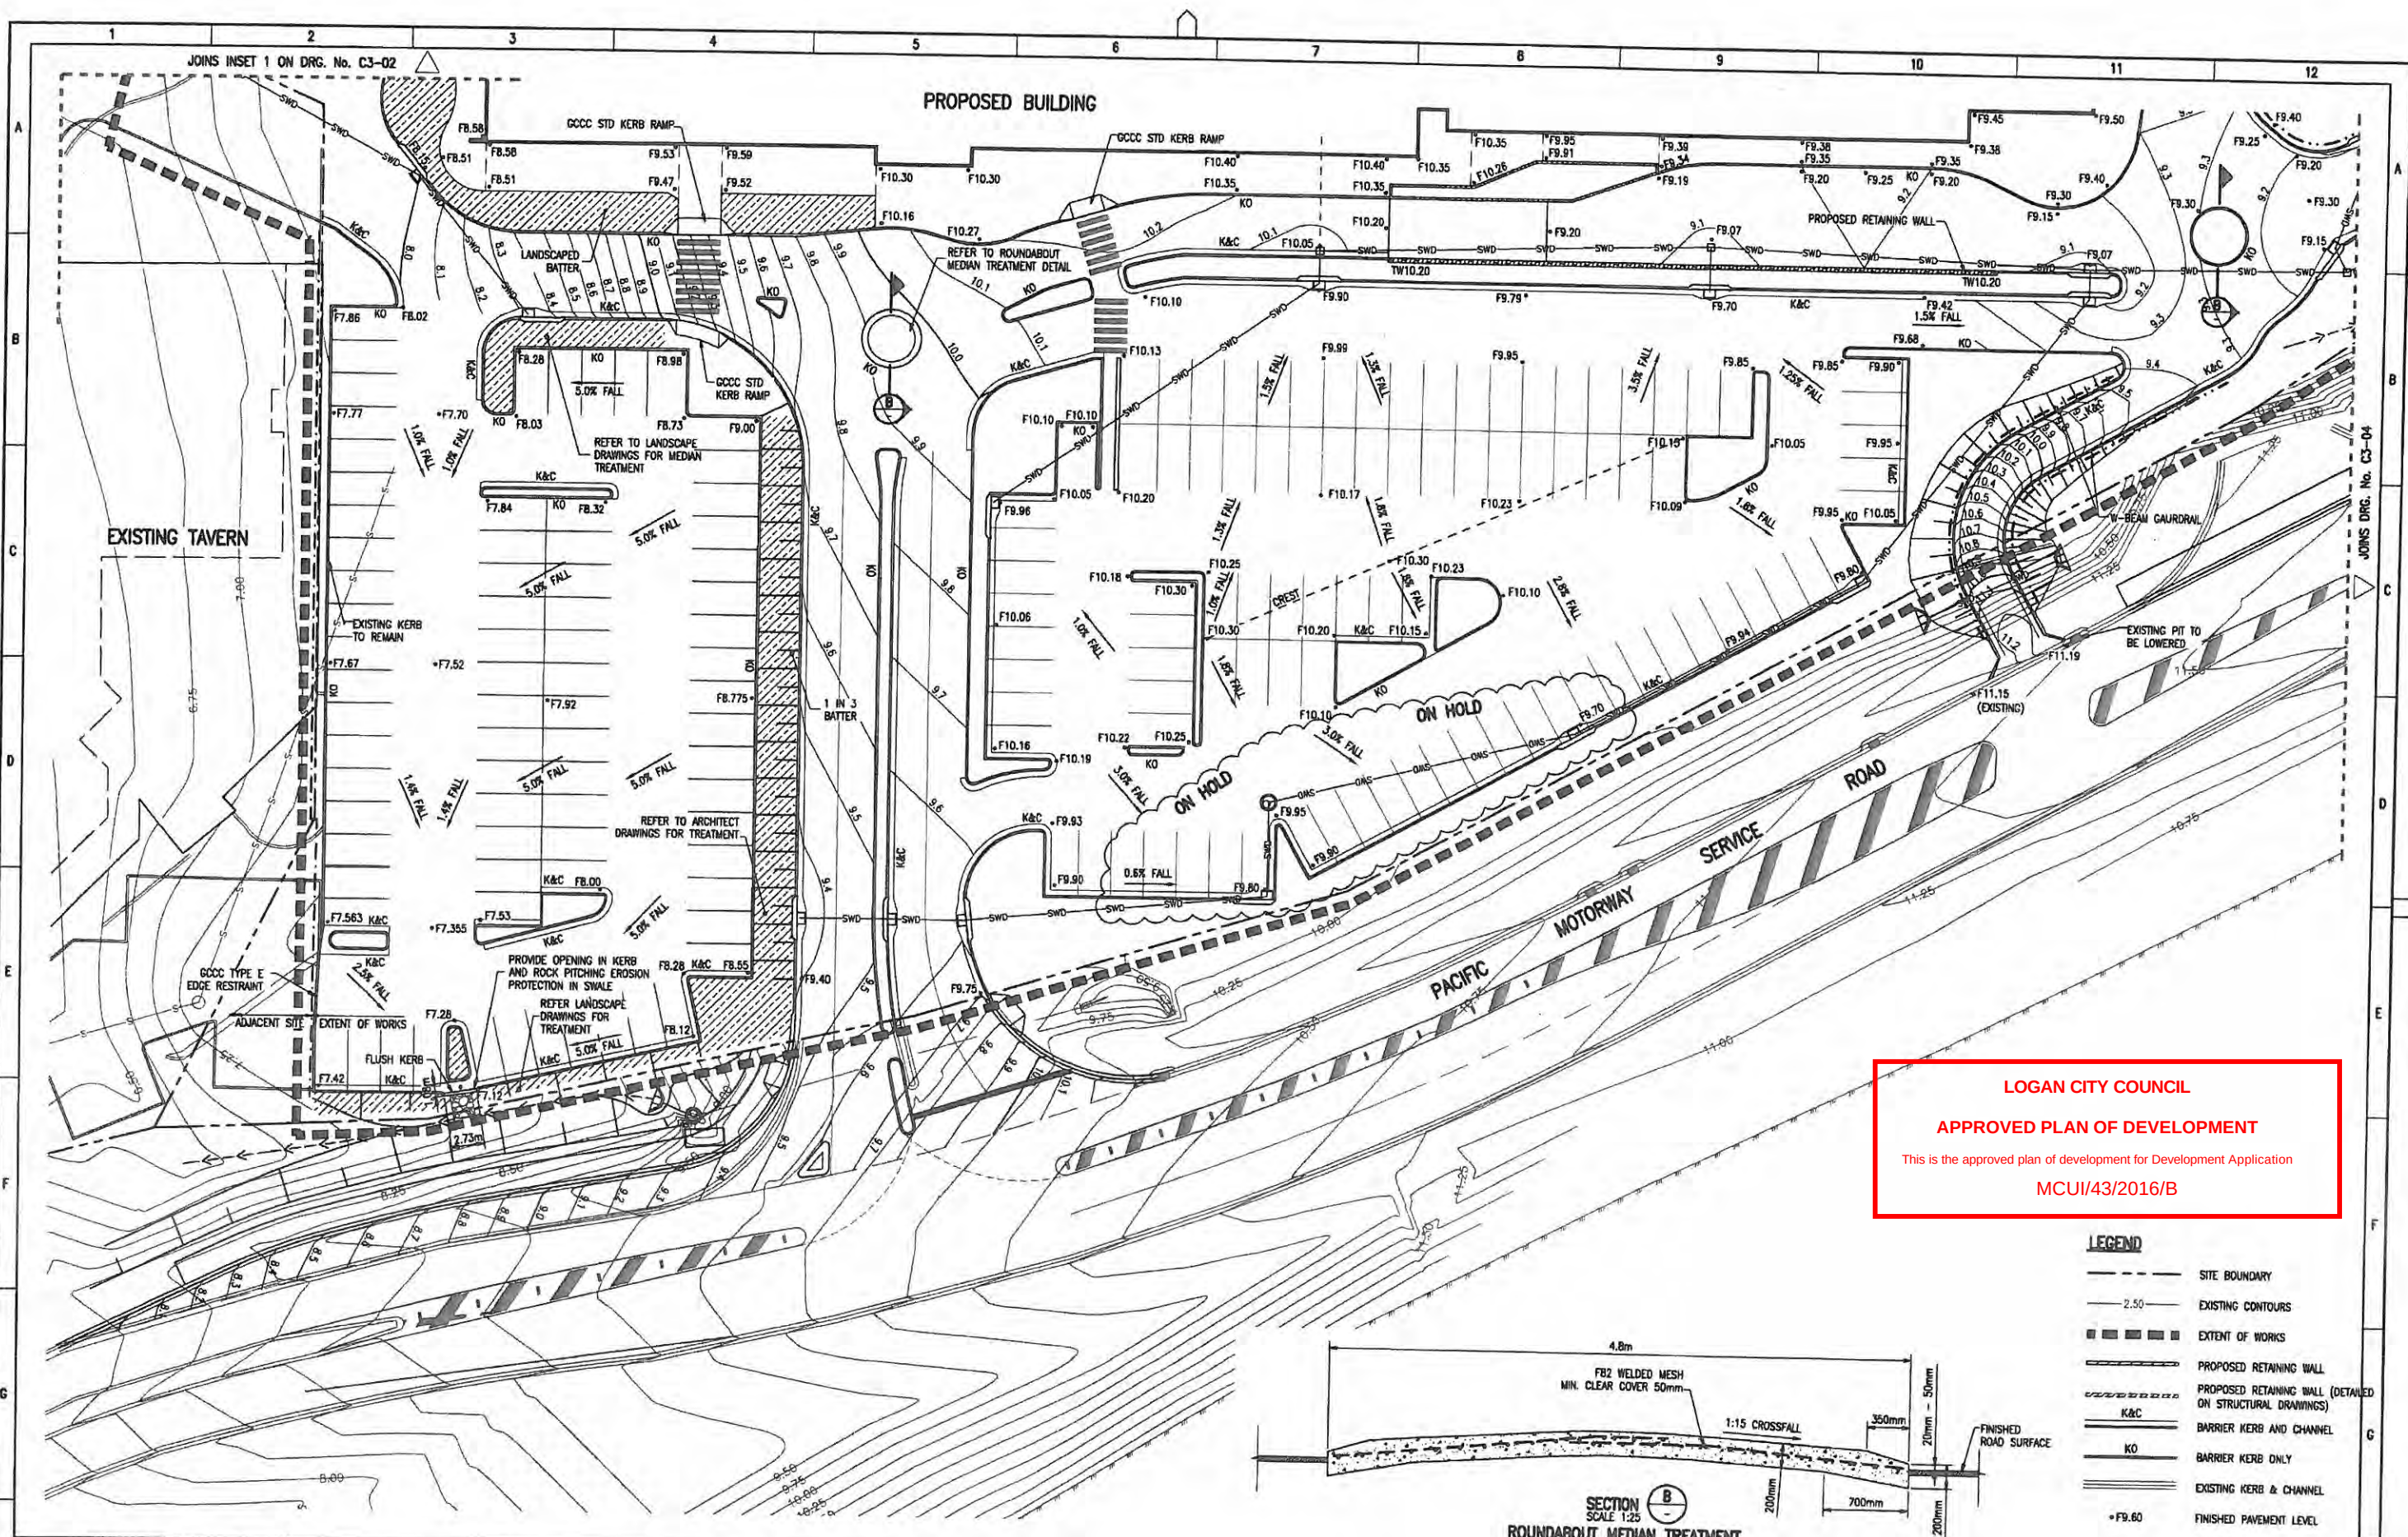

LOGAN CITY COUNCIL

APPROVED PLAN OF DEVELOPMENT

This is the approved plan of development for Development Application


MCUI/43/2016/B

- LEGEND**
- SITE BOUNDARY
 - 2.50 — EXISTING CONTOURS
 - ■ ■ ■ ■ EXTENT OF WORKS
 - PROPOSED RETAINING WALL
 - PROPOSED RETAINING WALL (DETAILED ON STRUCTURAL DRAWINGS)
 - K&C BARRIER KERB AND CHANNEL
 - KO BARRIER KERB ONLY
 - EXISTING KERB & CHANNEL
 - *F9.60 FINISHED PAVEMENT LEVEL
 - — — — — GUARD RAIL

This information shall be copyright except for the sole purpose of assisting the organisation named in this document in performing tasks associated with the nominated project. This drawing and associated or derived information shall not be used for other purposes or transferred to others without written permission of Robert Bird Group

DO NOT SCALE DRAWINGS, USE FIGURED DIMENSIONS

REFER COVER SHEET FOR NOTES UNLESS NOTED OTHERWISE

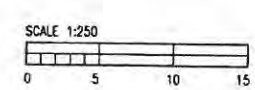

Rev	Revision Description	By	App.	Date	Rev	Revision Description	By	App.	Date
P1	PRELIMINARY ISSUE	CR	NF	07.09.07					
A1	OPERATIONAL WORKS APPROVAL	CR	NF	11.09.07					
P2	UPDATED LAYOUTS - PRELIM ISSUE	SJ	BR	16.10.07					
T1	ISSUE FOR TENDER	AW	CR	22.10.07					
T2	ISSUE FOR TENDER	AW	CR	29.10.07					
T3	ISSUE FOR TENDER	AW	CR	27.11.07					
P3	ISSUE FOR DISCUSSION	AW	CR	19.08.08					
C1	ISSUE FOR CONSTRUCTION	AW	CR	20.08.08					

Structural & Civil Engineering Consultant

Robert Bird Group

BRISBANE OFFICE:
Robert Bird Group Pty Ltd
PO Box 7935, Riverside Centre,
Brisbane, QLD 4001
Level 18 A102 Centre
224 Queen St, Brisbane QLD

Ph: (07) 3310 2777
Fax: (07) 3310 2769
Acc: 916 304 300

Web Site: www.robertbird.com

Client: QUINN GROUP

Title: SITEMARKS LAYOUT PLAN
SHEET 3 OF 5

Project: OC @ EXIT 35

APPROVED FOR CONSTRUCTION			
Date 07.09.07	Design CR	Checked —	
Scale @ A1 1:250	Drawn GF	Approved —	
Job Number 07365	Drawing Number C3-03	Revision C1	

JOINS DRG. No. C3-05

PROPOSED BUILDING

LOWER LEVEL CARPARK

NOTE:
REINFORCEMENT / STARTER BARS TO
STRUCTURAL ENGINEERS DETAILS

SECTION C
SCALE 1:20
PROPOSED RAMP GUARDRAIL DETAIL - ELEVATION

PROPOSED RAMP GUARDRAIL DETAIL - PLAN
SCALE 1:20

LEGEND

- SITE BOUNDARY
- 2.50 --- EXISTING CONTOURS
- ■ ■ ■ ■ EXTENT OF WORKS
- PROPOSED RETAINING WALL
- PROPOSED RETAINING WALL (DETAILED ON STRUCTURAL DRAWINGS)
- K&C BARRIER KERB AND CHANNEL
- K&C BARRIER KERB ONLY
- EXISTING KERB & CHANNEL
- *F9.60 FINISHED PAVEMENT LEVEL
- GUARD RAIL

NOTE
REFER DRG. No. C3-01 FOR NOTES.

LOGAN CITY COUNCIL
APPROVED PLAN OF DEVELOPMENT
This is the approved plan of development for Development Application
MCUI/43/2016/B

This information shall be copyright except for the sole purpose of assisting the organization named in this document in performing tasks associated with the nominated project. This drawing and associated or derived information shall not be used for other purposes or transferred to others without written permission of Robert Bird Group.
DO NOT SCALE DRAWINGS, USE FIGURED DIMENSIONS
REFER COVER SHEET FOR NOTES UNLESS NOTED OTHERWISE

SCALE 1:250
0 5 10 15 m

Rev	Revision Description	By	App.	Date	Rev	Revision Description	By	App.	Date
P1	PRELIMINARY ISSUE	CR	NF	07.09.07					
A1	OPERATIONAL WORKS APPROVAL	CR	NF	11.09.07					
P2	UPDATED LAYOUTS - PRELIM ISSUE	SJ	BR	16.10.07					
T1	ISSUE FOR TENDER	AW	CR	22.10.07					
T2	ISSUE FOR TENDER	AW	CR	27.11.07					
P3	ISSUE FOR DISCUSSION	JJ	CR	12.02.08					
C1	APPROVED FOR CONSTRUCTION	AW	CR	15.02.08					
P4	ISSUE FOR DISCUSSION	JP	CR	26.03.08					
C2	ISSUE FOR CONSTRUCTION	AW	CR	19.08.08					

Structural & Civil Engineering Consultant
Robert Bird Group
Brisbane Office:
Robert Bird Group Pty Ltd
PO Box 7035, Riverside Centre,
Brisbane, QLD 4001
Level 16 ANZ Centre
324 Queen St, Brisbane QLD
Ph: (07) 3311 2777
Fax: (07) 3311 2706
A/C: 11 16 340 341
Web Site: www.robertbird.com

Client
QUINN GROUP

Title
SITWORKS LAYOUT PLAN
SHEET 4 OF 5
Project
OC @ EXIT 35

APPROVED FOR CONSTRUCTION			
Date 07.09.07	Design CR	Checked ---	
Scale @ A1 1:250	Drawn GF	Approved ---	
Job Number 07365	Drawing Number C3-04	Revision C2	

LOGAN CITY COUNCIL

APPROVED PLAN OF DEVELOPMENT

This is the approved plan of development for Development Application


MCUI/43/2016/B

LEGEND

- SITE BOUNDARY
- 2.50- EXISTING CONTOURS
- EXTENT OF WORKS
- ▨ PROPOSED RETAINING WALL
- K&C BARRIER KERB AND CHANNEL
- KO BARRIER KERB ONLY
- EXISTING KERB & CHANNEL
- +F9.60 FINISHED PAVEMENT LEVEL
- GUARD RAIL

NOTE

REFER DRG. No. C3-01 FOR NOTES.

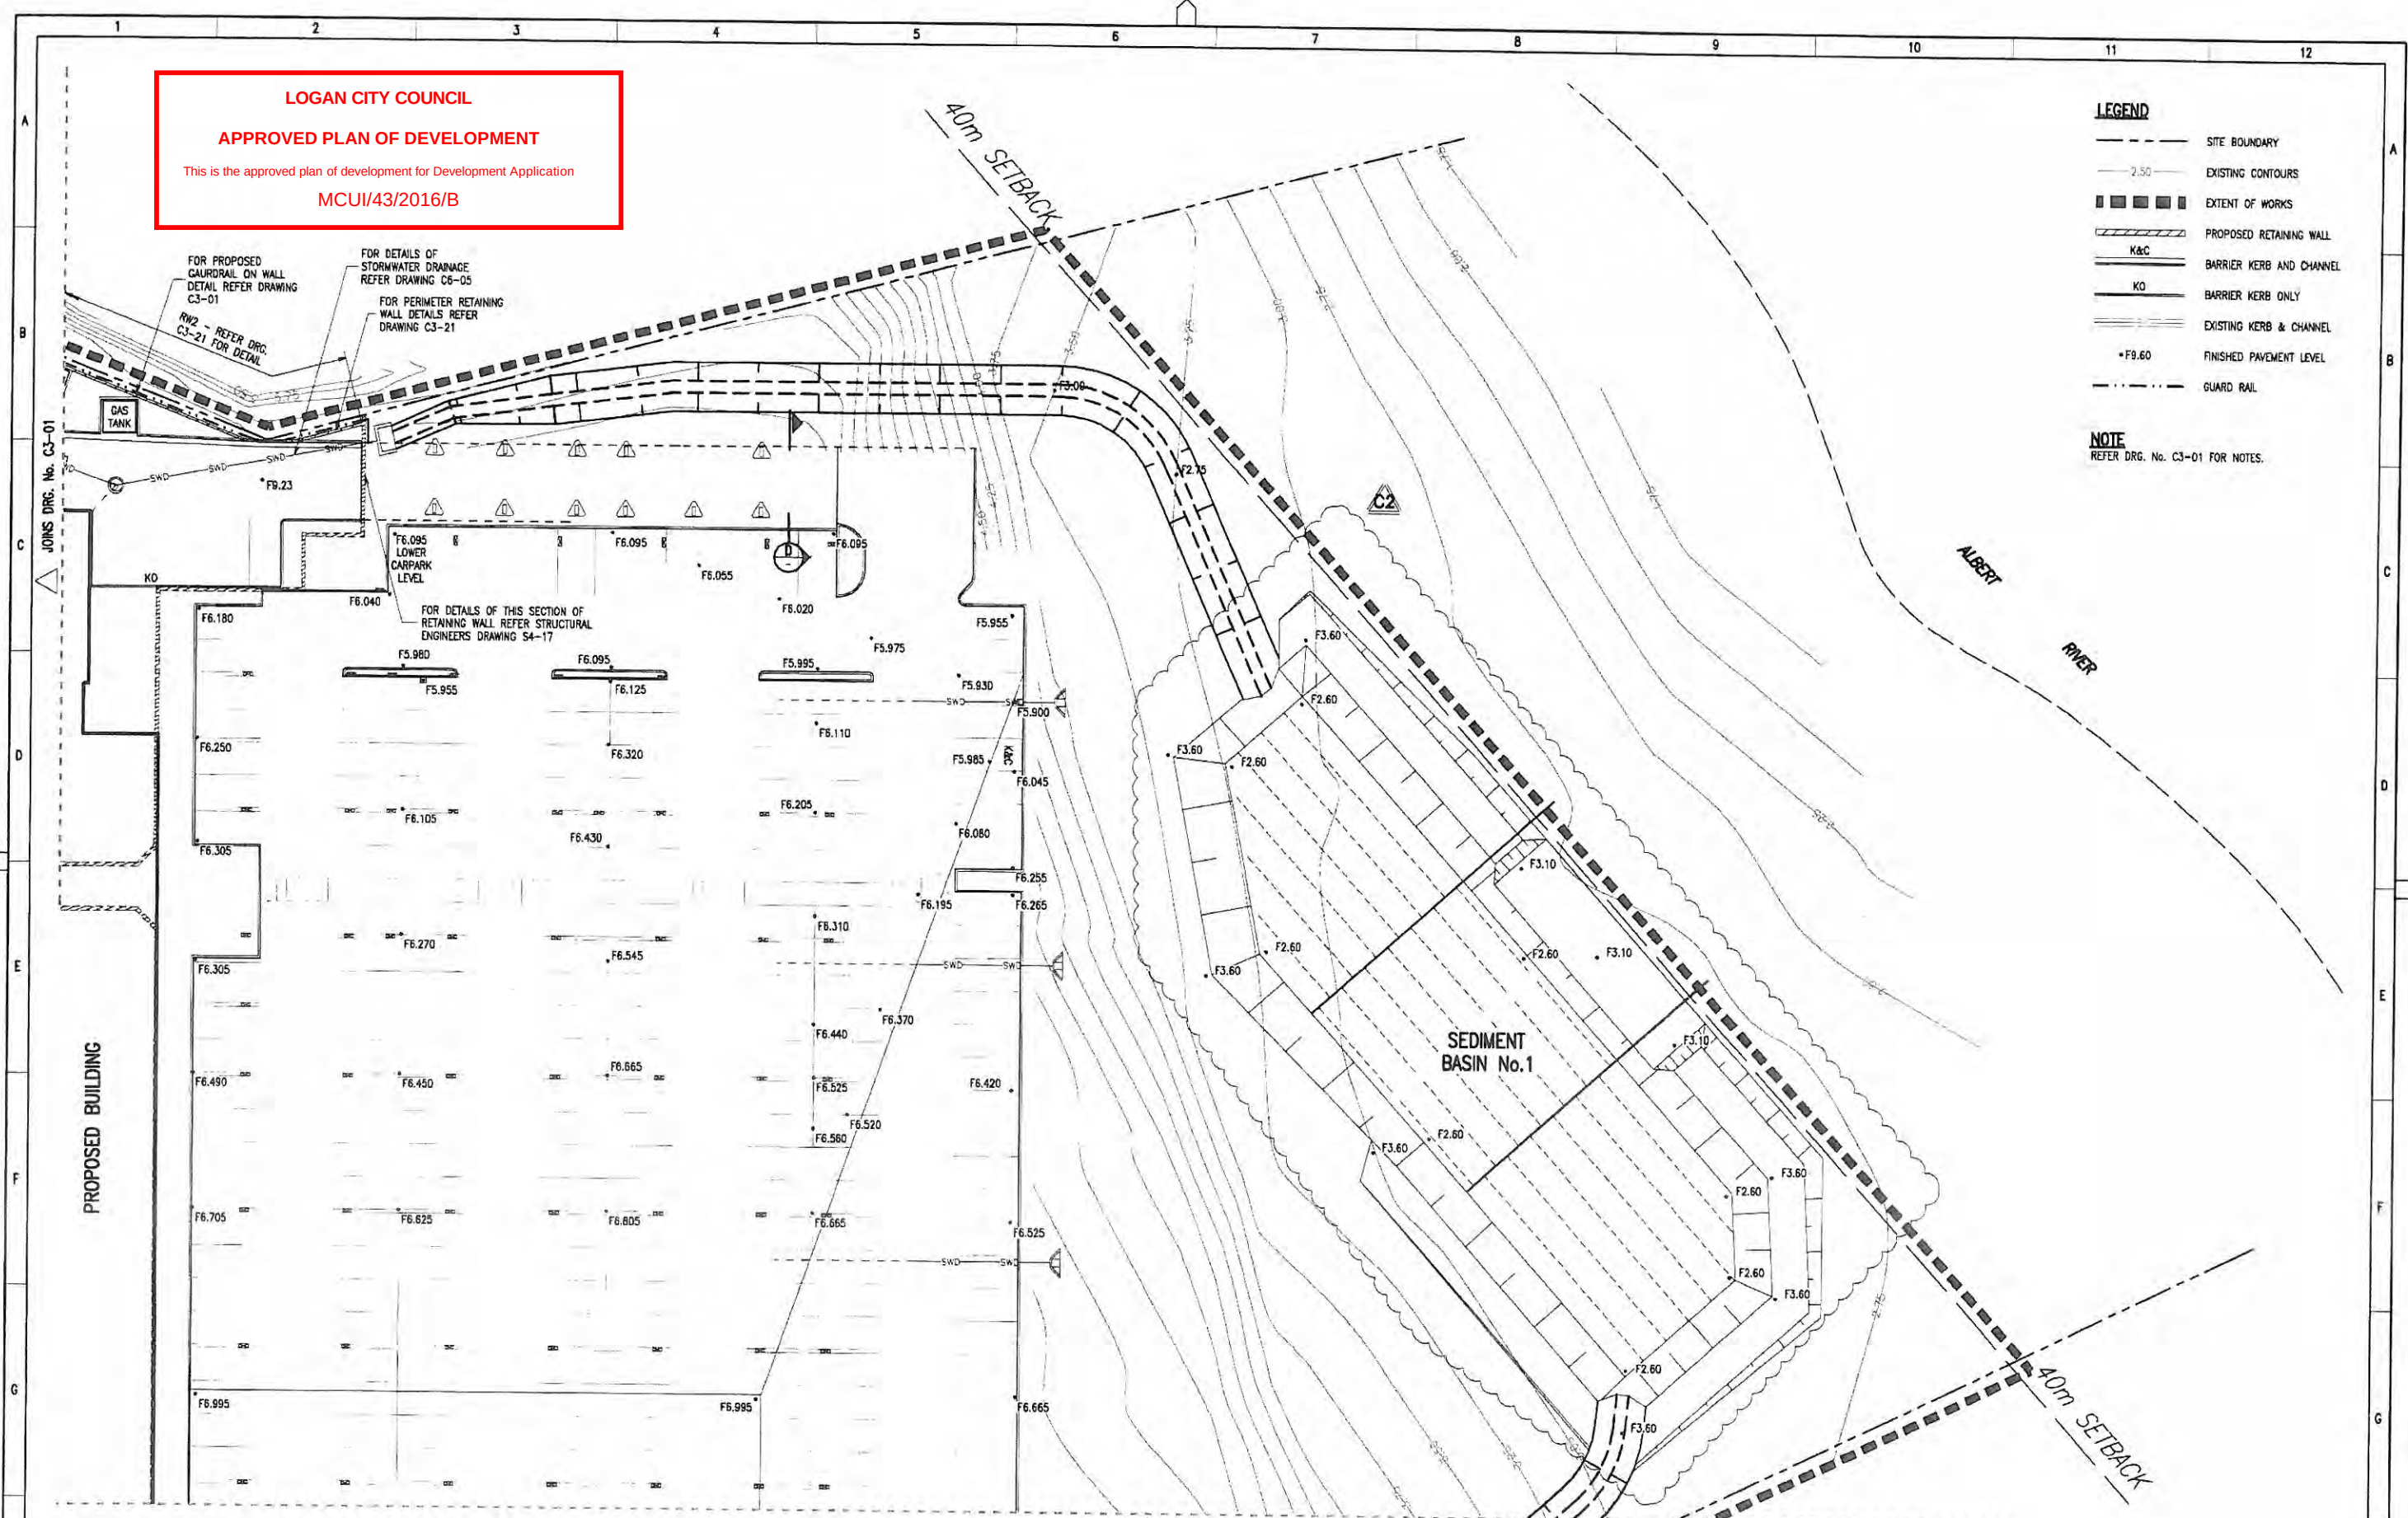

DO NOT SCALE DRAWINGS. USE FIGURED DIMENSIONS
REFER COVER SHEET FOR NOTES UNLESS NOTED OTHERWISE

SCALE 1:250
0 5 10 15 m

Rev.	Revision Description	By	App.	Date	Rev.	Revision Description	By	App.	Date
P1	PRELIMINARY ISSUE	CR	NF	07.09.07					
A1	OPERATIONAL WORKS APPROVAL	CR	NF	11.09.07					
P2	UPDATED LAYOUTS - PRELIM ISSUE	SJ	BR	16.10.07					
T1	ISSUE FOR TENDER	AW	CR	22.10.07					
P3	FOR INFORMATION	AW	CR	06.02.08					
P4	FOR DISCUSSION	JJ	CR	12.02.08					
C1	APPROVED FOR CONSTRUCTION	AW	CR	15.02.08					
C2	ISSUE FOR CONSTRUCTION	AW	CR	21.04.08					

Structural & Civil
Engineering Consultant



Robert Bird Group

BRISBANE OFFICE:
Robert Bird Group Pty Ltd
PO Box 2025, Riverside Centre,
Brisbane, QLD 4001
Level 16 AML Centre
294 Queen St, Brisbane QLD
Ph: (07) 3310 2777
Fax: (07) 3310 2700


Client
QUINN GROUP

Title
SITEWORKS LAYOUT PLAN
SHEET 5 OF 5

Project
OC @ EXIT 35

APPROVED FOR CONSTRUCTION		
Date 07.09.07	Design CR	Checked ---
Scale @ A1 1:250	Drawn GF	Approved ---
Job Number 07365	Drawing Number C3-05	Revision C2

1. ALL MASONRY SHALL COMPLY WITH AS3700 AND THE PROJECT SPECIFICATION.
2. CONCRETE MASONRY UNITS TO HAVE A MINIMUM CHARACTERISTIC UNCONFINED STRENGTH OF 15MPa IN ACCORDANCE WITH AS2733.
3. MASONRY UNITS TO BE BEDDED IN FRESHLY PREPARED MORTAR UNIFORMLY MIXED IN THE RATIO OF ONE (1) PART CEMENT, ONE (1) PART LIME AND SIX (6) PARTS SAND, CONFORMING TO AS2701 'BRICKIES LOAM' SHALL NOT BE USED.
4. GROUT SHALL HAVE A COMPRESSIVE STRENGTH (f'c) OF 20 MPa AT 28DAYS, A SLUMP OF 125mm IN A 150mm SLUMP CONE, A MAXIMUM AGGREGATE SIZE OF 10mm AND BE IN ACCORDANCE WITH AS3700.
5. DEFORMED BAR REINFORCEMENT SHALL CONFORM TO AS4671.
6. EXTREME CARE MUST BE TAKEN TO CORRECTLY POSITION STARTER BARS IN FOOTINGS IN ACCORDANCE WITH DETAILS.
7. REFER TO THE MASONRY DRAWINGS FOR DETAILS ON VERTICAL CONTROL JOINTS.
8. ALL WALL INTERSECTIONS SHALL BE FULLY BONDED OR TIED UNLESS NOTED OTHERWISE.
9. PROVIDE CLEAN-OUT OPENINGS TO ALL CORES FOR INSPECTION AND TYING OF REINFORCEMENT.
10. FACE SHELLS AND CROSS WEBS TO BE FULLY BEDDED.
11. ALL CORES TO BE CLEANED OUT AFTER EACH DAYS LAYING.
12. VERTICAL WALL REINFORCEMENT SHALL BE TIED TO STARTER BARS AND RESTRAINED AT TOP OF WALL IN ITS REQUIRED LOCATION IN ACCORDANCE WITH THE DETAILS SO AS NOT TO MOVE DURING GROUT FILLING OF THE WALL.
13. WET ALL CORES PRIOR TO POURING GROUT.
14. FULLY GROUT ALL CORES IN REINFORCED WALLS, UNLESS NOTED OTHERWISE.
15. GROUT TO BE THOROUGHLY COMPACTED TO ENSURE COMPLETE FILLING OF ALL CORES.
16. FILL CORES TO A MAXIMUM OF 3m IN HEIGHT FOR ANY ONE POUR, ALL GROUT POURS TO STOP 25mm BELOW TOP OF BLOCKS.
17. WALL SHALL BE PROPPED DURING BACKFILLING OPERATIONS.
18. UNLESS NOTED OR SHOWN OTHERWISE ON THE DRAWINGS THERE ARE TO BE NO CHASES OR RECESSES PERMITTED IN THE MASONRY WALLS WITHOUT THE PRIOR APPROVAL OF 'ROBERT BIRD GROUP'.
19. USE OF 'H' BLOCKS ARE PREFERRED FOR RETAINING WALL CONSTRUCTION.

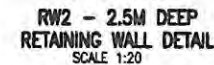


RETAINING BLOCKWORK CONTROL JOINT
- BCJ AT 45 DEGREES CORNER
(REINFORCED)
SCALE 1:20



MCUI/43/2016/B

1			2			3			4			5			6			7			8			9			10			11			12		
10	20	30	40	50	60	70	80	90	100	110	120	130	140	150																					

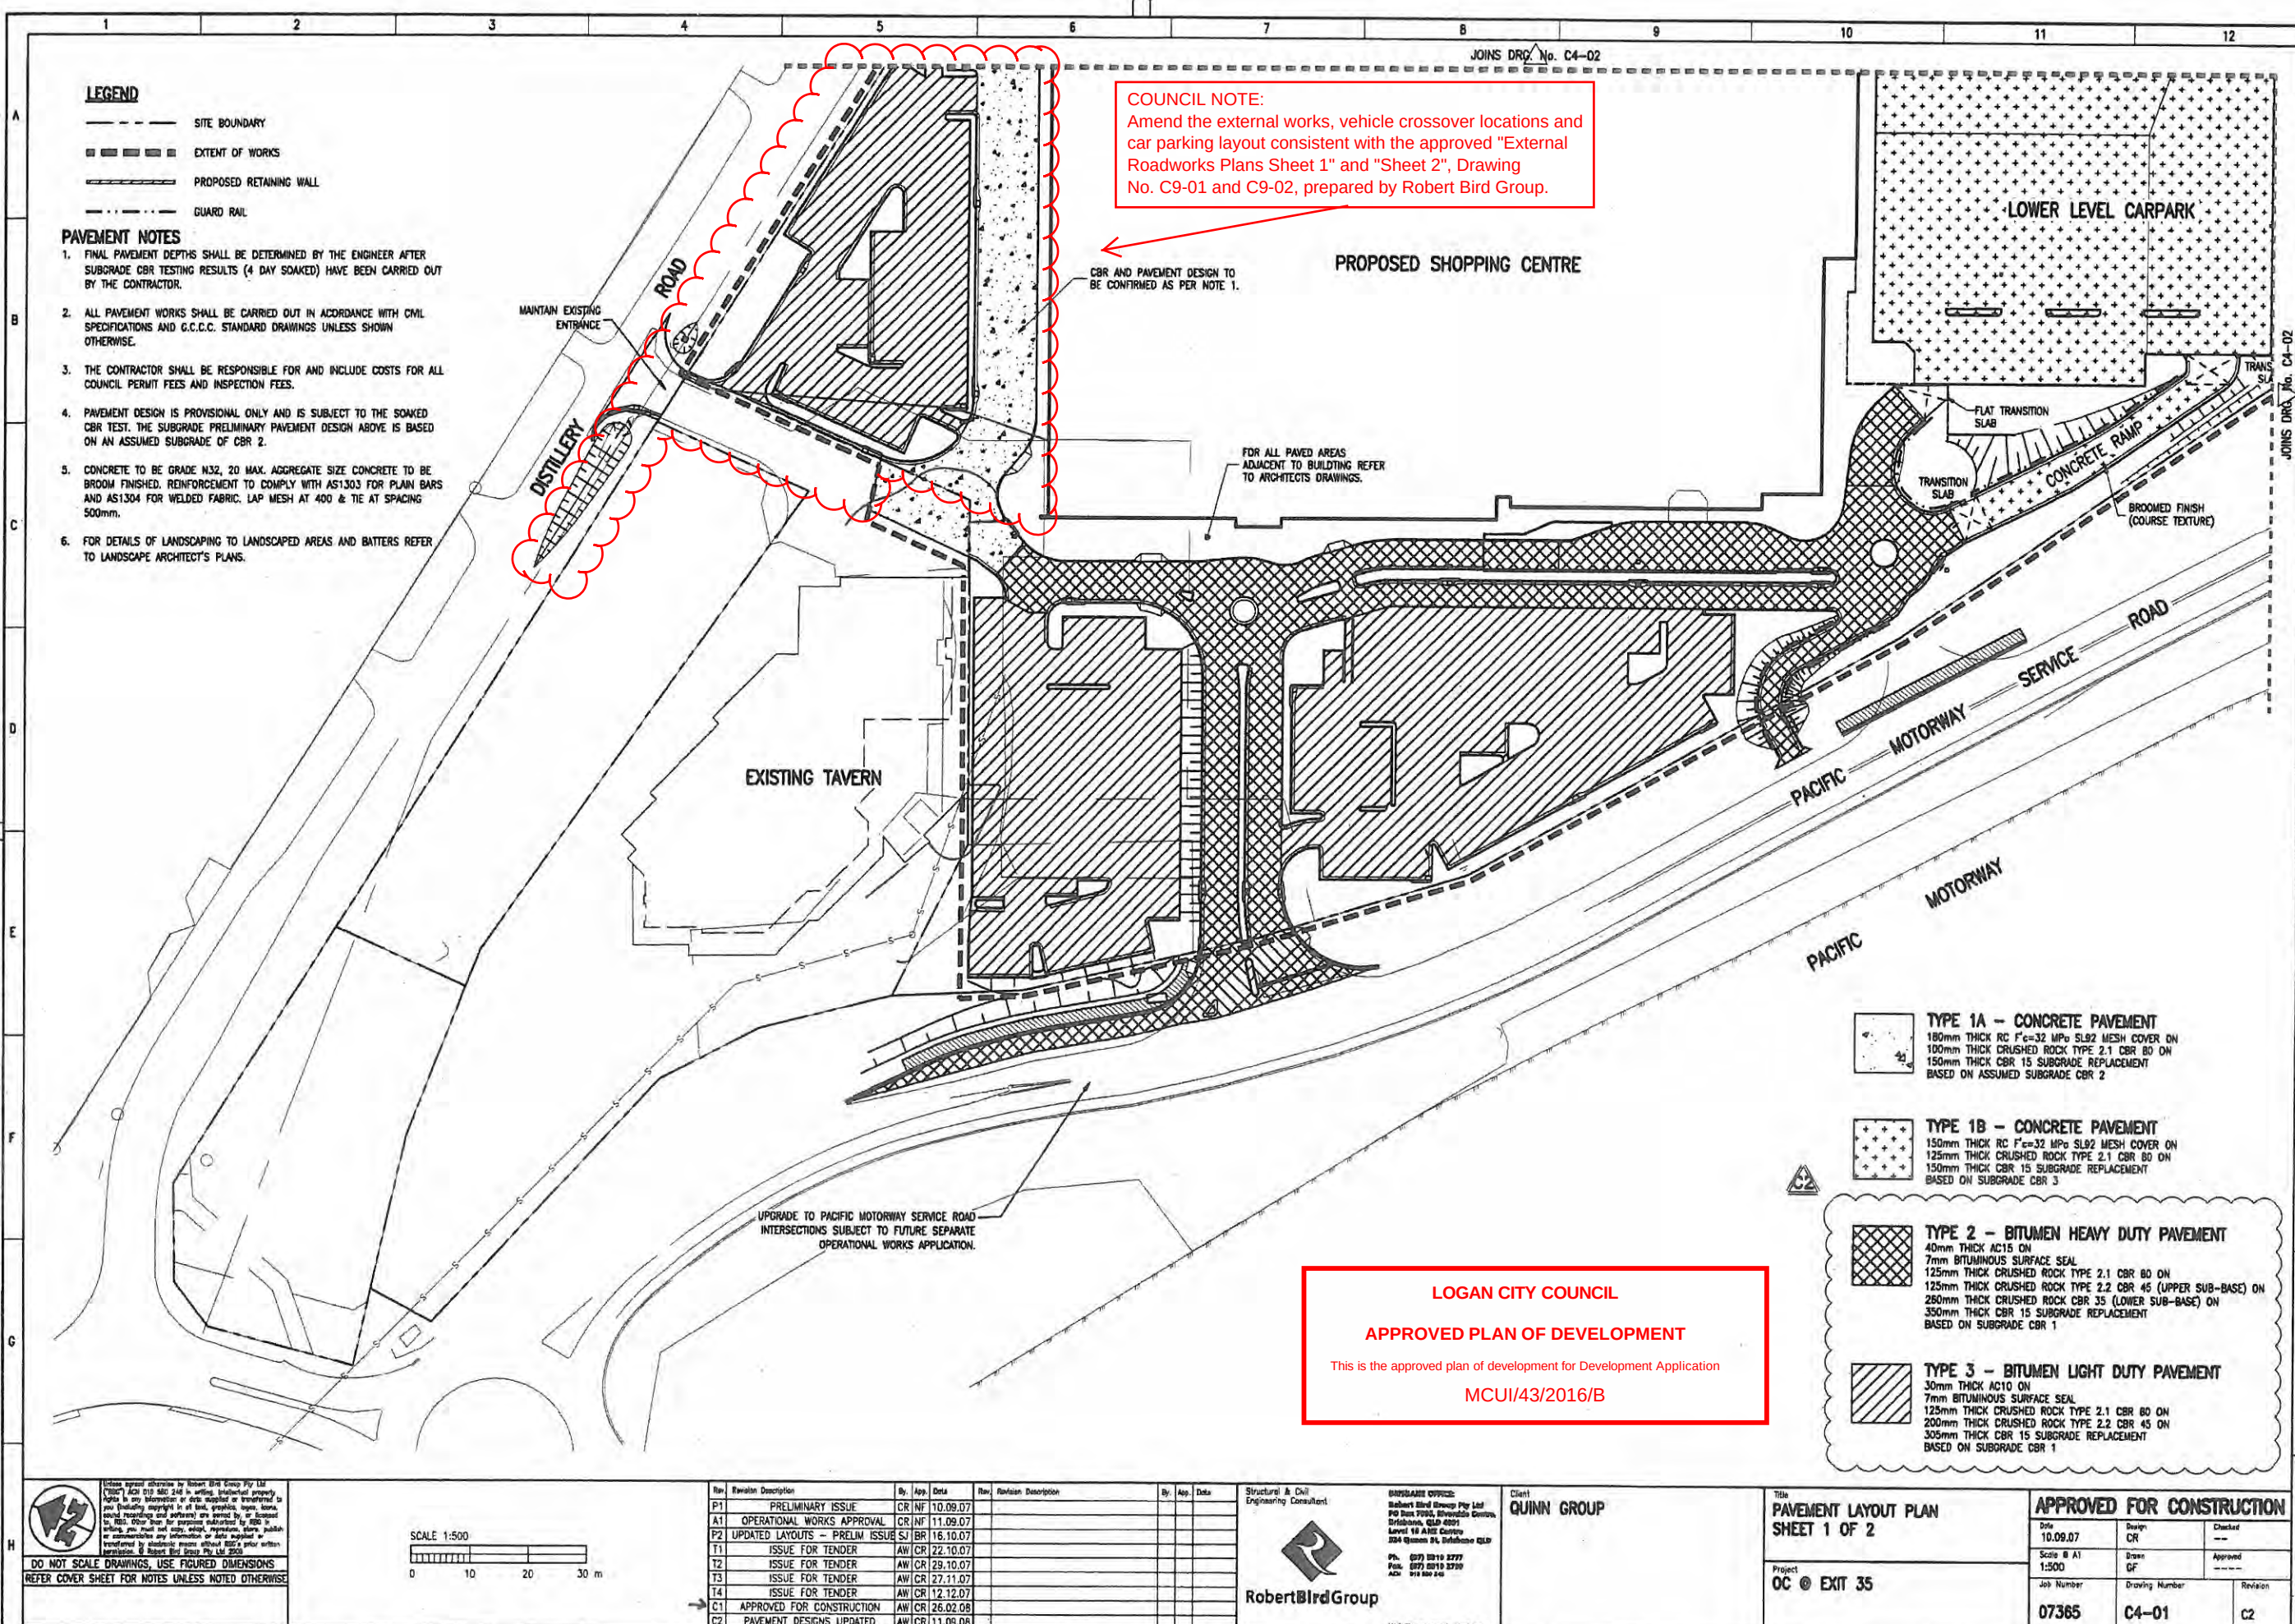

COUNCIL NOTE:
Amend the external works, vehicle crossover locations and car parking layout consistent with the approved "External Roadworks Plans Sheet 1" and "Sheet 2", Drawing No. C9-01 and C9-02, prepared by Robert Bird Group.

LEGEND

- SITE BOUNDARY
- EXTENT OF WORKS
- PROPOSED RETAINING WALL
- GUARD RAIL

PAVEMENT NOTES

1. FINAL PAVEMENT DEPTHS SHALL BE DETERMINED BY THE ENGINEER AFTER SUBGRADE CBR TESTING RESULTS (4 DAY SOAKED) HAVE BEEN CARRIED OUT BY THE CONTRACTOR.
2. ALL PAVEMENT WORKS SHALL BE CARRIED OUT IN ACCORDANCE WITH CIVIL SPECIFICATIONS AND G.C.C.C. STANDARD DRAWINGS UNLESS SHOWN OTHERWISE.
3. THE CONTRACTOR SHALL BE RESPONSIBLE FOR AND INCLUDE COSTS FOR ALL COUNCIL PERMIT FEES AND INSPECTION FEES.
4. PAVEMENT DESIGN IS PROVISIONAL ONLY AND IS SUBJECT TO THE SOAKED CBR TEST. THE SUBGRADE PRELIMINARY PAVEMENT DESIGN ABOVE IS BASED ON AN ASSUMED SUBGRADE OF CBR 2.
5. CONCRETE TO BE GRADE N32, 20 MAX. AGGREGATE SIZE CONCRETE TO BE BROOM FINISHED. REINFORCEMENT TO COMPLY WITH AS1303 FOR PLAIN BARS AND AS1304 FOR WELDED FABRIC. LAP MESH AT 400 & TIE AT SPACING 500mm.
6. FOR DETAILS OF LANDSCAPING TO LANDSCAPED AREAS AND BATTERS REFER TO LANDSCAPE ARCHITECT'S PLANS.

PROPOSED SHOPPING CENTRE

CBR AND PAVEMENT DESIGN TO BE CONFIRMED AS PER NOTE 1.

FOR ALL PAVED AREAS ADJACENT TO BUILDING REFER TO ARCHITECTS DRAWINGS.

EXISTING TAVERN

UPGRADE TO PACIFIC MOTORWAY SERVICE ROAD INTERSECTIONS SUBJECT TO FUTURE SEPARATE OPERATIONAL WORKS APPLICATION.

LOWER LEVEL CARPARK

FLAT TRANSITION SLAB

TRANSITION SLAB

CONCRETE RAMP

BROOMED FINISH (COARSE TEXTURE)

ROAD

PACIFIC MOTORWAY

PACIFIC MOTORWAY

LOGAN CITY COUNCIL

APPROVED PLAN OF DEVELOPMENT

This is the approved plan of development for Development Application

MCUI/43/2016/B


TYPE 1A - CONCRETE PAVEMENT
180mm THICK RC Fc=32 MPa SL92 MESH COVER DN
100mm THICK CRUSHED ROCK TYPE 2.1 CBR 80 DN
150mm THICK CBR 15 SUBGRADE REPLACEMENT
BASED ON ASSUMED SUBGRADE CBR 2

TYPE 1B - CONCRETE PAVEMENT
150mm THICK RC Fc=32 MPa SL92 MESH COVER DN
125mm THICK CRUSHED ROCK TYPE 2.1 CBR 80 DN
150mm THICK CBR 15 SUBGRADE REPLACEMENT
BASED ON SUBGRADE CBR 3

TYPE 2 - BITUMEN HEAVY DUTY PAVEMENT
40mm THICK AC15 ON
7mm BITUMINOUS SURFACE SEAL
125mm THICK CRUSHED ROCK TYPE 2.1 CBR 80 DN
125mm THICK CRUSHED ROCK TYPE 2.2 CBR 45 (UPPER SUB-BASE) ON
250mm THICK CRUSHED ROCK CBR 35 (LOWER SUB-BASE) ON
350mm THICK CBR 15 SUBGRADE REPLACEMENT
BASED ON SUBGRADE CBR 1

TYPE 3 - BITUMEN LIGHT DUTY PAVEMENT
30mm THICK AC10 ON
7mm BITUMINOUS SURFACE SEAL
125mm THICK CRUSHED ROCK TYPE 2.1 CBR 80 DN
200mm THICK CRUSHED ROCK TYPE 2.2 CBR 45 ON
305mm THICK CBR 15 SUBGRADE REPLACEMENT
BASED ON SUBGRADE CBR 1

DO NOT SCALE DRAWINGS, USE FIGURED DIMENSIONS
REFER COVER SHEET FOR NOTES UNLESS NOTED OTHERWISE

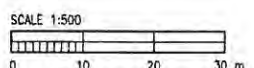

Rev	Revision Description	By	App	Date	Rev	Revision Description	By	App	Date
P1	PRELIMINARY ISSUE	CR	NF	10.09.07					
A1	OPERATIONAL WORKS APPROVAL	CR	NF	11.09.07					
P2	UPDATED LAYOUTS - PRELIM ISSUE	SJ	BR	16.10.07					
T1	ISSUE FOR TENDER	AW	CR	22.10.07					
T2	ISSUE FOR TENDER	AW	CR	29.10.07					
T3	ISSUE FOR TENDER	AW	CR	27.11.07					
T4	ISSUE FOR TENDER	AW	CR	12.12.07					
C1	APPROVED FOR CONSTRUCTION	AW	CR	26.02.08					
C2	PAVEMENT DESIGNS UPDATED	AW	CR	11.08.08					

Structural & Civil
Engineering Consultant
Robert Bird Group

UNDEVELOPED OFFICE:
Robert Bird Group Pty Ltd
PO Box 7090, Riverside Centre,
Brisbane, QLD 4001
Level 10 A105 Centre
204 Queen St, Brisbane QLD
Ph: (07) 3210 2777
Fax: (07) 3210 3750
ACH: 911 800 240

Client
QUINN GROUP

Title
**PAVEMENT LAYOUT PLAN
SHEET 1 OF 2**

Project
OC @ EXIT 35

APPROVED FOR CONSTRUCTION

Date 10.09.07	Design CR	Checked ---
Scale @ A1 1:500	Drawn GF	Approved ---
Job Number 07365	Drawing Number C4-01	Revision C2

LEGEND

- SITE BOUNDARY
- - - - - EXTENT OF WORKS
- ===== PROPOSED RETAINING WALL
- - - - - GUARD RAIL

COUNCIL NOTE:

Amend the external works, vehicle crossover locations and car parking layout consistent with the approved "External Roadworks Plans Sheet 1" and "Sheet 2", Drawing No. C9-01 and C9-02, prepared by Robert Bird Group.

TYPE 1A - CONCRETE PAVEMENT
180mm THICK RC F_c=32 MPa SL92 MESH COVER ON
100mm THICK CRUSHED ROCK TYPE 2.1 CBR 80 ON
150mm THICK CBR 15 SUBGRADE REPLACEMENT
BASED ON ASSUMED SUBGRADE CBR 2

TYPE 1B - CONCRETE PAVEMENT
150mm THICK RC F_c=32 MPa SL92 MESH COVER ON
125mm THICK CRUSHED ROCK TYPE 2.1 CBR 80 ON
150mm THICK CBR 15 SUBGRADE REPLACEMENT
BASED ON SUBGRADE CBR 3

TYPE 2 - BITUMEN HEAVY DUTY PAVEMENT
40mm THICK AC 15 ON
7mm BITUMINOUS SURFACE SEAL
125mm THICK CRUSHED ROCK TYPE 2.1 CBR 80 ON
100mm THICK CRUSHED ROCK TYPE 2.2 CBR 45 ON
350mm THICK CBR 15 SUBGRADE REPLACEMENT
BASED ON ASSUMED SUBGRADE CBR 2

TYPE 3 - BITUMEN LIGHT DUTY PAVEMENT
30mm THICK AC10 ON
7mm BITUMINOUS SURFACE SEAL
100mm THICK CRUSHED ROCK TYPE 2.1 CBR 80 ON
100mm THICK CRUSHED ROCK TYPE 2.2 CBR 45 ON
250mm THICK CBR 15 SUBGRADE REPLACEMENT
BASED ON ASSUMED SUBGRADE CBR 2

TYPE 4 - CONCRETE PAVEMENT (GAS TANK SLAB)
125mm THICK RC F_c=32 MPa SL72 MESH COVER
WITH 250mm WIDE/DEEP THICKENING AT THE EDGE

PROPOSED SHOPPING CENTRE

LOWER LEVEL CARPARK

SUSPENDED CONCRETE RAMP

FLAT TRANSITION SLAB

TRANSITION SLAB

CONCRETE RAMP

TRANSITION SLAB


BROOMED FINISH (COARSE TEXTURE)

LOGAN CITY COUNCIL

APPROVED PLAN OF DEVELOPMENT


This is the approved plan of development for Development Application

MCUI/43/2016/B

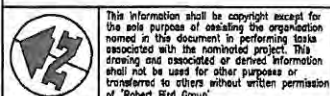

DO NOT SCALE DRAWINGS, USE FIGURED DIMENSIONS
REFER COVER SHEET FOR NOTES UNLESS NOTED OTHERWISE

SCALE 1:500

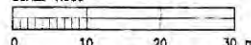

Rev.	Revision Description	By	App.	Date	Rev.	Revision Description	By	App.	Date
P1	PRELIMINARY ISSUE	CR	NF	10.09.07					
A1	OPERATIONAL WORKS APPROVAL	CR	NF	11.09.07					
P2	UPDATED LAYOUTS - PRELIM ISSUE	SJ	BR	16.10.07					
T1	ISSUE FOR TENDER	AW	CR	22.10.07					
T2	ISSUE FOR TENDER	AW	CR	27.11.07					
T3	ISSUE FOR TENDER	AW	CR	12.12.07					
C1	APPROVED FOR CONSTRUCTION	AW	CR	26.02.08					
C2	GAS SLAB AND RAMP ADDED	AW	CR	11.06.08					

Structural & Civil
Engineering Consultant



Robert Bird Group

BRISBANE OFFICE:
Robert Bird Group Pty Ltd
PO Box 7035, Riverside Centre,
Brisbane, QLD 4001
Level 16 ANZ Centre
324 Queen St, Brisbane QLD

Ph. (07) 3316 2772
Fax. (07) 3316 2798

Web: www.rbirdgroup.com

Client
QUINN GROUP

Title
PAVEMENT LAYOUT PLAN
SHEET 2 OF 2

Project
OC @ EXIT 35

APPROVED FOR CONSTRUCTION

Date 10.09.07	Design CR	Checked ---
Scale @ A1 1:500	Drawn GF	Approved ---
Job Number 07365	Drawing Number C4-02	Revision C2




GENERAL NOTES

- ALL DIMENSIONS AND SETOUT SHALL BE VERIFIED BY THE SUPERINTENDENT PRIOR TO CONSTRUCTION.
- THE PAVEMENT SUBGRADE SHALL BE TRIMMED TO THE REQUIRED PROFILES AND COMPACTED IN ACCORDANCE WITH THE CIVIL SPECIFICATION.
- TRIMMER REINFORCEMENT TO BE PROVIDED AT CORNERS, GULLY PITS ETC. TO PREVENT CORNER CRACKS DEVELOPING.
- FOR PAVEMENT MAKE UP REFER TO DRAWING C4-02.
- REINFORCEMENT SHALL BE AS SPECIFIED ON THE DRAWINGS AND SHALL BE CHAIRED AT 1000 C/C BOTH WAYS TO GIVE TOP COVER. FOR SMOOTH FINISH SURFACE ADOPT 40 TOP COVER AND FOR EXPOSED AGGREGATE SURFACE ADOPT 50 TOP COVER.
- CONCRETE USED IN PAVEMENT CONSTRUCTION SHALL CONFORM TO THE FOLLOWING REQUIREMENTS:
 - CONCRETE TO BE IN ACCORDANCE WITH AS3600
 - CEMENT TO BE TYPE A ORDINARY CEMENT SLUMP TO BE 80MM (+/- 15MM)
 - AGGREGATE TO BE CLEAN WITH A MAXIMUM SIZE OF 20MM
 - CONCRETE SHALL BE GRADE S32 MPa MINIMUM
 - CONCRETE TO BE MECHANICALLY VIBRATED. THE VIBRATOR SHALL NOT BE USED TO SPREAD THE CONCRETE.
 - CONCRETE PAVEMENT SHALL NOT BE CONSTRUCTED IN THE NARROW POINTED RE-ENTRANT AREAS I.E. THE CONCRETE SLAB SHALL BE FINISHED NEATLY SO THAT THE MINIMUM SLAB WIDTH IS 300MM.
 - SLABS TO BE POURED IN ALTERNATE BAYS 24 HOURS APART.
 - SUB-BASE COMPACTION AND REINFORCEMENT SHALL BE CHECKED BY THE SUPERINTENDENT PRIOR TO PLACING CONCRETE.
- THE CONTRACTOR SHALL CARRY OUT SAMPLING AND TESTING OF CONCRETE IN ACCORDANCE WITH THE PROJECT SPECIFICATION. MINIMUM REQUIREMENT FOR CONCRETE TESTING I.E. COMPRESSIVE, SLUMP TEST AND FLEXURAL STRENGTH TO BE ONE TEST SAMPLE PER 15 CU.M. OF CONCRETE.
- ALL CONTROL JOINTS SHALL BE FINISHED WITH AN APPROVED SEALANT AS FURTHER SPECIFIED BELOW. CONCRETE CONTROL JOINTS AND SAW JOINTS SHALL BE LOCATED WHERE SHOWN ON THE DRAWINGS.
- JOINTS TO BE TOOLED 25MM DEEP WITH 'T' SECTION BAR ON DAY OF POUR AND FOLLOWED WITH SAW CUT BETWEEN 8 AND 16 HOURS AFTER CONCRETE POUR. LOCATION OF CUT MESH TO BE CLEARLY MARKED ON EDGE BOARD PRIOR TO POURING CONCRETE TO ENSURE JOINT IN CORRECT LOCATION. DEPTH OF THE SAW CUT SHALL BE NOT LESS THAN 25% OF THE SLAB DEPTH.
- ALL DOWELS SHALL BE 400mm LONG HOT DIP GALVANISED AT 300C/C TO SUIT 'DANLEY DOWEL-MASTER' DOWEL SLEEVE (U.N.O.).
- ALL WORKS SHALL BE CARRIED OUT IN ACCORDANCE WITH CURRENT DMR STANDARD SPECIFICATION AND STANDARD DRAWINGS.
- JOINTS IN PAVEMENT MEDIANS TO MATCH THE LOCATION OF SLAB JOINTS BELOW.


LEGEND

- U ISOLATION JOINT (U)
- SJ SAWN JOINT (SJ)
- EJ EXPANSION JOINT (EJ)
- EK EDGE KERB
- U&EK ISOLATION JOINT & EDGE KERB


- BRUSH FINISH
- TROWEL FINISH

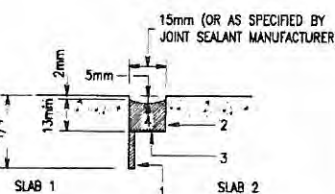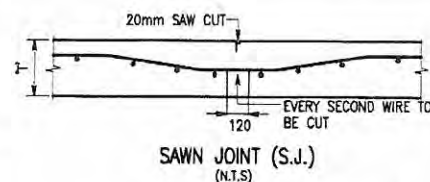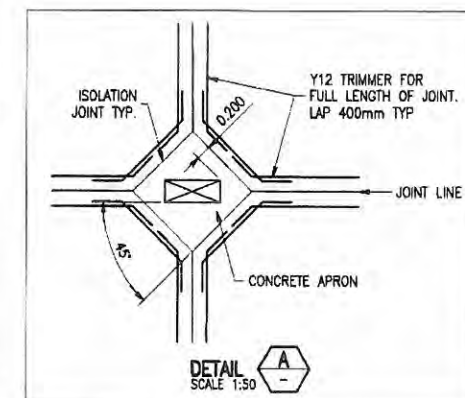




- INITIAL CUT 3-5mm WIDE WITHIN 1 DAY OF POURING TO BE SEALED OFF UNTIL GROOVE WIDENED
- GROOVE WIDENED BY SAW CUTS AFTER SLAB CURING PERIOD. JET WASH OUT AND DRY ALL CUTS BEFORE PRIMING FACES WITH FOSROC PRIMER 10
- BOND BREAKER TAPE
- INSTALL JOINT SEALANT PARBURY EMER-ROADSEAL OR APPROVED EQUIVALENT WITH MOVEMENT ACCOMMODATION FACTOR +/- 50% IN ACCORDANCE WITH MANUFACTURER'S INSTRUCTIONS

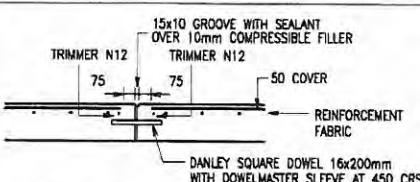



- NOTE: IN ACCORDANCE WITH MANUFACTURERS RECOMMENDATIONS SQUARE DOWEL CRADLES SHOULD NOT BE USED AT EXPANSION JOINTS.

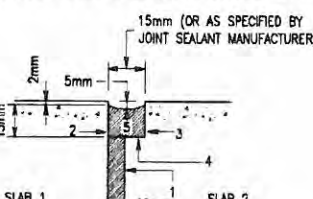

- CLOSED CELL POLYURETHANE FILLER (FULL DEPTH) CUT HOLES IN FILLER TO FIT CLOSELY AROUND DOWELS
- FORM GROOVE IN SLAB 2 AND AGAINST FACE OF SLAB 1
- JET WASH AND DRY GROOVE AFTER SLAB CURING PERIOD. PRIME FACES WITH FOSROC PRIMER 10
- BOND BREAKER TAPE
- INSTALL JOINT SEALANT PARBURY EMER-ROADSEAL OR APPROVED EQUIVALENT WITH MOVEMENT ACCOMMODATION FACTOR +/- 50% IN ACCORDANCE WITH MANUFACTURER'S INSTRUCTIONS

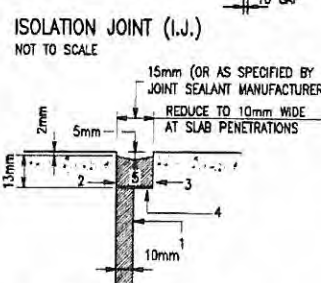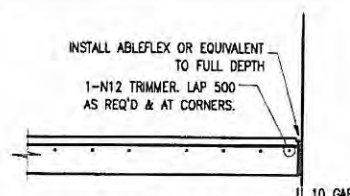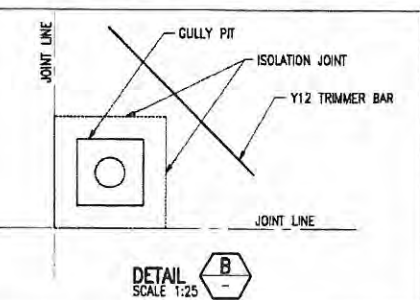

- CLOSED CELL POLYURETHANE FILLER (FULL DEPTH)
- FORM GROOVE IN SLAB AND AGAINST FACE OF STRUCTURE
- PRIME FACES WITH FOSROC PRIMER 10
- BOND BREAKER TAPE
- INSTALL JOINT SEALANT PARBURY EMER-ROADSEAL OR APPROVED EQUIVALENT WITH MOVEMENT ACCOMMODATION FACTOR +/- 50% IN ACCORDANCE WITH MANUFACTURER'S INSTRUCTIONS

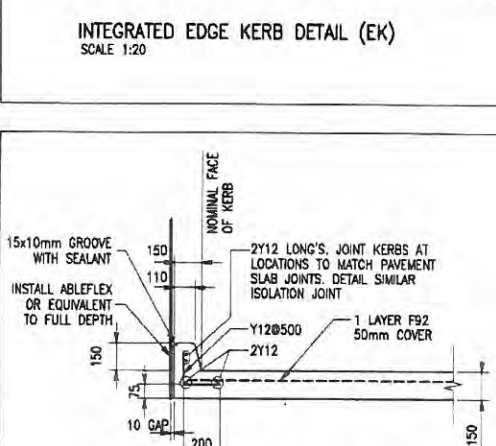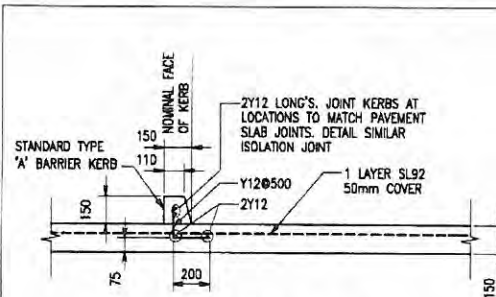


LOGAN CITY COUNCIL


APPROVED PLAN OF DEVELOPMENT

This is the approved plan of development for Development Application

MCUI/43/2016/B

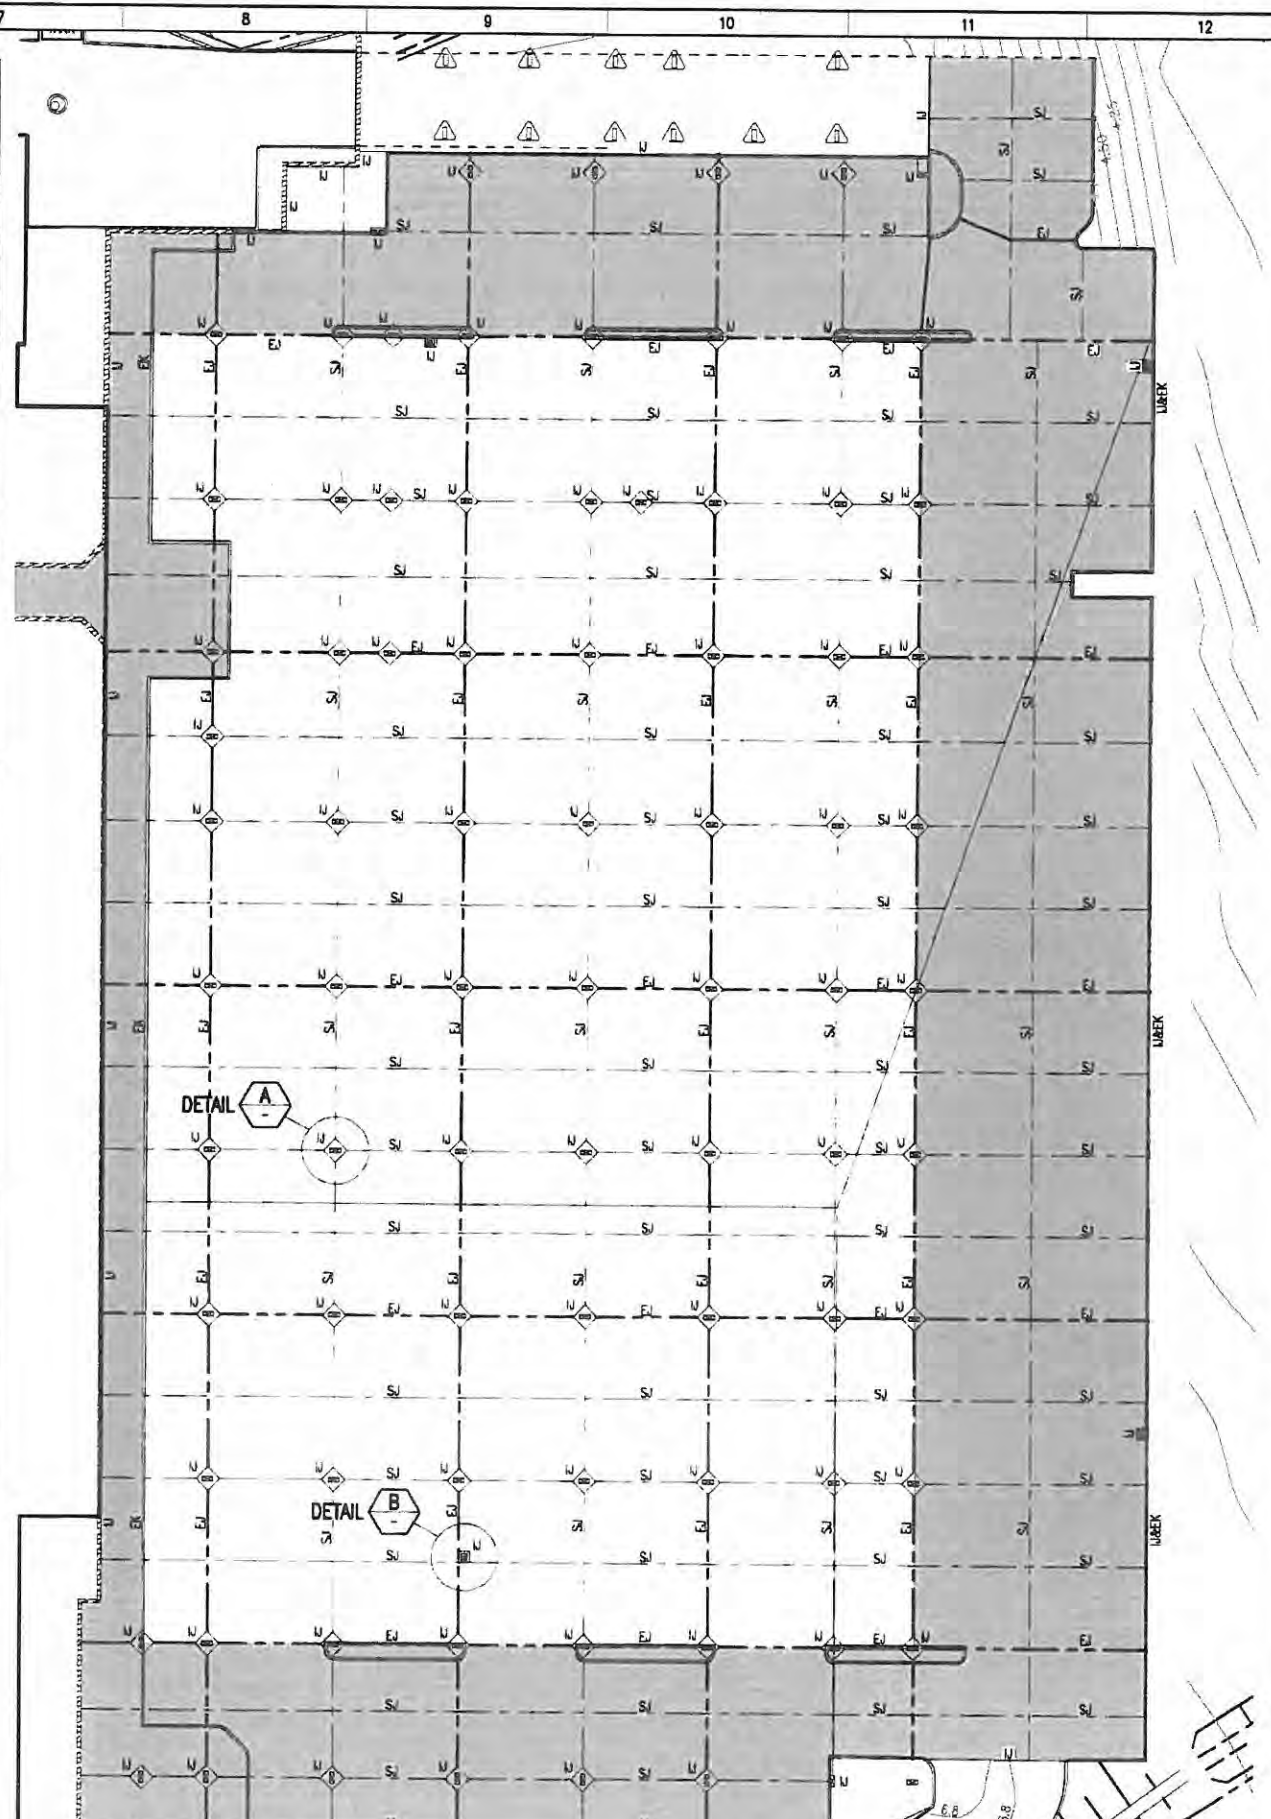

DO NOT SCALE DRAWINGS. USE FIGURED DIMENSIONS. REFER COVER SHEET FOR NOTES UNLESS NOTED OTHERWISE

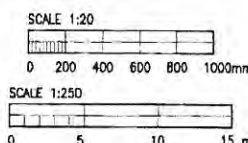

Rev.	Revision Description	By	App.	Date	Rev.	Revision Description	By	App.	Date
P1	ISSUE FOR COMMENT	AW	CR	12.02.08					
P2	ISSUE FOR COMMENT	AW	CR	20.02.08					
C1	ISSUE FOR CONSTRUCTION	AW	CR	26.02.08					
C2	ISSUE FOR CONSTRUCTION	AW	CR	12.03.08					

Structural & Civil Engineering Consultant



Robert Bird Group

BRISBANE OFFICE:
Robert Bird Group Pty Ltd
PO Box 7035, Riverside Centre,
Brisbane, QLD 4001
Level 16 And Centre
324 Queen St, Brisbane QLD

Ph. (07) 3316 2777
Fax. (07) 3316 2709

Web Site: www.rbg.com.au


Client:
QUINN GROUP

Title:
PAVEMENT JOINTING PLAN
SHEET 1 OF 2

Project:
OC @ EXIT 35

APPROVED FOR CONSTRUCTION

Date 12.02.08	Design CR	Checked ---
Scale @ A1 1:250	Drawn AW	Approved ---
Job Number 07365	Drawing Number C4-11	Revision C2

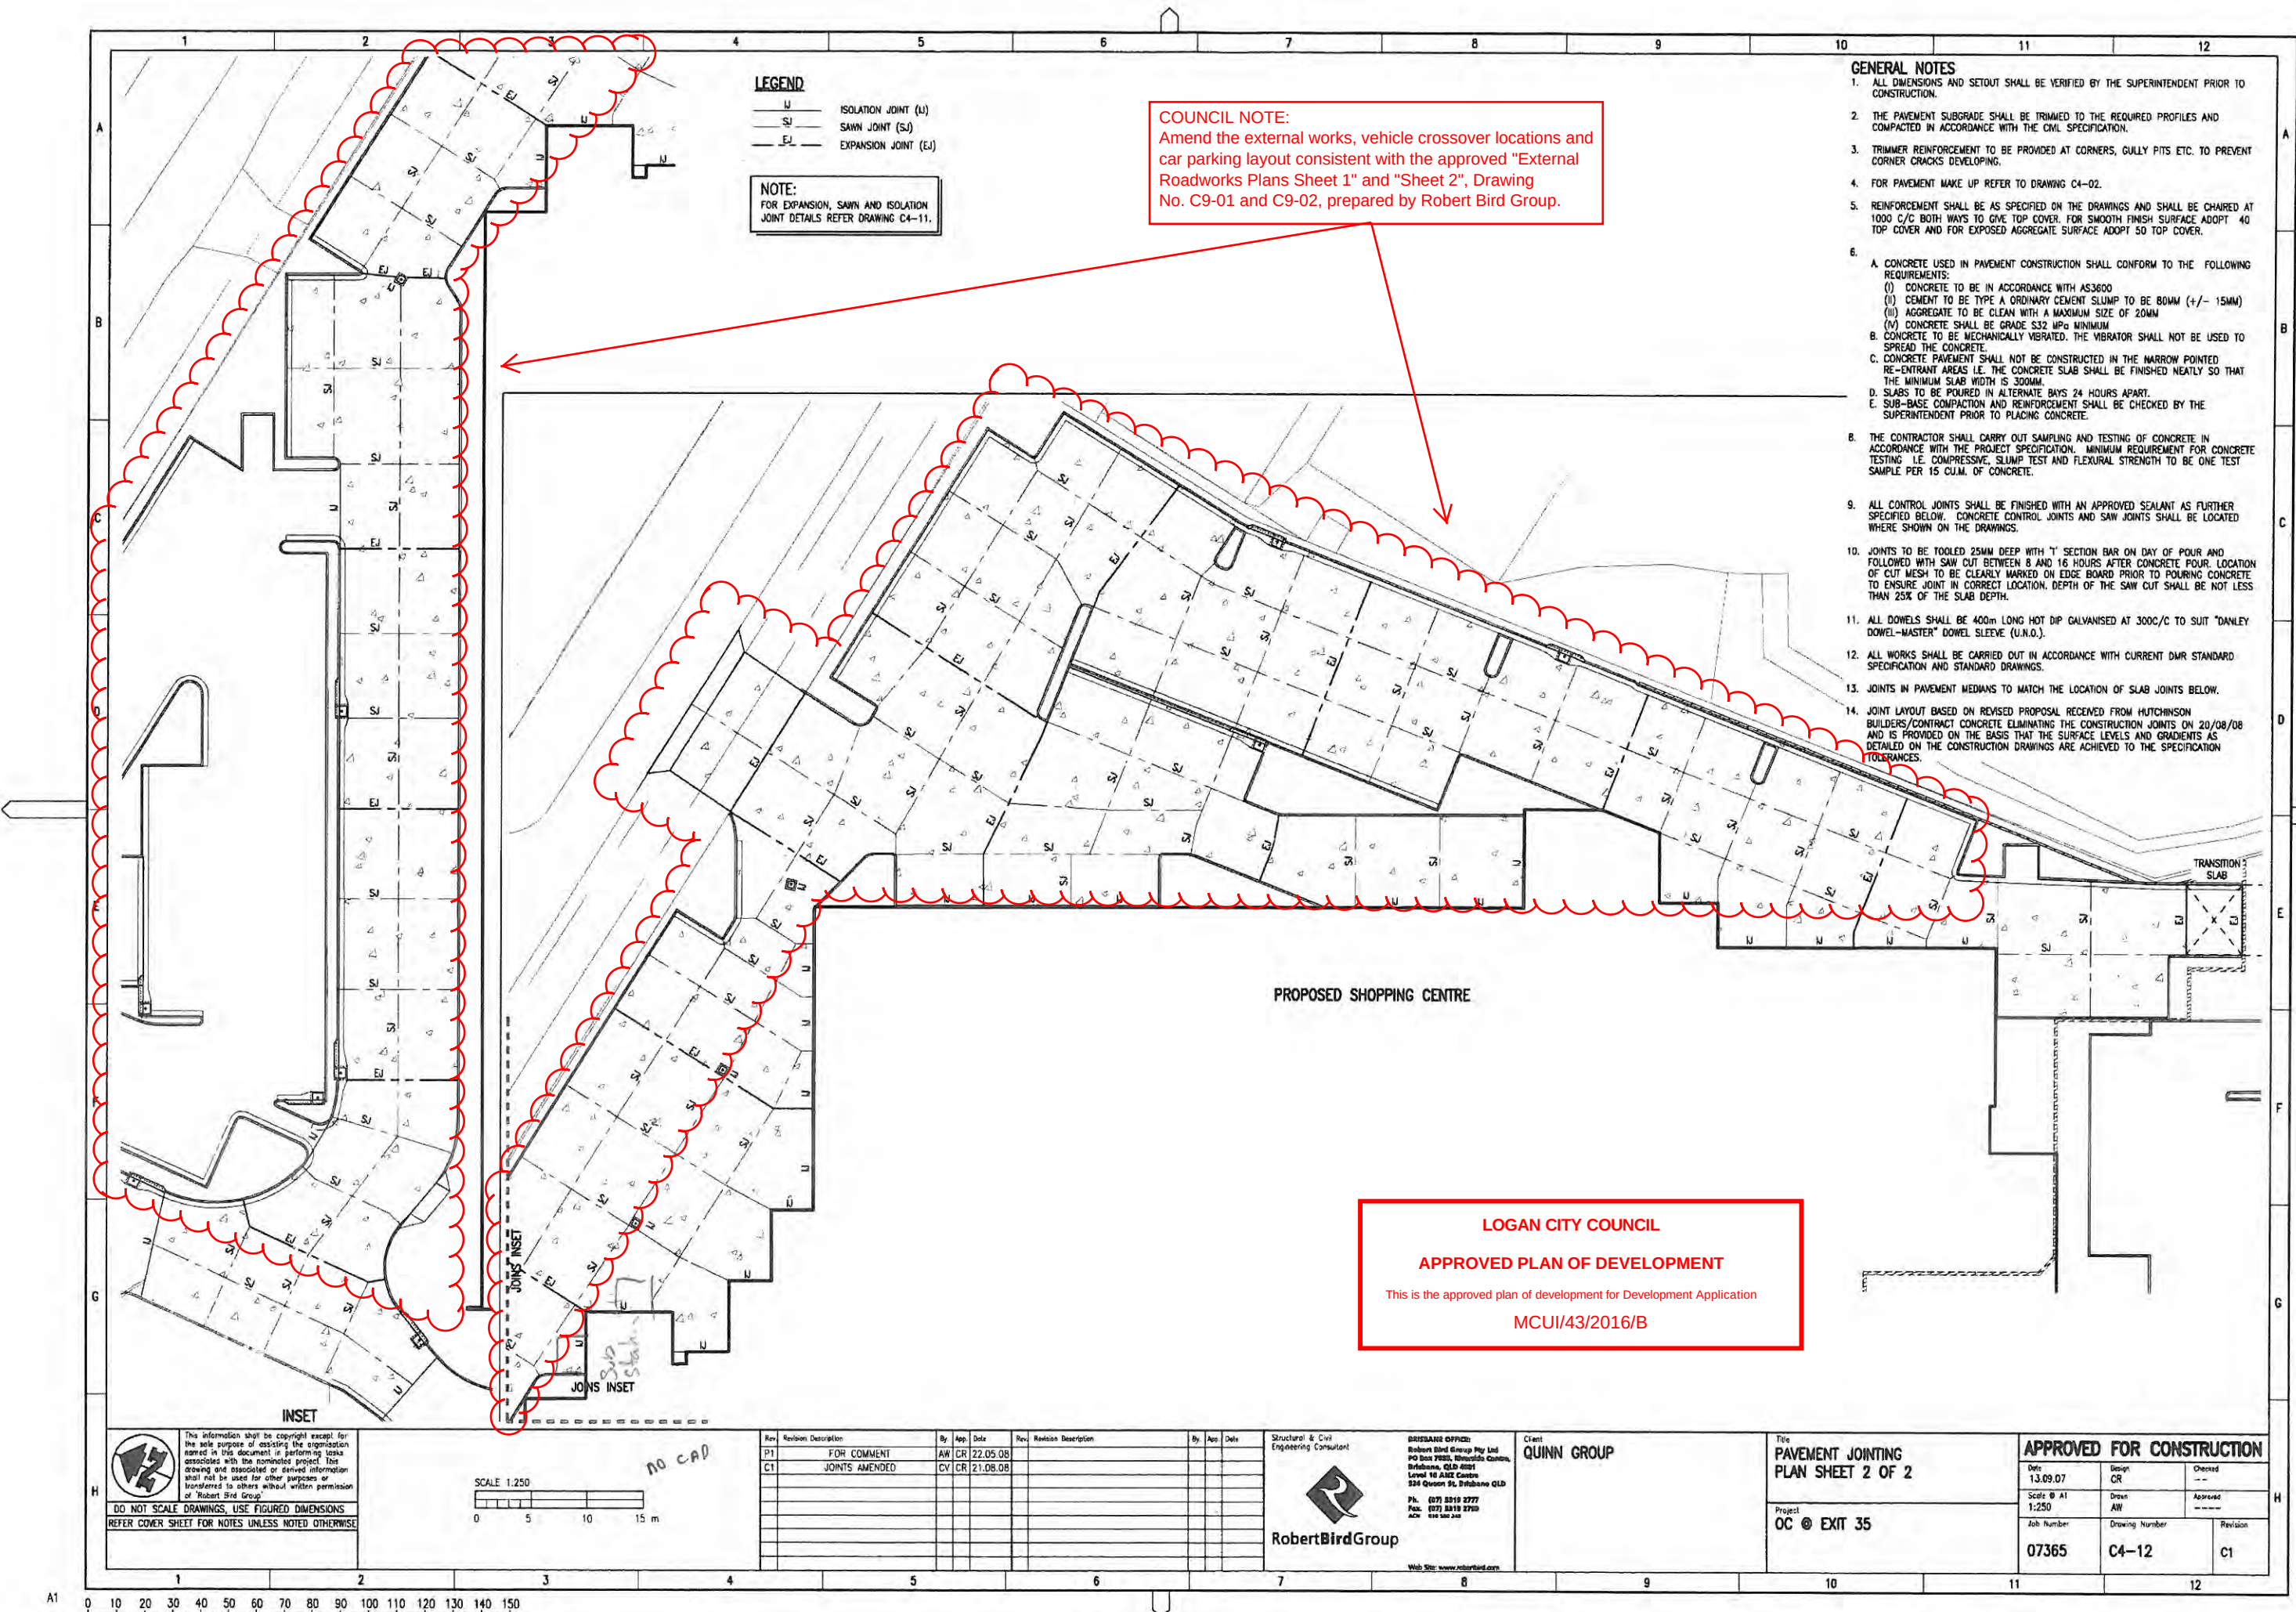

STORMWATER DRAINAGE NOTES

- ALL WORK SHALL BE IN ACCORDANCE WITH CURRENT GOLD COAST CITY COUNCIL SPECIFICATIONS AND STANDARD DRAWINGS.
- ALL STORMWATER DRAINAGE PIPES SHALL BE RCP CLASS "2" U.N.O.
- STORMWATER DRAINAGE PIPES SHALL BE SPIGOT & SOCKET WITH RUBBER RING JOINTED FOR 900 DIA. OR LESS. STORMWATER DRAINAGE PIPES GREATER THAN 900 DIA. SHALL BE FLUSH JOINTED PIPES WITH EXTERNAL ELASTOMERIC BAND.
- ALL STORMWATER PIPES TO BE BEDDED IN ACCORDANCE WITH GCCC STD. DRG. NO. 59309.
- ALL MANHOLES AND PITS TO BE CONSTRUCTED IN ACCORDANCE WITH GCCC STD. DRG. NOS. 59301, 59304, AND 59308.
- ALL ROOFWATER PITS TO BE CONSTRUCTED IN ACCORDANCE WITH GCCC STD. DRG. NO. 59308.
- ALL STORMWATER LOCATIONS TO BE CONFIRMED ON SITE BY ENGINEER PRIOR TO COMMENCING STORMWATER CONSTRUCTION.
- THE CONTRACTOR SHALL VERIFY LOCATIONS OF EXISTING SERVICES WITH ALL RELEVANT AUTHORITIES BEFORE COMMENCING CONSTRUCTION (PROVIDE A COPY OF THE INFORMATION TO THE SITE SUPERINTENDENT) IN PARTICULAR PROPOSED SERVICE CROSSINGS. EG. PROPOSED STORMWATER CROSSING EXISTING TELSTRA LINES.
- THE SETOUT OF ALL DRAINAGE STRUCTURES IS TO CENTRE OF MANHOLE/GULLYPIT U.N.O.
- DESIGN SURFACE LEVELS FOR MANHOLES AND GULLYPITS ARE TOP OF PAVEMENT LEVEL AND LIP LEVEL OF KERB AND CHANNEL RESPECTIVELY.
- LOCATION OF ALL MANHOLES TO BE CONFIRMED WITH ENGINEER ON SITE PRIOR TO CONSTRUCTION.
- THE CONTRACTOR SHALL BE RESPONSIBLE FOR & INCLUDES COSTS FOR THE FOLLOWING IN HIS CONTRACT PRICE:
 - LOCAL GOVERNMENT INSPECTION FEES.
 - MAINTENANCE BONDS REQUIRED BY COUNCIL.
 - THE COLLECTION OF AS CONSTRUCTED DATA IN ACCORDANCE LOCAL GOVERNMENT GUIDELINES.
 - REPARATION OF AS CONSTRUCTED DRAWINGS IN ACCORDANCE WITH LOCAL GOVERNMENT GUIDELINES.
 - QUALITY CONTROL DOCUMENTATION FOR LOCAL GOVERNMENT RECORDS.
- ALL MANHOLE COVERS, FRAMES AND GRATES IN TRAFFICKED AREAS ARE TO BE CLASS D.

STORMWATER PIT SETOUT

LINE NUMBER	PIT NUMBER	EASTING	NORTHING
1	10	842.911	2894.930
1	9	845.962	2888.184
1	8	848.421	2892.747
1	7	860.909	2880.976
1	6	883.714	2843.818
1	5	905.212	2827.905
1	4	934.038	2821.079
1	3	937.223	2821.938
1	2	945.249	2802.648
1	1	971.244	2782.107
1	OUT	1001.605	2764.693
1A	1	956.829	2805.021
2	4	880.486	2895.177
2	3	908.062	2878.721
2	2	911.403	2880.225
2	1	924.497	2851.169
3	8	970.081	2889.630
3	7	996.811	2882.723
3	6	1012.368	2901.340
3	5	1029.902	2982.597
3	4	1058.425	2949.677
3	3	1069.338	2914.062
3	2	1071.373	2888.654
3	1	1071.965	2881.270
3	OUT	1084.332	2863.204
4	8	932.939	2978.521
4	7	903.626	2965.245
4	6	900.770	2966.207
4	5	901.517	2983.561
4	4	889.738	2985.818
4	3	890.239	3003.993
4	2	891.854	3013.710
4	1	877.597	3015.405
4	OUT	871.532	3017.515
5	3	882.273	2927.380
5	2	884.875	2949.151
5	1	887.295	2978.192
6	1	910.561	3000.584
7	2	1075.345	2955.725
7	1	1076.809	2928.228
8	1	921.156	2849.663

COUNCIL NOTE:
Amend the external works, vehicle crossover locations and car parking layout consistent with the approved "External Roadworks Plans Sheet 1" and "Sheet 2", Drawing No. C9-01 and C9-02, prepared by Robert Bird Group.

LOGAN CITY COUNCIL

APPROVED PLAN OF DEVELOPMENT

This is the approved plan of development for Development Application

MCUI/43/2016/B

LEGEND

- SITE BOUNDARY
- 2.50 --- EXISTING CONTOURS
- ■ ■ ■ ■ EXTENT OF WORKS
- ▨ ▨ ▨ ▨ ▨ PROPOSED RETAINING WALL
- ▬ ▬ ▬ ▬ ▬ BARRIER KERB AND CHANNEL
- ▬ ▬ ▬ ▬ ▬ BARRIER KERB ONLY
- — — — — PROPOSED STORMWATER PIPE
- — — — — PROPOSED SWALE

PROPOSED BUILDING

JOINS INSET 1 ON DRG. No. C9-02

This information shall be copyright except for the sole purpose of assisting the organisation named in this document in performing tasks associated with the nominated project. This drawing and associated or derived information shall not be used for other purposes or transferred to others without written permission of Robert Bird Group.

DO NOT SCALE DRAWINGS. USE FIGURED DIMENSIONS
REFER COVER SHEET FOR NOTES UNLESS NOTED OTHERWISE

SCALE 1:250

0 5 10 15 m

Rev	Revision Description	By	App	Date	Rev	Revision Description	By	App	Date
P1	PRELIMINARY ISSUE	CR	NF	07.09.07					
A1	OPERATIONAL WORKS APPROVAL	CR	NF	11.08.07					
P2	UPDATED LAYOUTS - PRELIM ISSUE	SJ	BR	16.10.07					
T1	ISSUE FOR TENDER	AW	CR	22.10.07					
T2	ISSUE FOR TENDER	AW	CR	27.11.07					
T3	ISSUE FOR TENDER	AW	CR	12.12.07					
C1	ISSUED FOR CONSTRUCTION	AW	CR	12.03.08					
C2	ISSUED FOR CONSTRUCTION	AW	CR	---					

Structural & Civil
Engineering Consultant



Robert Bird Group

BRISBANE OFFICE:
Robert Bird Group Pty Ltd
PO Box 2835, Riverside Centre,
Brisbane, QLD 4001
Level 16 ANZ Centre
324 Queen St, Brisbane QLD

Ph: (07) 3319 2777
Fax: (07) 3319 2799

Web Site: www.rbg.com.au

Client
QUINN GROUP

Title
STORMWATER DRAINAGE
LAYOUT PLAN SHEET 1 OF 5

Project
OC @ EXIT 35

APPROVED FOR CONSTRUCTION

Date 07.09.07	Design CR	Drawn ---
Scale @ A1 1:250	Drawn CF	Approved ---
Job Number 07365	Drawing Number C6-01	Revision C2

LEGEND

- SITE BOUNDARY
- 2.50 --- EXISTING CONTOURS
- ■ ■ ■ ■ EXTENT OF WORKS
- ▨ PROPOSED RETAINING WALL
- ▬ BARRIER KERB AND CHANNEL
- ▬ BARRIER KERB ONLY
- ▬ PROPOSED STORMWATER PIPE
- >--- PROPOSED SWALE

LOGAN CITY COUNCIL

APPROVED PLAN OF DEVELOPMENT

This is the approved plan of development for Development Application
MCUI/43/2016/B

COUNCIL NOTE:


Amend the external works, vehicle crossover locations and car parking layout consistent with the approved "External Roadworks Plans Sheet 1" and "Sheet 2", Drawing No. C9-02 and C9-02, prepared by Robert Bird Group.

STORMWATER DRAINAGE NOTES


- ALL WORK SHALL BE IN ACCORDANCE WITH CURRENT GOLD COAST CITY COUNCIL SPECIFICATIONS AND STANDARD DRAWINGS.
- ALL STORMWATER DRAINAGE PIPES SHALL BE RCP CLASS "2" U.N.O.
- STORMWATER DRAINAGE PIPES SHALL BE SPIGOT & SOCKET WITH RUBBER RING JOINTED FOR 900 DIA. OR LESS. STORMWATER DRAINAGE PIPES GREATER THAN 900 DIA. SHALL BE FLUSH JOINTED PIPES WITH EXTERNAL ELASTOMERIC BAND.
- ALL STORMWATER PIPES TO BE BEDDED IN ACCORDANCE WITH GCCC STD. DRG. NO. 59309.
- ALL MANHOLES AND PITS TO BE CONSTRUCTED IN ACCORDANCE WITH GCCC STD. DRG. NOS. 59301, 59304, AND 59308.
- ALL ROOFWATER PITS TO BE CONSTRUCTED IN ACCORDANCE WITH GCCC STD. DRG. NO. 59308.
- ALL STORMWATER LOCATIONS TO BE CONFIRMED ON SITE BY ENGINEER PRIOR TO COMMENCING STORMWATER CONSTRUCTION.
- THE CONTRACTOR SHALL VERIFY LOCATIONS OF EXISTING SERVICES WITH ALL RELEVANT AUTHORITIES BEFORE COMMENCING CONSTRUCTION (PROVIDE A COPY OF THE INFORMATION TO THE SITE SUPERINTENDENT) IN PARTICULAR PROPOSED SERVICE CROSSINGS. EG. PROPOSED STORMWATER CROSSING EXISTING TELSTRA LINES.
- THE SETOUT OF ALL DRAINAGE STRUCTURES IS TO CENTRE OF MANHOLE/GULLYPIT U.N.O.
- DESIGN SURFACE LEVELS FOR MANHOLES AND GULLYPITS ARE TOP OF PAVEMENT LEVEL AND UP LEVEL OF KERB AND CHANNEL RESPECTIVELY.
- LOCATION OF ALL MANHOLES TO BE CONFIRMED WITH ENGINEER ON SITE PRIOR TO CONSTRUCTION.
- THE CONTRACTOR SHALL BE RESPONSIBLE FOR & INCLUDES COSTS FOR THE FOLLOWING IN HIS CONTRACT PRICE:
 - LOCAL GOVERNMENT INSPECTION FEES.
 - MAINTENANCE BONDS REQUIRED BY COUNCIL.
 - THE COLLECTION OF AS CONSTRUCTED DATA IN ACCORDANCE LOCAL GOVERNMENT GUIDELINES.
 - REPARATION OF AS CONSTRUCTED DRAWINGS IN ACCORDANCE WITH LOCAL GOVERNMENT GUIDELINES.
 - QUALITY CONTROL DOCUMENTATION FOR LOCAL GOVERNMENT RECORDS.
- ALL MANHOLE COVERS, FRAMES AND GRATES IN TRAFFICKED AREAS ARE TO BE CLASS D.

INSET 2

SCALE 1:50

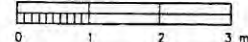

SCALE 1:250

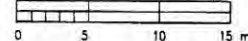

Rev	Revision Description	By	App	Date	Rev	Revision Description	By	App	Date
P1	PRELIMINARY ISSUE	CR	NP	07.09.07	C3	ISSUE FOR CONSTRUCTION	AW	CR	24.09.08
A1	OPERATIONAL WORKS APPROVAL	CR	NP	11.09.07					
P2	UPDATED LAYOUTS - PRELIM ISSUE	SJ	BR	16.10.07					
T1	ISSUE FOR TENDER	AW	CR	22.10.07					
T2	ISSUE FOR TENDER	AW	CR	27.11.07					
T3	ISSUE FOR TENDER	AW	CR	12.12.07					
C1	ISSUED FOR CONSTRUCTION	AW	CR	12.03.08					
C2	ISSUED FOR CONSTRUCTION	AW	CR	04.08.08					
A2	ISSUE FOR APPROVAL	AW	CR	10.08.08					

Robert Bird Group Pty Ltd
BRISBANE OFFICE:
Robert Bird Group Pty Ltd
PO Box 7655, Riverside Centre,
Brisbane, QLD 4001
Level 16 AND Centre
224 Queen St, Brisbane QLD
Ph: (07) 3316 2777
Fax: (07) 3316 2788
www.rbg.com.au


Client
QUINN GROUP

SIGNED FOR AND ON BEHALF OF ROBERT BIRD GROUP PTY LTD

Title
STORMWATER DRAINAGE
LAYOUT PLAN SHEET 2 OF 5

Project
OC @ EXIT 35

Date 07.09.07	Design CR	Checked BCR
Scale @ A1 1:250	Drawn GF	Approved BCR
Job Number 07365	Drawing Number C6-02	Revision C3

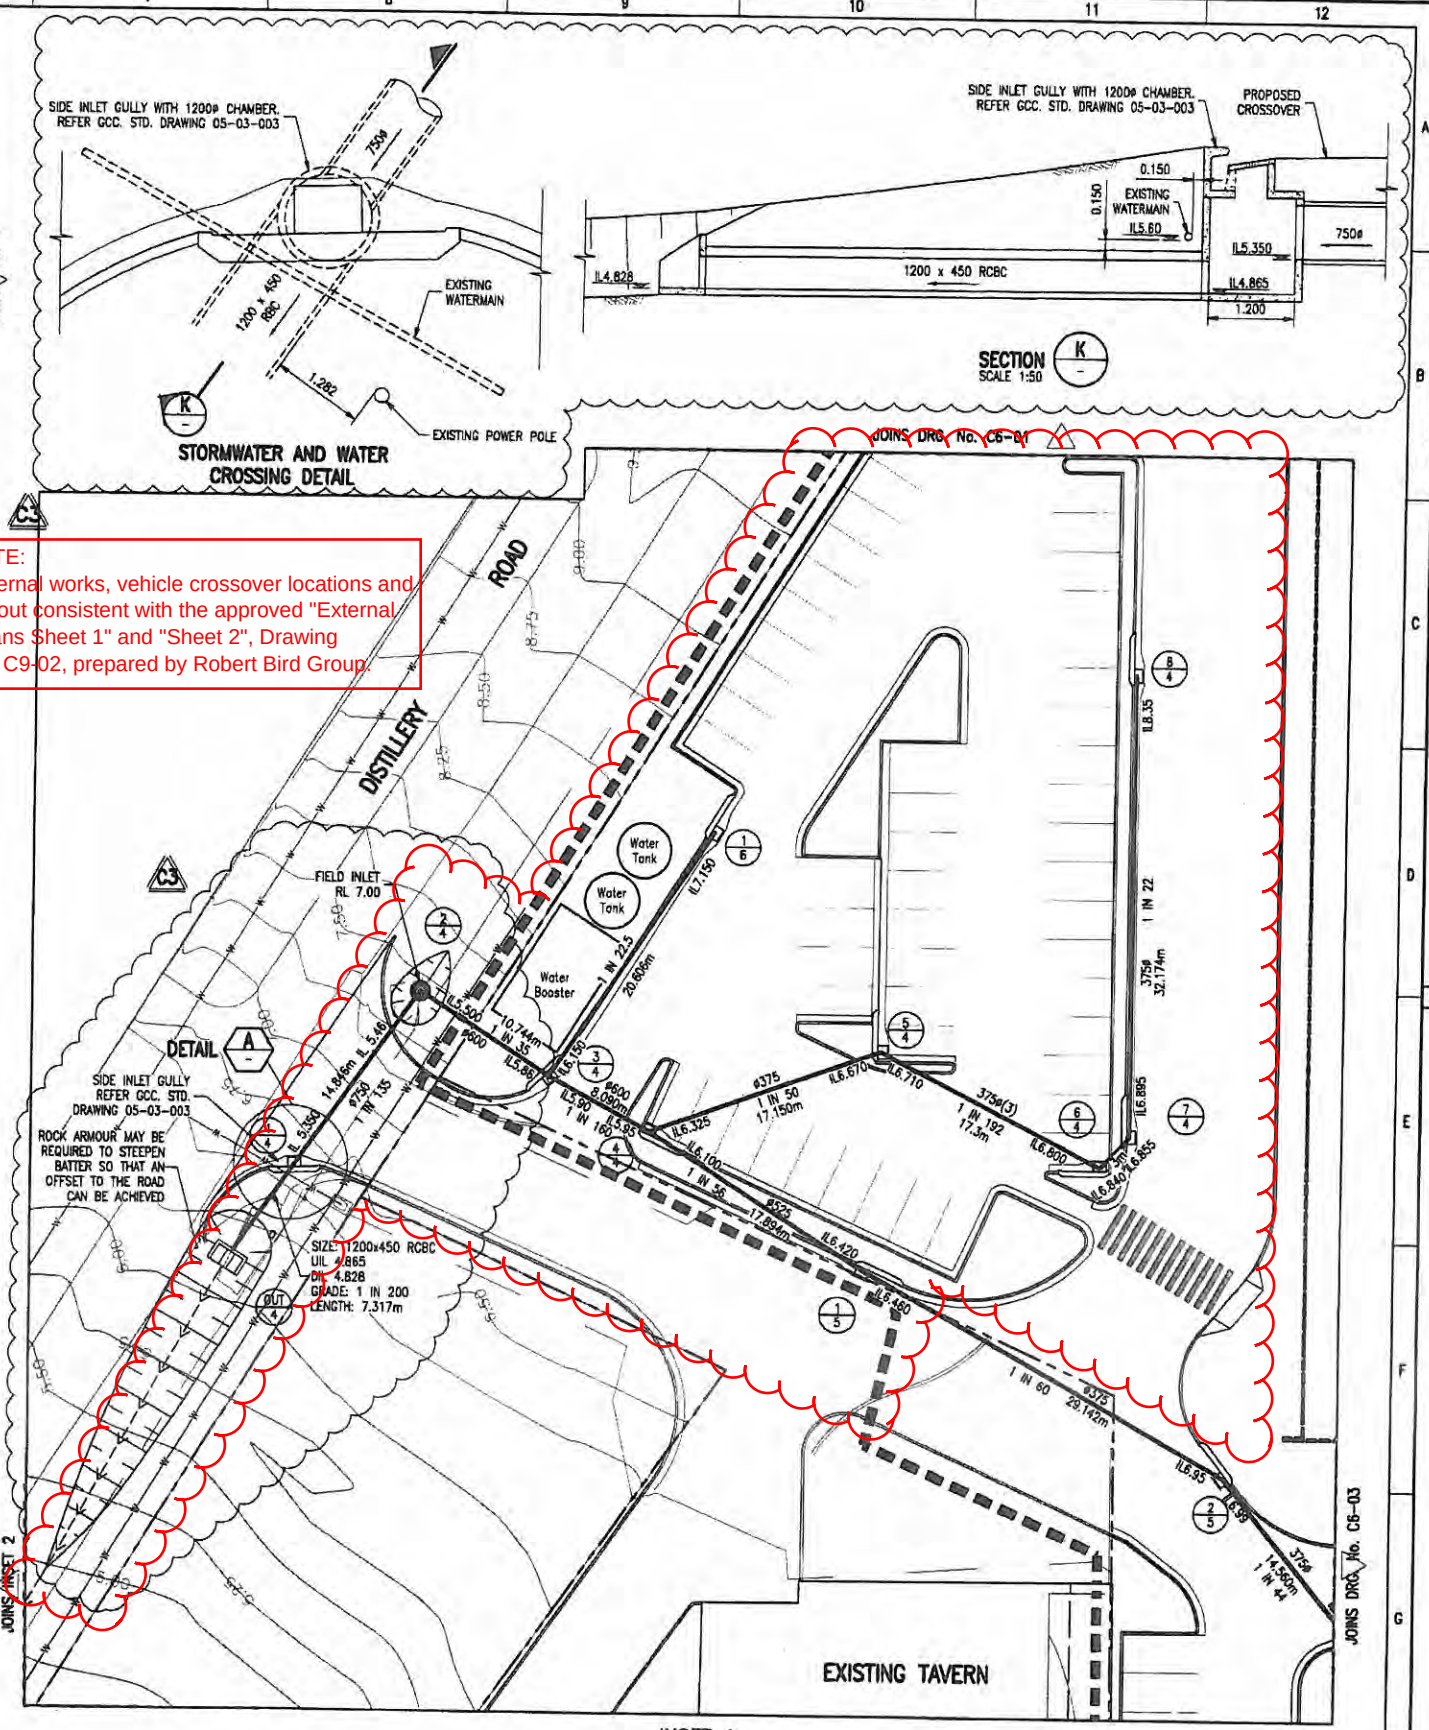

INSET 1

Robert Bird Group Pty Ltd
BRISBANE OFFICE:
Robert Bird Group Pty Ltd
PO Box 7655, Riverside Centre,
Brisbane, QLD 4001
Level 16 AND Centre
224 Queen St, Brisbane QLD
Ph: (07) 3316 2777
Fax: (07) 3316 2788
www.rbg.com.au


Client
QUINN GROUP


SIGNED FOR AND ON BEHALF OF ROBERT BIRD GROUP PTY LTD

Title
STORMWATER DRAINAGE
LAYOUT PLAN SHEET 2 OF 5

Project
OC @ EXIT 35

Date 07.09.07	Design CR	Checked BCR
Scale @ A1 1:250	Drawn GF	Approved BCR
Job Number 07365	Drawing Number C6-02	Revision C3

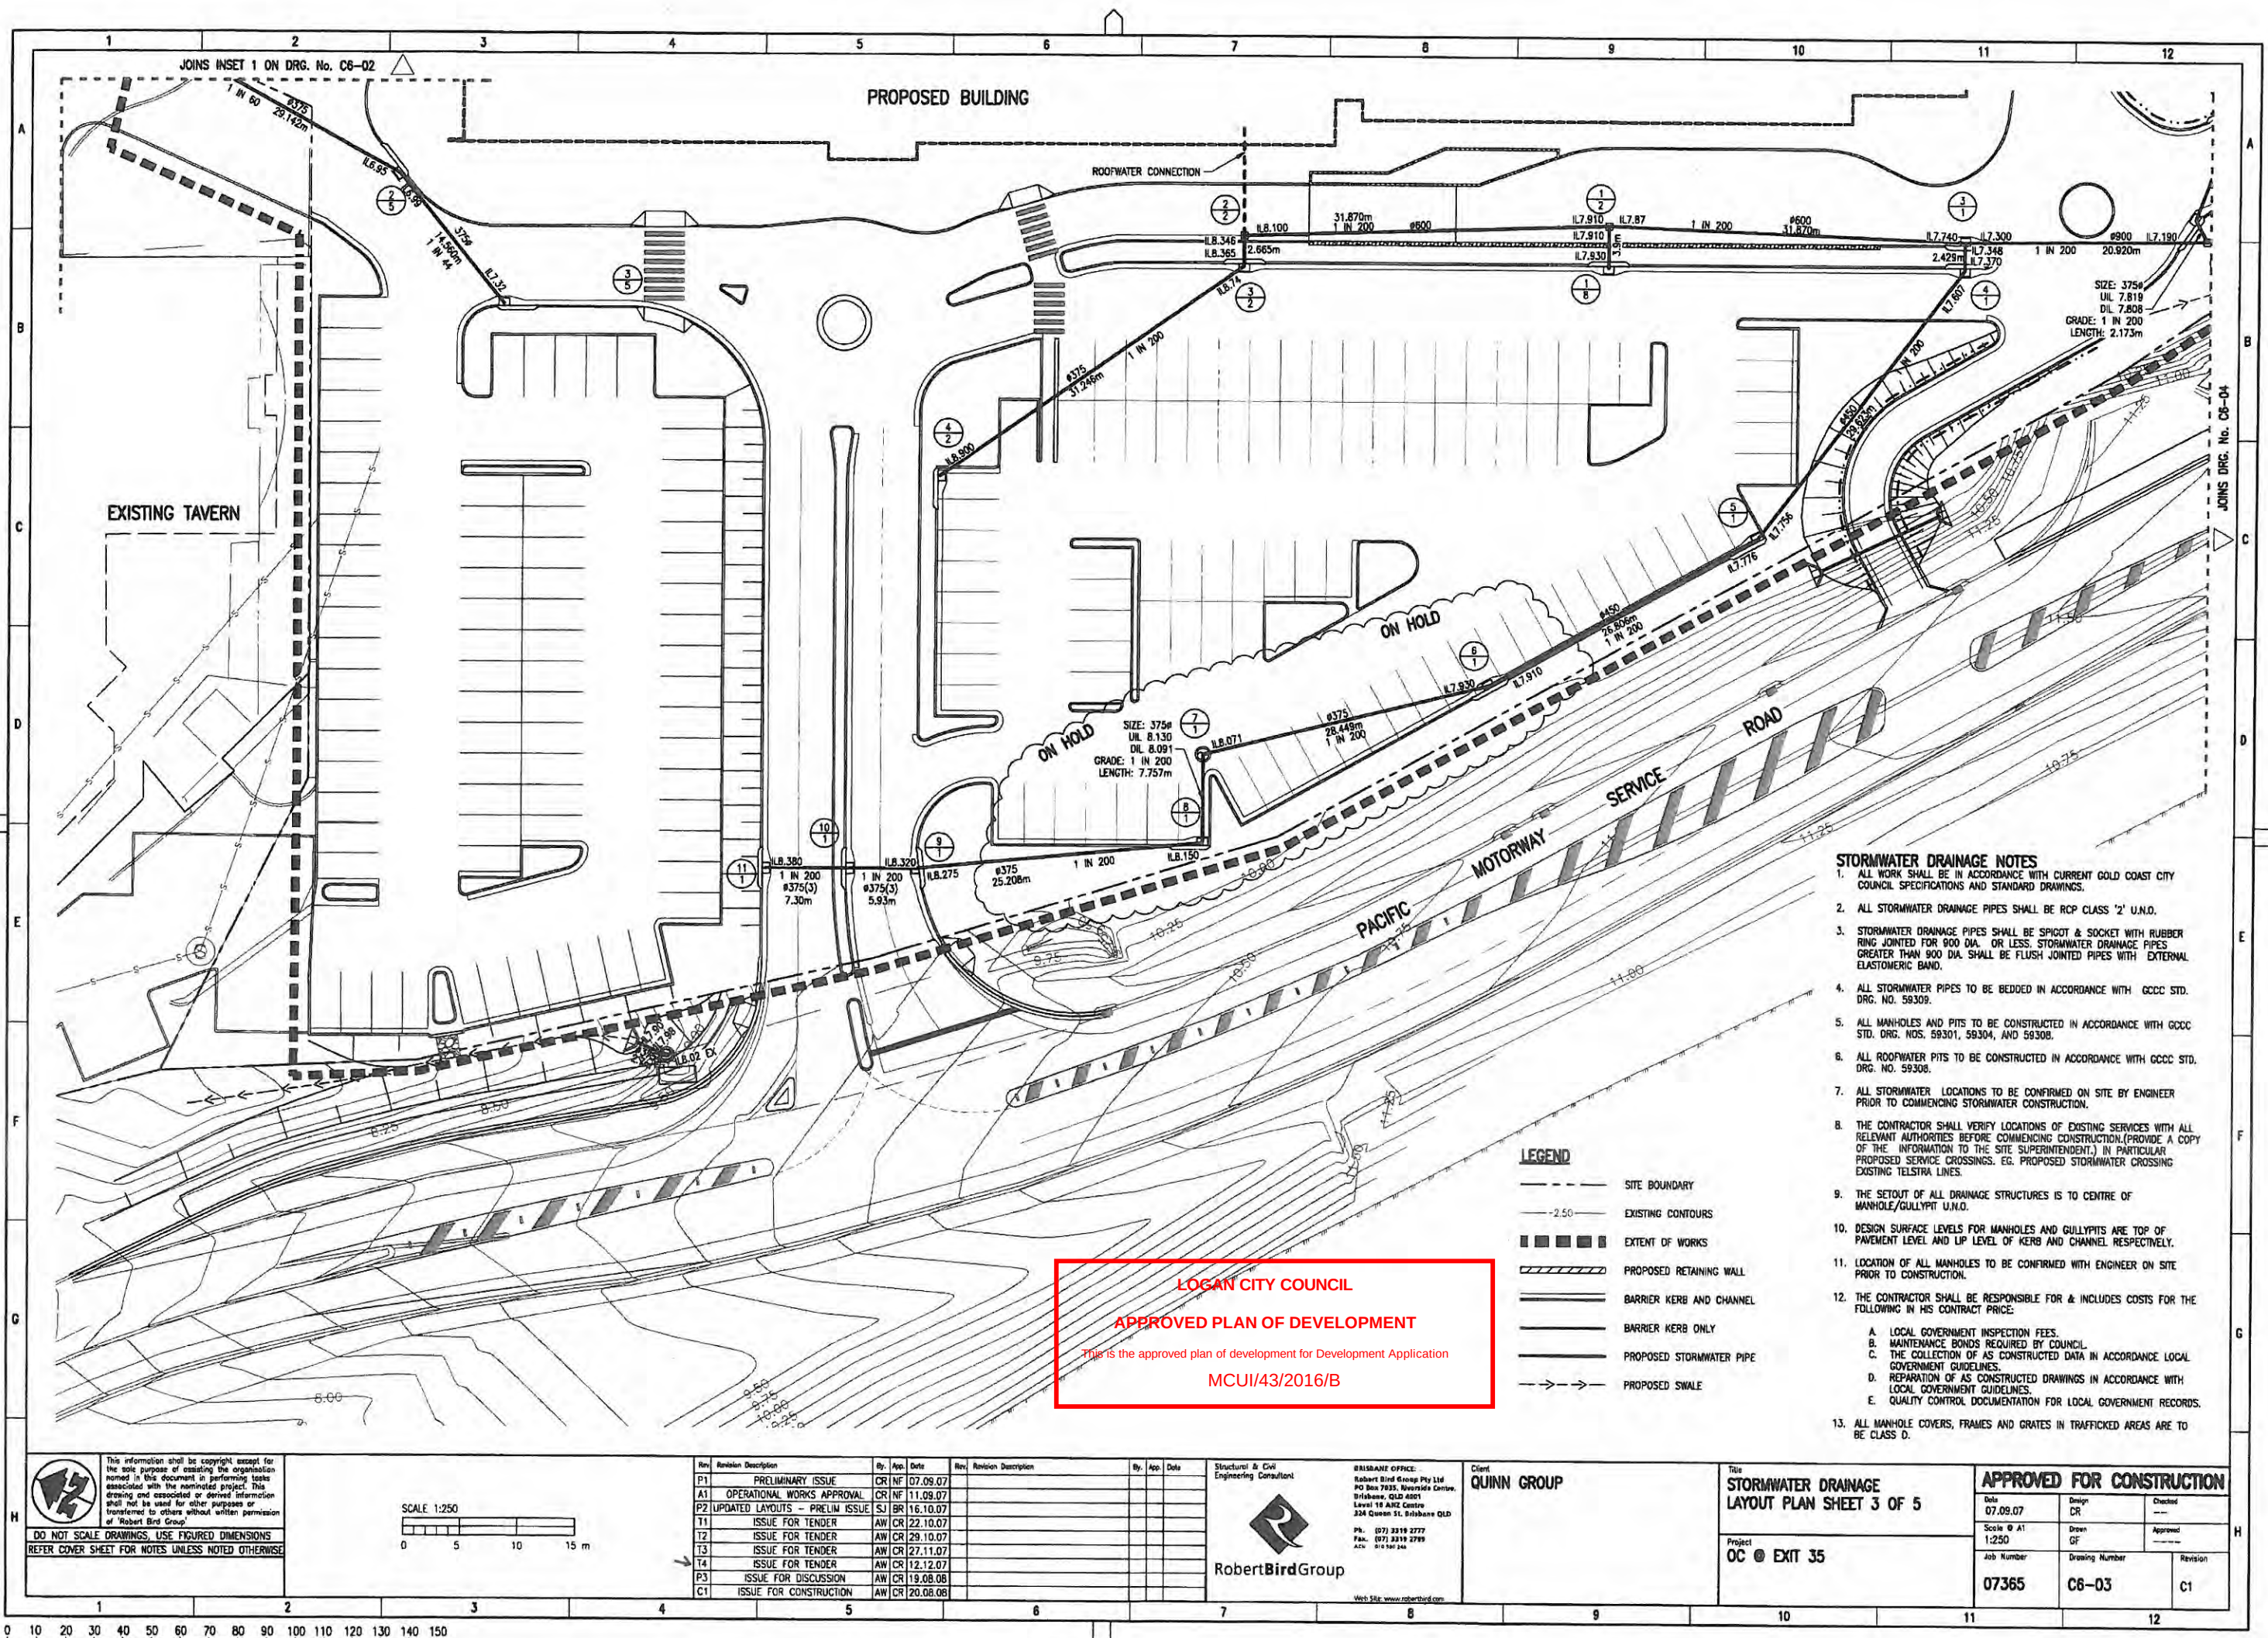

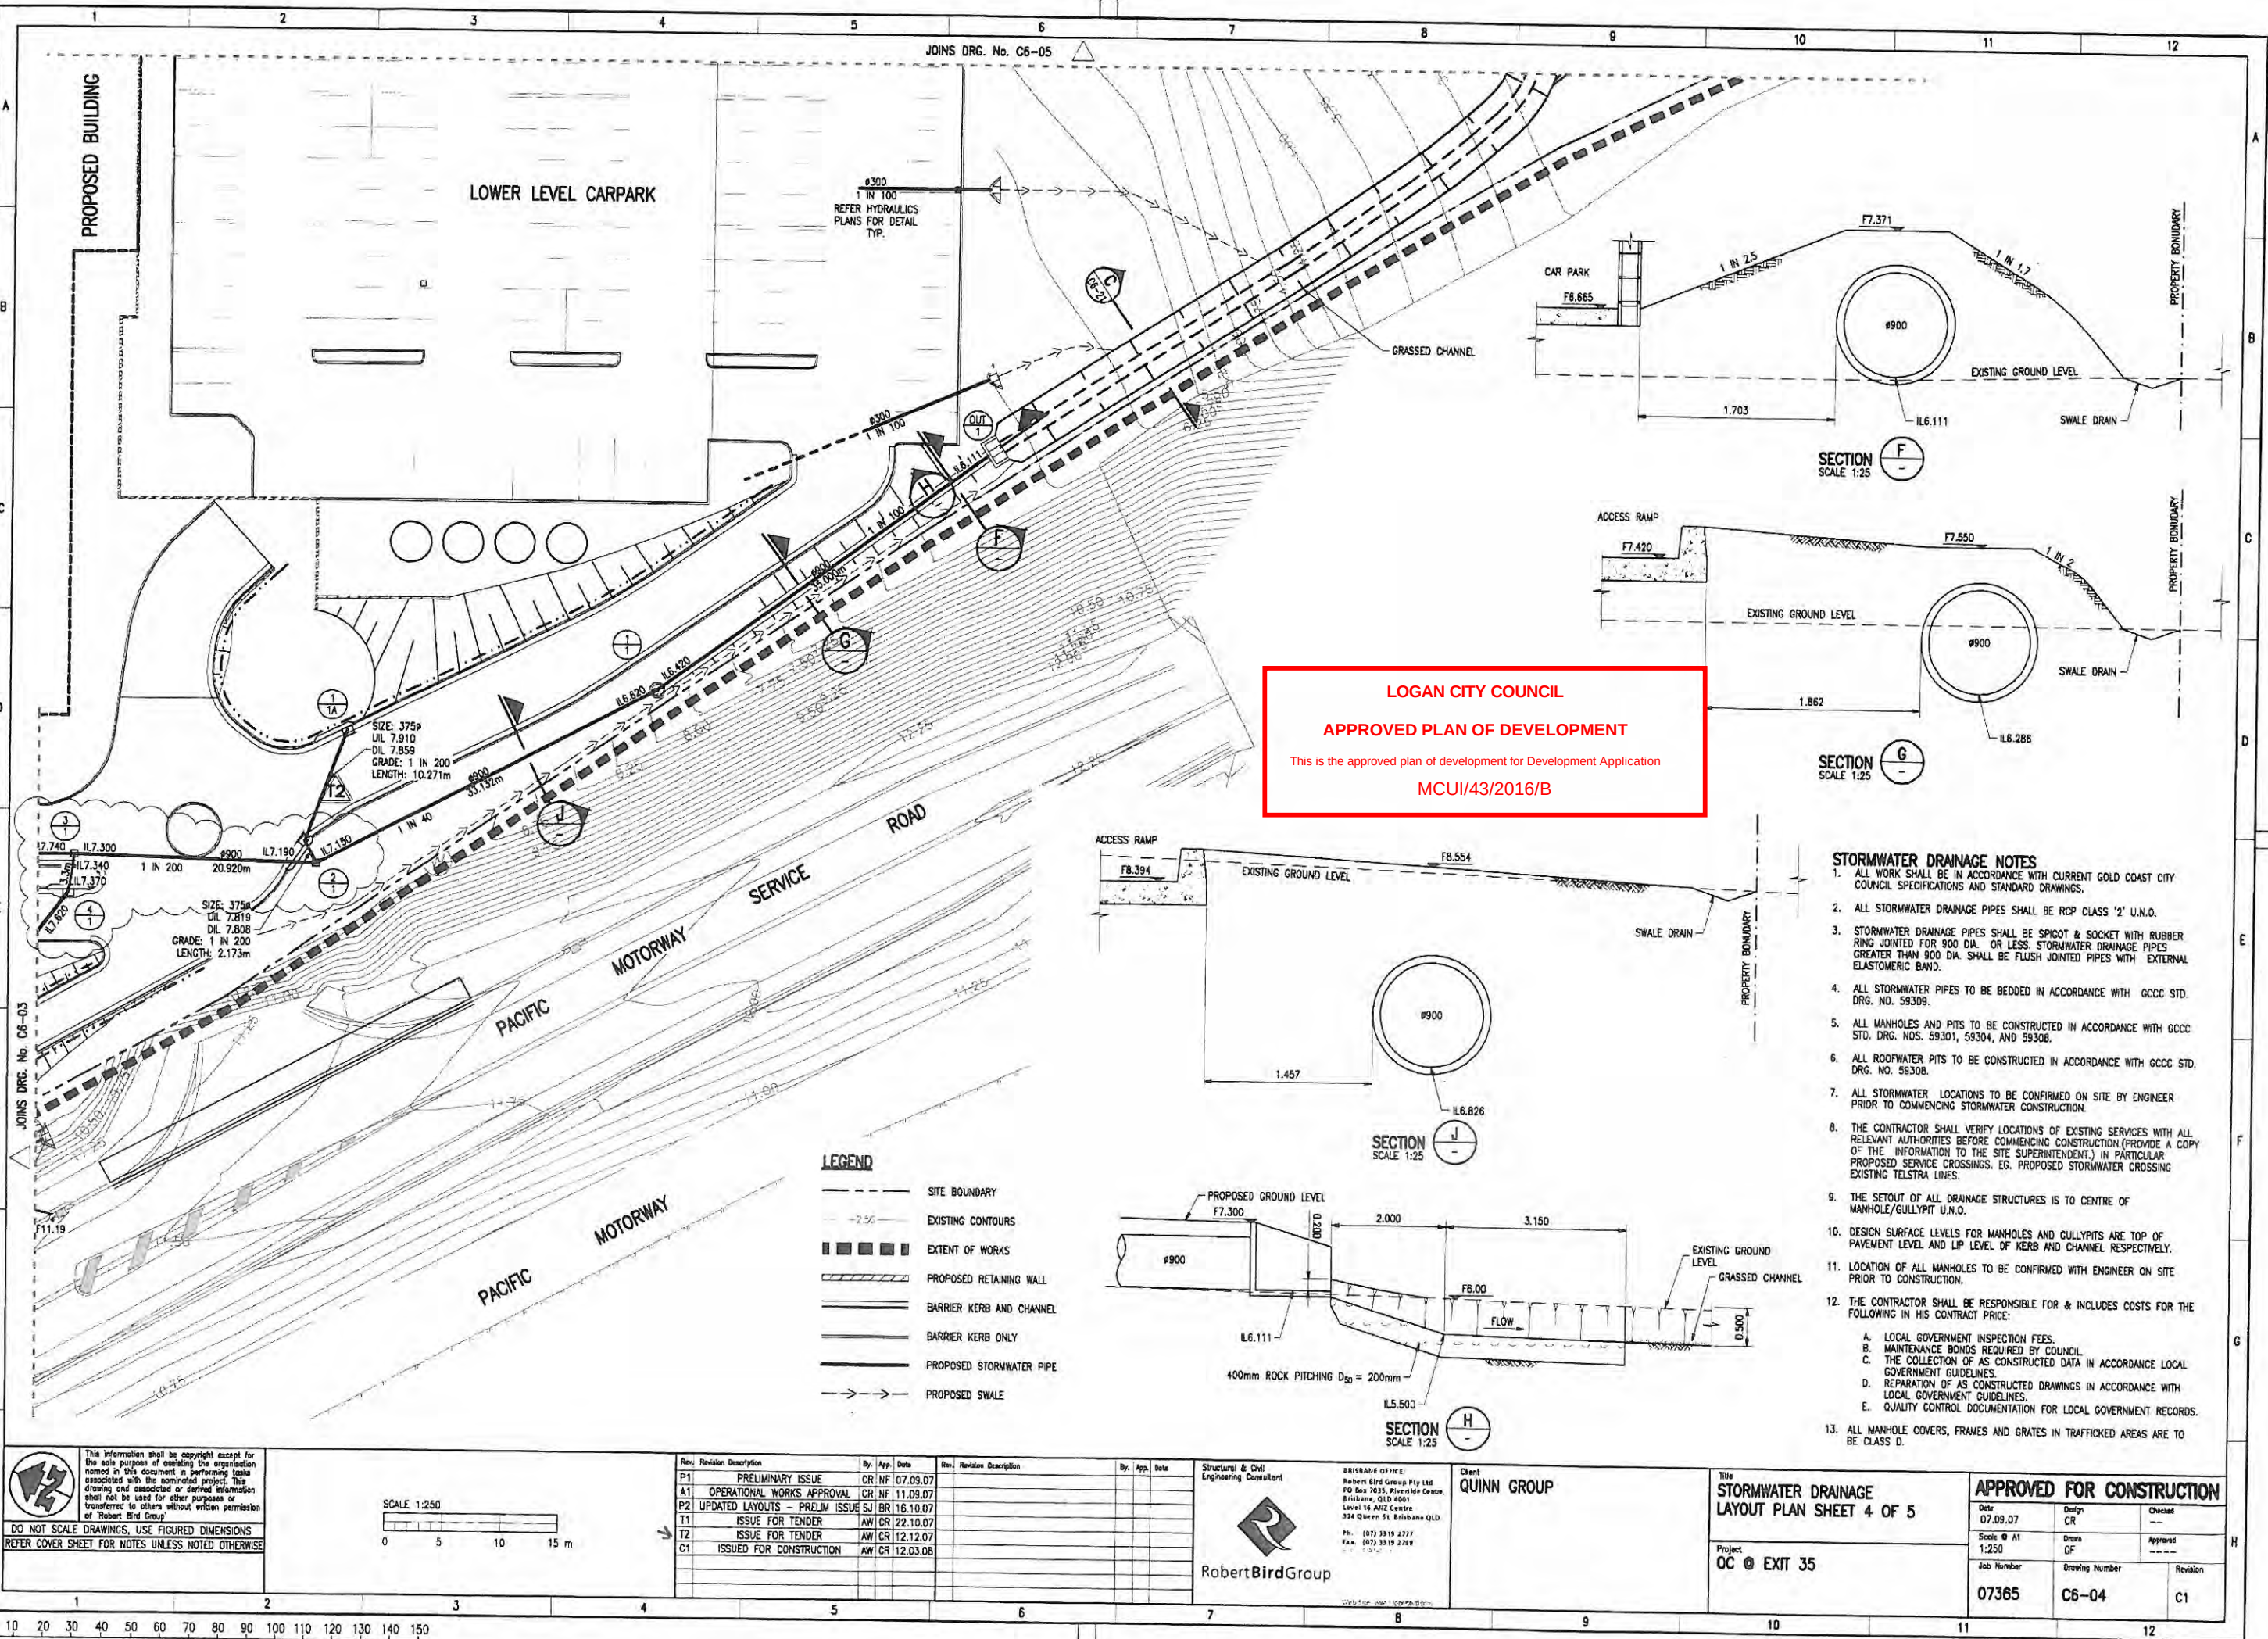


LOGAN CITY COUNCIL
APPROVED PLAN OF DEVELOPMENT
This is the approved plan of development for Development Application
MCUI/43/2016/B

- STORMWATER DRAINAGE NOTES**
1. ALL WORK SHALL BE IN ACCORDANCE WITH CURRENT GOLD COAST CITY COUNCIL SPECIFICATIONS AND STANDARD DRAWINGS.
 2. ALL STORMWATER DRAINAGE PIPES SHALL BE RCP CLASS '2' U.N.O.
 3. STORMWATER DRAINAGE PIPES SHALL BE SPIGOT & SOCKET WITH RUBBER RING JOINTED FOR 900 DIA. OR LESS. STORMWATER DRAINAGE PIPES GREATER THAN 900 DIA. SHALL BE FLUSH JOINTED PIPES WITH EXTERNAL ELASTOMERIC BAND.
 4. ALL STORMWATER PIPES TO BE BEDDED IN ACCORDANCE WITH GCCC STD. DRG. NO. 59309.
 5. ALL MANHOLES AND PITS TO BE CONSTRUCTED IN ACCORDANCE WITH GCCC STD. DRG. NOS. 59301, 59304, AND 59308.
 6. ALL ROOFWATER PITS TO BE CONSTRUCTED IN ACCORDANCE WITH GCCC STD. DRG. NO. 59308.
 7. ALL STORMWATER LOCATIONS TO BE CONFIRMED ON SITE BY ENGINEER PRIOR TO COMMENCING STORMWATER CONSTRUCTION.
 8. THE CONTRACTOR SHALL VERIFY LOCATIONS OF EXISTING SERVICES WITH ALL RELEVANT AUTHORITIES BEFORE COMMENCING CONSTRUCTION (PROVIDE A COPY OF THE INFORMATION TO THE SITE SUPERINTENDENT.) IN PARTICULAR PROPOSED SERVICE CROSSINGS, EG. PROPOSED STORMWATER CROSSING EXISTING TELSTRA LINES.
 9. THE SETOUT OF ALL DRAINAGE STRUCTURES IS TO CENTRE OF MANHOLE/GULLYPIT U.N.O.
 10. DESIGN SURFACE LEVELS FOR MANHOLES AND GULLYPITS ARE TOP OF PAVEMENT LEVEL AND LIP LEVEL OF KERB AND CHANNEL RESPECTIVELY.
 11. LOCATION OF ALL MANHOLES TO BE CONFIRMED WITH ENGINEER ON SITE PRIOR TO CONSTRUCTION.
 12. THE CONTRACTOR SHALL BE RESPONSIBLE FOR & INCLUDES COSTS FOR THE FOLLOWING IN HIS CONTRACT PRICE:
 - A. LOCAL GOVERNMENT INSPECTION FEES.
 - B. MAINTENANCE BONDS REQUIRED BY COUNCIL.
 - C. THE COLLECTION OF AS CONSTRUCTED DATA IN ACCORDANCE LOCAL GOVERNMENT GUIDELINES.
 - D. REPAIRATION OF AS CONSTRUCTED DRAWINGS IN ACCORDANCE WITH LOCAL GOVERNMENT GUIDELINES.
 - E. QUALITY CONTROL DOCUMENTATION FOR LOCAL GOVERNMENT RECORDS.
 13. ALL MANHOLE COVERS, FRAMES AND GRATES IN TRAFFICKED AREAS ARE TO BE CLASS D.

- LEGEND**
- SITE BOUNDARY
 - - - EXISTING CONTOURS
 - EXTENT OF WORKS
 - ▨▨▨▨▨ PROPOSED RETAINING WALL
 - ▬▬▬ BARRIER KERB AND CHANNEL
 - ▬▬▬ BARRIER KERB ONLY
 - ▬▬▬ PROPOSED STORMWATER PIPE
 - - - PROPOSED SWALE

This information shall be copyright except for the sole purpose of enabling the organisation named in this document in performing tasks associated with the nominated project, this drawing and associated or derived information shall not be used for other purposes or transferred to others without written permission of Robert Bird Group.

DO NOT SCALE DRAWINGS, USE FIGURED DIMENSIONS
REFER COVER SHEET FOR NOTES UNLESS NOTED OTHERWISE

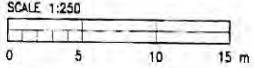

Rev.	Revision Description	By	App.	Date	Rev.	Revision Description	By	App.	Date
P1	PRELIMINARY ISSUE	CR	NF	07.09.07					
A1	OPERATIONAL WORKS APPROVAL	CR	NF	11.09.07					
P2	UPDATED LAYOUTS - PRELIM ISSUE	SJ	BR	16.10.07					
T1	ISSUE FOR TENDER	AW	CR	22.10.07					
T2	ISSUE FOR TENDER	AW	CR	12.12.07					
C1	ISSUED FOR CONSTRUCTION	AW	CR	12.03.08					

Structural & Civil Engineering Consultant

Robert Bird Group

BRISBANE OFFICE:
Robert Bird Group Pty Ltd
PO Box 2035, Riverside Centre,
Brisbane, QLD 4001
Level 14 ARIZ Centre
328 Queen St, Brisbane QLD
Ph: (07) 3519 2777
Fax: (07) 3519 2788
E: rbg@robertbirdgroup.com.au

Client

QUINN GROUP

Title

STORMWATER DRAINAGE LAYOUT PLAN SHEET 4 OF 5

Project

OC @ EXIT 35

APPROVED FOR CONSTRUCTION			
Date	Design	Check	
07.09.07	CR		
Scale @ A1	Drawn	Approved	
1:250	GF		
Job Number	Drawing Number	Revision	
07365	C6-04	C1	

LOGAN CITY COUNCIL

APPROVED PLAN OF DEVELOPMENT

This is the approved plan of development for Development Application


MCUI/43/2016/B

STORMWATER DRAINAGE NOTES

1. ALL WORK SHALL BE IN ACCORDANCE WITH CURRENT GOLD COAST CITY COUNCIL SPECIFICATIONS AND STANDARD DRAWINGS.
2. ALL STORMWATER DRAINAGE PIPES SHALL BE RCP CLASS '2' U.N.D.
3. STORMWATER DRAINAGE PIPES SHALL BE SPIGOT & SOCKET WITH RUBBER RING JOINTED FOR 900 DIA. OR LESS. STORMWATER DRAINAGE PIPES GREATER THAN 900 DIA. SHALL BE FLUSH JOINTED PIPES WITH EXTERNAL ELASTOMERIC BAND.
4. ALL STORMWATER PIPES TO BE BEDDED IN ACCORDANCE WITH GCCC STD. DRG. NO. 59309.
5. ALL MANHOLES AND PITS TO BE CONSTRUCTED IN ACCORDANCE WITH GCCC STD. DRG. NOS. 59301, 59304, AND 59308.
6. ALL ROOFWATER PITS TO BE CONSTRUCTED IN ACCORDANCE WITH GCCC STD. DRG. NO. 59308.
7. ALL STORMWATER LOCATIONS TO BE CONFIRMED ON SITE BY ENGINEER PRIOR TO COMMENCING STORMWATER CONSTRUCTION.
8. THE CONTRACTOR SHALL VERIFY LOCATIONS OF EXISTING SERVICES WITH ALL RELEVANT AUTHORITIES BEFORE COMMENCING CONSTRUCTION (PROVIDE A COPY OF THE INFORMATION TO THE SITE SUPERINTENDENT) IN PARTICULAR PROPOSED SERVICE CROSSINGS. EG. PROPOSED STORMWATER CROSSING EXISTING TELSTRA LINES.
9. THE SETOUT OF ALL DRAINAGE STRUCTURES IS TO CENTRE OF MANHOLE/GULLYPIT U.N.D.
10. DESIGN SURFACE LEVELS FOR MANHOLES AND GULLYPITS ARE TOP OF PAVEMENT LEVEL AND LP LEVEL OF KERB AND CHANNEL RESPECTIVELY.
11. LOCATION OF ALL MANHOLES TO BE CONFIRMED WITH ENGINEER ON SITE PRIOR TO CONSTRUCTION.
12. THE CONTRACTOR SHALL BE RESPONSIBLE FOR & INCLUDES COSTS FOR THE FOLLOWING IN HIS CONTRACT PRICE:
 - A. LOCAL GOVERNMENT INSPECTION FEES.
 - B. MAINTENANCE BONDS REQUIRED BY COUNCIL.
 - C. THE COLLECTION OF AS CONSTRUCTED DATA IN ACCORDANCE LOCAL GOVERNMENT GUIDELINES.
 - D. REPARATION OF AS CONSTRUCTED DRAWINGS IN ACCORDANCE WITH LOCAL GOVERNMENT GUIDELINES.
 - E. QUALITY CONTROL DOCUMENTATION FOR LOCAL GOVERNMENT RECORDS.
13. ALL MAN-HOLE COVERS, FRAMES AND GRATES IN TRAFFICKED AREAS ARE TO BE CLASS 'D'.


LEGEND

- SITE BOUNDARY
- 2.50- EXISTING CONTOURS
- EXTENT OF WORKS
- ▨ PROPOSED RETAINING WALL
- ▬ BARRIER KERB AND CHANNEL
- ▬ BARRIER KERB ONLY
- ▬ PROPOSED STORMWATER PIPE
- >->- PROPOSED SWALE

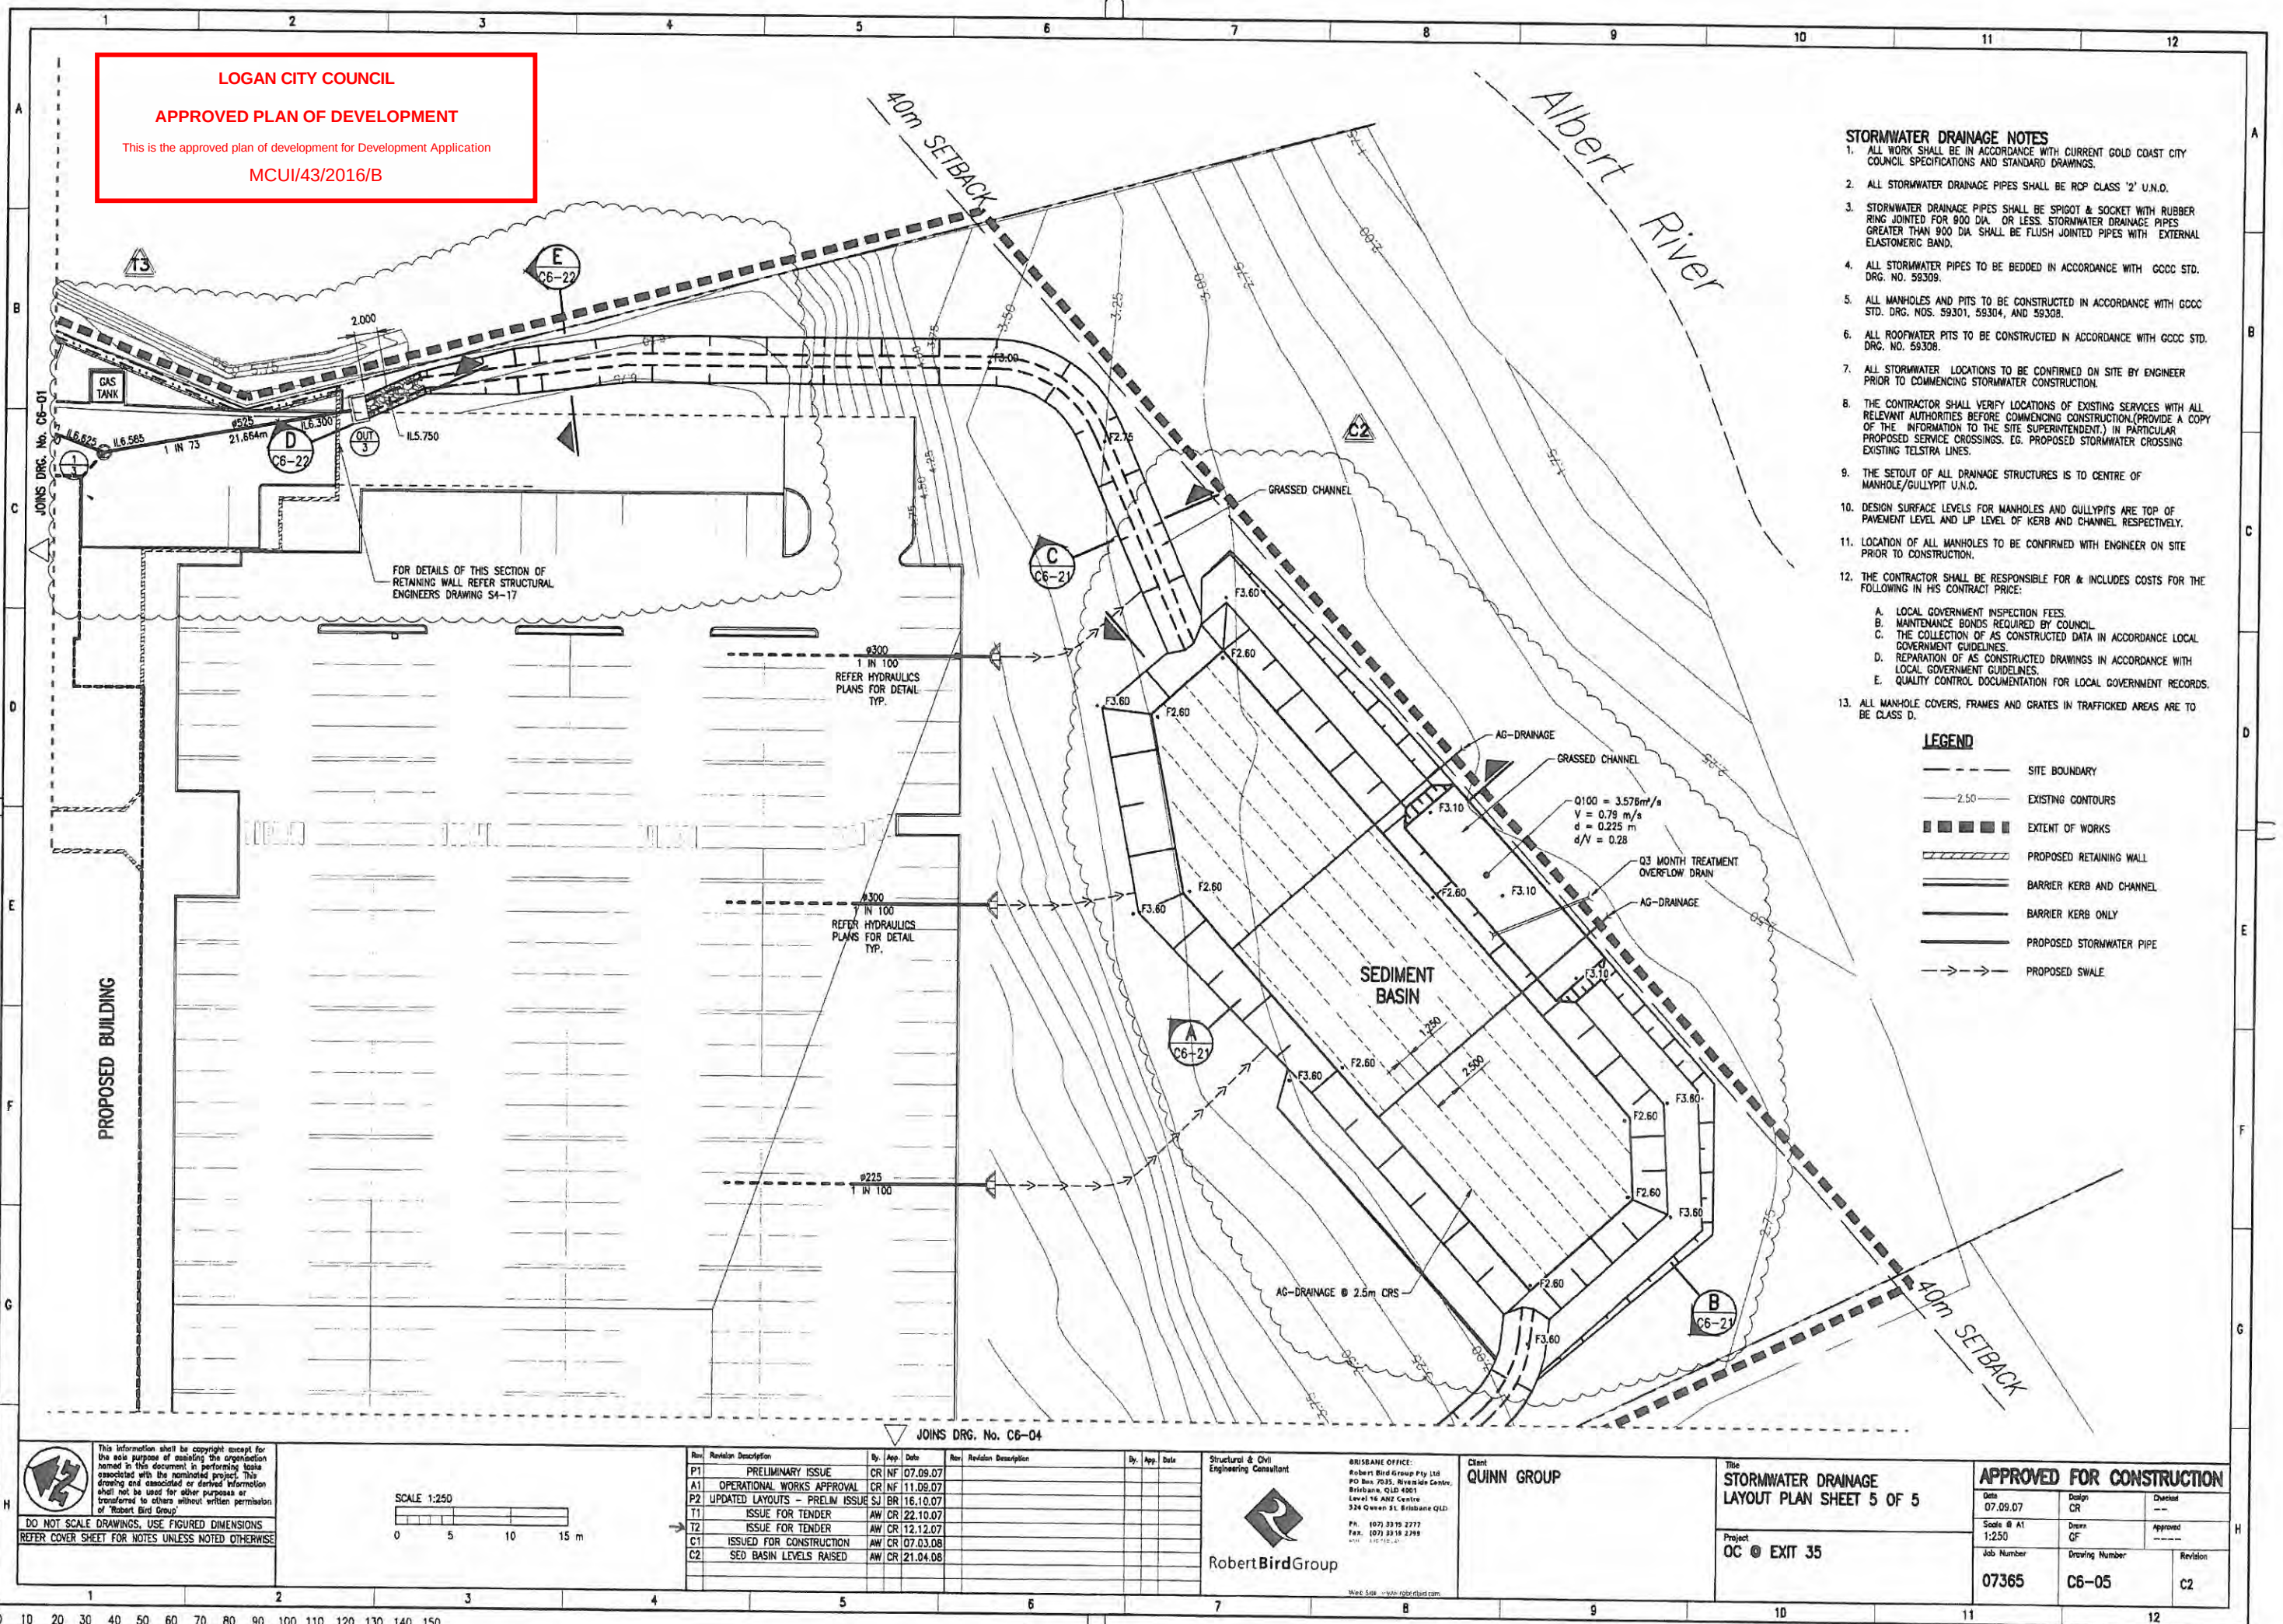

This information shall be copyright except for the sole purpose of assisting the organisation named in this document, in performing tasks associated with the nominated project. This drawing and associated or derived information shall not be used for other purposes or transferred to others without written permission of "Robert Bird Group".

DO NOT SCALE DRAWINGS, USE FIGURED DIMENSIONS
REFER COVER SHEET FOR NOTES UNLESS NOTED OTHERWISE

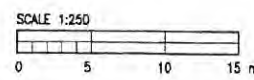

Rev	Revision Description	By	App	Date	Rev	Revision Description	By	App	Date
P1	PRELIMINARY ISSUE	CR	IF	07.09.07					
A1	OPERATIONAL WORKS APPROVAL	CR	IF	11.09.07					
P2	UPDATED LAYOUTS - PRELIM ISSUE	SJ	BR	16.10.07					
T1	ISSUE FOR TENDER	AW	CR	22.10.07					
T2	ISSUE FOR TENDER	AW	CR	12.12.07					
C1	ISSUED FOR CONSTRUCTION	AW	CR	07.03.08					
C2	SED BASIN LEVELS RAISED	AW	CR	21.04.08					

Structural & Civil Engineering Consultant

Robert Bird Group

BRISBANE OFFICE:
Robert Bird Group Pty Ltd
PO Box 7035, Riverside Centre,
Brisbane, QLD 4001
Level 16 ANZ Centre
324 Queen St, Brisbane QLD
Ph: (07) 3319 2777
Fax: (07) 3319 2799
www.rbg.com.au

Client
QUINN GROUP

The
**STORMWATER DRAINAGE
LAYOUT PLAN SHEET 5 OF 5**

Project
OC @ EXIT 35

APPROVED FOR CONSTRUCTION		
Date 07.09.07	Design CR	Checked ---
Scale @ A1 1:250	Drawn GF	Approved ---
Job Number 07365	Drawing Number C6-05	Revision C2


A TYPICAL CROSS SECTION
C6-05 SCALE 1:50

B TYPICAL LONG SECTION
C6-05 SCALE 1:50

C TYPICAL SECTION
C6-05
C6-04 SCALE 1:50

LOGAN CITY COUNCIL
APPROVED PLAN OF DEVELOPMENT
This is the approved plan of development for Development Application
MCUI/43/2016/B

DO NOT SCALE DRAWINGS. USE FIGURED DIMENSIONS.
REFER COVER SHEET FOR NOTES UNLESS NOTED OTHERWISE

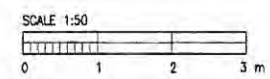




Rev.	Revision Description	By	App.	Date	Rev.	Revision Description	By	App.	Date
P1	PRELIMINARY ISSUE	CR	NF	07.09.07					
A1	OPERATIONAL WORKS APPROVAL	CR	NF	11.09.07					
P2	UPDATED LAYOUTS - PRELIM ISSUE	SJ	BR	16.10.07					
T1	UPDATED LAYOUTS - PRELIM ISSUE	AW	BR	22.10.07					
C1	ISSUE FOR CONSTRUCTION	AW	BR	21.04.08					

Structural & Civil
Engineering Consultant
Robert Bird Group
BRISBANE OFFICE:
Robert Bird Group Pty Ltd
PO Box 7035, Riverside Centre,
Brisbane, QLD 4001
Level 18 ABZ Centre,
324 Queen St, Brisbane QLD
Ph: (07) 3318 3773
Fax: (07) 3318 2799
E-Mail: info@rbrb.com.au
Web Site: www.rbrb.com.au

Client
QUINN GROUP

Title
**STORMWATER DRAINAGE
SEDIMENT BASIN SECTIONS**
Project
OC @ EXIT 35


APPROVED FOR CONSTRUCTION		
Date 07.09.07	Design SJ	Checked ---
Scale @ A1 1:50	Drawn JP	Approved ---
Job Number 07365	Drawing Number C6-21	Revision C1

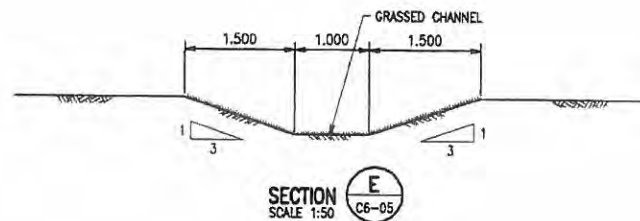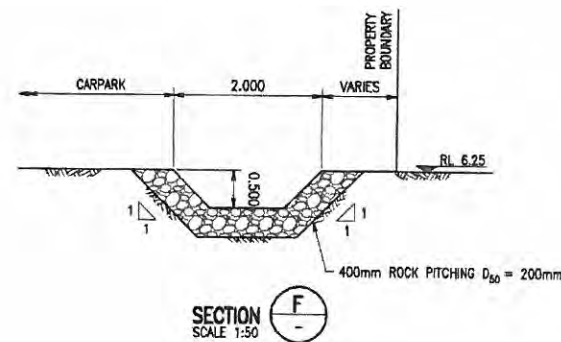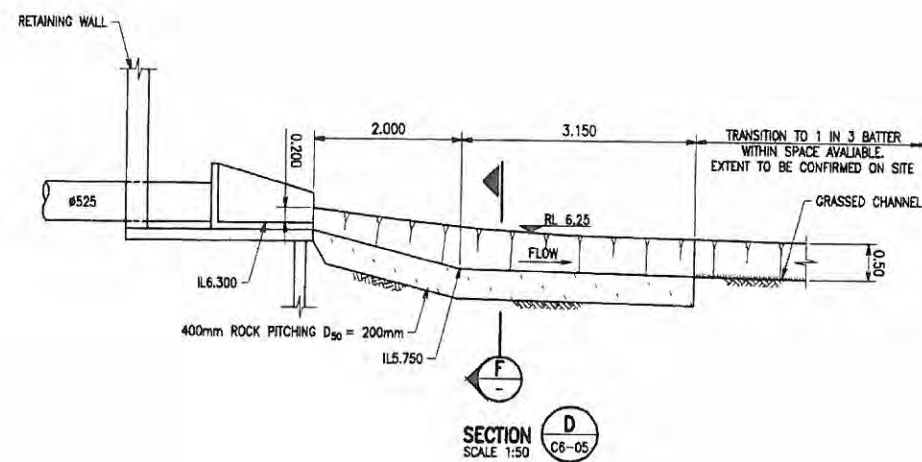

LOGAN CITY COUNCIL
APPROVED PLAN OF DEVELOPMENT
This is the approved plan of development for Development Application
MCUI/43/2016/B

This information shall be copyright except for the sole purpose of assisting the organisation named in this document in performing tasks associated with the nominated project. This drawing and associated or derived information shall not be used for other purposes or transferred to others without written permission of Robert Bird Group.

DO NOT SCALE DRAWINGS, USE FIGURED DIMENSIONS
REFER COVER SHEET FOR NOTES UNLESS NOTED OTHERWISE

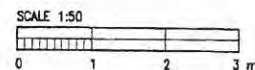

Rev	Revision Description	By	App	Date	Rev	Revision Description	By	App	Date
C1	ISSUE FOR CONSTRUCTION	AW	CR	21.04.08					

Structural & Civil
Engineering Consultant



Robert Bird Group

BRISBANE OFFICE:
Robert Bird Group Pty Ltd
PO Box 7035, Riverside Centre,
Brisbane, QLD 4001
Level 16 ABC Centre
324 Queen St, Brisbane QLD
Ph: (07) 3310 2777
Fax: (07) 3310 2795
E: info@rbdgroup.com

Client
QUINN GROUP

Title
**STORMWATER DRAINAGE
SWALE SECTIONS**


Project
OC @ EXIT 35

APPROVED FOR CONSTRUCTION

Date 13.08.07	Design CR	Checked ---
Scale B A1 1:50	Drawn AW	Approved ---
Job Number 07365	Drawing Number C6-22	Revision C1

ROADWORKS NOTES

- ALL DIMENSIONS ON THE DRAWINGS ARE IN METRES UNLESS SHOWN OTHERWISE.
- ANY ROADWORKS SET-OUT AND DIMENSIONS ARE REFERENCED TO THE NOMINAL KERB LINE (FACE OF KERB).
- ALL ROAD PAVEMENT LEVELS SHOWN ARE LIP LEVEL OF KERB AND CHANNEL OR PAVEMENT LEVEL OF KERB.
- ROAD PAVEMENT LEVELS ON INTERSECTION DETAILS ARE AT TP'S, MIDPOINTS OR QUARTER POINTS UNLESS SHOWN OTHERWISE.
- ASPHALTIC CONCRETE SURFACING AND PAVEMENT SHALL BE TO LOGAN CITY COUNCIL STANDARDS AND CONSTRUCTION SPECIFICATIONS.
- FINAL PAVEMENT DEPTHS SHALL BE DETERMINED BY THE SUPERINTENDENT AFTER SUBGRADE TESTING RESULTS HAVE BEEN EXAMINED.
- SIDE DRAINS ARE TO BE INSTALLED UNDER ALL KERB & CHANNEL AND KERB ONLY, AND SHALL DRAIN TO A GULLY PIT. SIDE DRAINS ARE TO BE INSTALLED UNDER ALL LANDSCAPED TRAFFIC ISLANDS.
- ALL WORKS SHALL BE CARRIED OUT IN ACCORDANCE WITH CURRENT LOGAN CITY COUNCIL SPECIFICATIONS AND STANDARD DRAWINGS UNLESS SHOWN OTHERWISE.
- THE CONTRACTOR SHALL VERIFY LOCATIONS OF EXISTING SERVICES WITH ALL RELEVANT AUTHORITIES BEFORE COMMENCING CONSTRUCTION. (PROVIDE A COPY OF THE INFORMATION TO THE SITE SUPERINTENDENT.) IN PARTICULAR PROPOSED SERVICE CROSSINGS, EG. PROPOSED SEWER RETICULATION CROSSING EXISTING TELSTRA LINES.
- ANY RELOCATION OF EXISTING SERVICES REQUIRED IS TO BE UNDERTAKEN BY THE RELEVANT SERVICE AUTHORITY. THE CONTRACTOR SHALL BE RESPONSIBLE FOR AND INCLUDE COSTS IN HIS CONTRACT PRICE FOR ANY RELOCATION OF EXISTING SERVICES.
- SUB-GRADE GRAVEL SHALL EXTEND 100mm MIN. BELOW AND 300mm BEHIND REAR OF ANY TYPE OF KERB OR KERB & CHANNEL ON ALL PAVEMENTS.
- THE CONTRACTOR SHALL VERIFY OFFSET PEGS AND BENCH MARK LEVELS AND ADVISE THE SUPERINTENDENT OF ANY DISCREPANCY BEFORE COMMENCING CONSTRUCTION.
- ALL NEW WORK SHALL JOIN NEATLY TO AND MATCH EXISTING WORK. EXISTING ROAD PAVEMENT SHALL BE CUT BACK 300mm FOR NEW PAVEMENT TO JOIN TO. REFER TO EXISTING PAVEMENT CUT-BACK DETAIL.
- THE CONTRACTOR SHALL BE RESPONSIBLE FOR & INCLUDE COSTS FOR THE FOLLOWING IN HIS CONTRACT PRICE:
 - LOGAN CITY COUNCIL INSPECTION FEES.
 - MAINTENANCE BONDS REQUIRED BY COUNCIL.
 - THE COLLECTION OF AS CONSTRUCTED DATA IN ACCORDANCE LCC GUIDELINES.
 - PREPARATION OF AS CONSTRUCTED DRAWINGS IN ACCORDANCE WITH LCC GUIDELINES INCLUDING ADAC FILES AND ALL TEST RESULTS.
 - QUALITY CONTROL DOCUMENTATION FOR LCC'S RECORDS.
- PRIMED AREAS ARE TO BE BARRICADED TO PREVENT TRAFFIC OVER PRIME PRIOR TO LAYING ASPHALT SURFACING.
- EMULSION PRIME TO BE LAYED IN ACCORDANCE WITH MANUFACTURERS REQUIREMENTS.

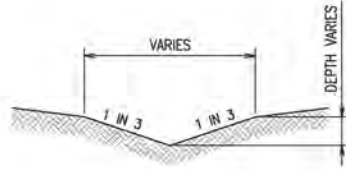

SECTION C
SCALE 1:20

SAW CUT AND JOIN NEATLY TO EXISTING PAVEMENT

ROAD WIDENING. REFER TO ROAD WIDENING PAVEMENT DETAIL

DAYLIGHT GRASSED CHANNEL

ROAD 3-25

DAYLIGHT GRASSED CHANNEL

ROAD 3-25

LOGAN CITY COUNCIL

APPROVED PLAN OF DEVELOPMENT


This is the approved plan of development for Development Application

MCUI/43/2016/B

ROAD WIDENING — BITUMEN HEAVY DUTY PAVEMENT
 45mm THICK (AC14M) C320 ON
 SEAL EMULSION PRIME ON
 150mm THICK CRUSHED ROCK TYPE 2.1 CBR 80 ON
 250mm THICK CRUSHED ROCK TYPE 2.2 CBR 60 (SUB-BASE) ON
 340mm THICK CBR 15 SUBGRADE REPLACEMENT
 BASED ON ASSUMED SUBGRADE CBR 2

LEGEND

- EXISTING STORMWATER PIPE
- EXISTING CONTOURS
- EXISTING KERB & CHANNEL
- SITE BOUNDARY
- EXISTING CONTOURS
- PROPOSED STORMWATER PIPE
- PROPOSED SWALE
- EXTENT OF WORKS
- PROPOSED RETAINING WALL
- BARRIER KERB AND CHANNEL
- BARRIER KERB ONLY
- PROPOSED HEADWALL
- PROPOSED STORMWATER MAINTENANCE HOLE
- PROPOSED STORMWATER PIT
- PROPOSED STORMWATER FIELD INLET PIT
- PROPOSED STRUCTURE No./LINE No.
- FINISHED PAVEMENT LEVEL

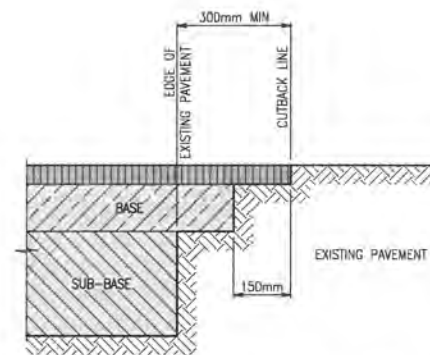

TYPICAL EXISTING PAVEMENT CUT-BACK DETAIL
SCALE 1:10

SIGNED FOR AND ON BEHALF OF ROBERT BIRD GROUP PTY LTD RPEQ 08281

This information shall be copyright except for the sole purpose of assisting the organisation named in this document in performing tasks associated with the nominated project. This drawing and associated or derived information shall not be used for other purposes or transferred to others without written permission of Robert Bird Group.

DO NOT SCALE DRAWINGS. USE FIGURED DIMENSIONS
REFER COVER SHEET FOR NOTES UNLESS NOTED OTHERWISE

SCALE 1:250
0 5 10 15 m

Rev	Revision Description	By	App	Date	Rev	Revision Description	By	App	Date
P1	PRELIMINARY ISSUE	CR	NF	16.10.07					
T1	ISSUED FOR TENDER	AW	CR	22.10.07					
A1	ISSUED FOR OP WORKS APPROVAL	AW	CR	23.10.07					
T2	ISSUED FOR TENDER	AW	CR	24.10.07					
C1	ISSUED FOR CONSTRUCTION	AW	CR	26.02.08					
A2	ISSUED FOR APPROVAL	AP	IM	22.09.17					

Structural & Civil Engineering Consultant:



Robert Bird Group

BRISBANE OFFICE:
Robert Bird Group Pty Ltd
PO Box 7035, Riverside Centre,
Brisbane, QLD 4001
Level 16 ANZ Centre
324 Queen St, Brisbane QLD

Ph: (07) 3319 2777
Fax: (07) 3319 2799
Web: www.rbgpt.com



Client: QUINN GROUP

Title: EXTERNAL ROADWORKS
PLANS SHEET 1

Project: OC • EXIT 35

NOT FOR CONSTRUCTION

Date 13.09.07	Design SJ	Checked WM
Scale @ A1 1:250	Drawn JP	Approved WM
Job Number 07365	Drawing Number C9-01	Revision A2

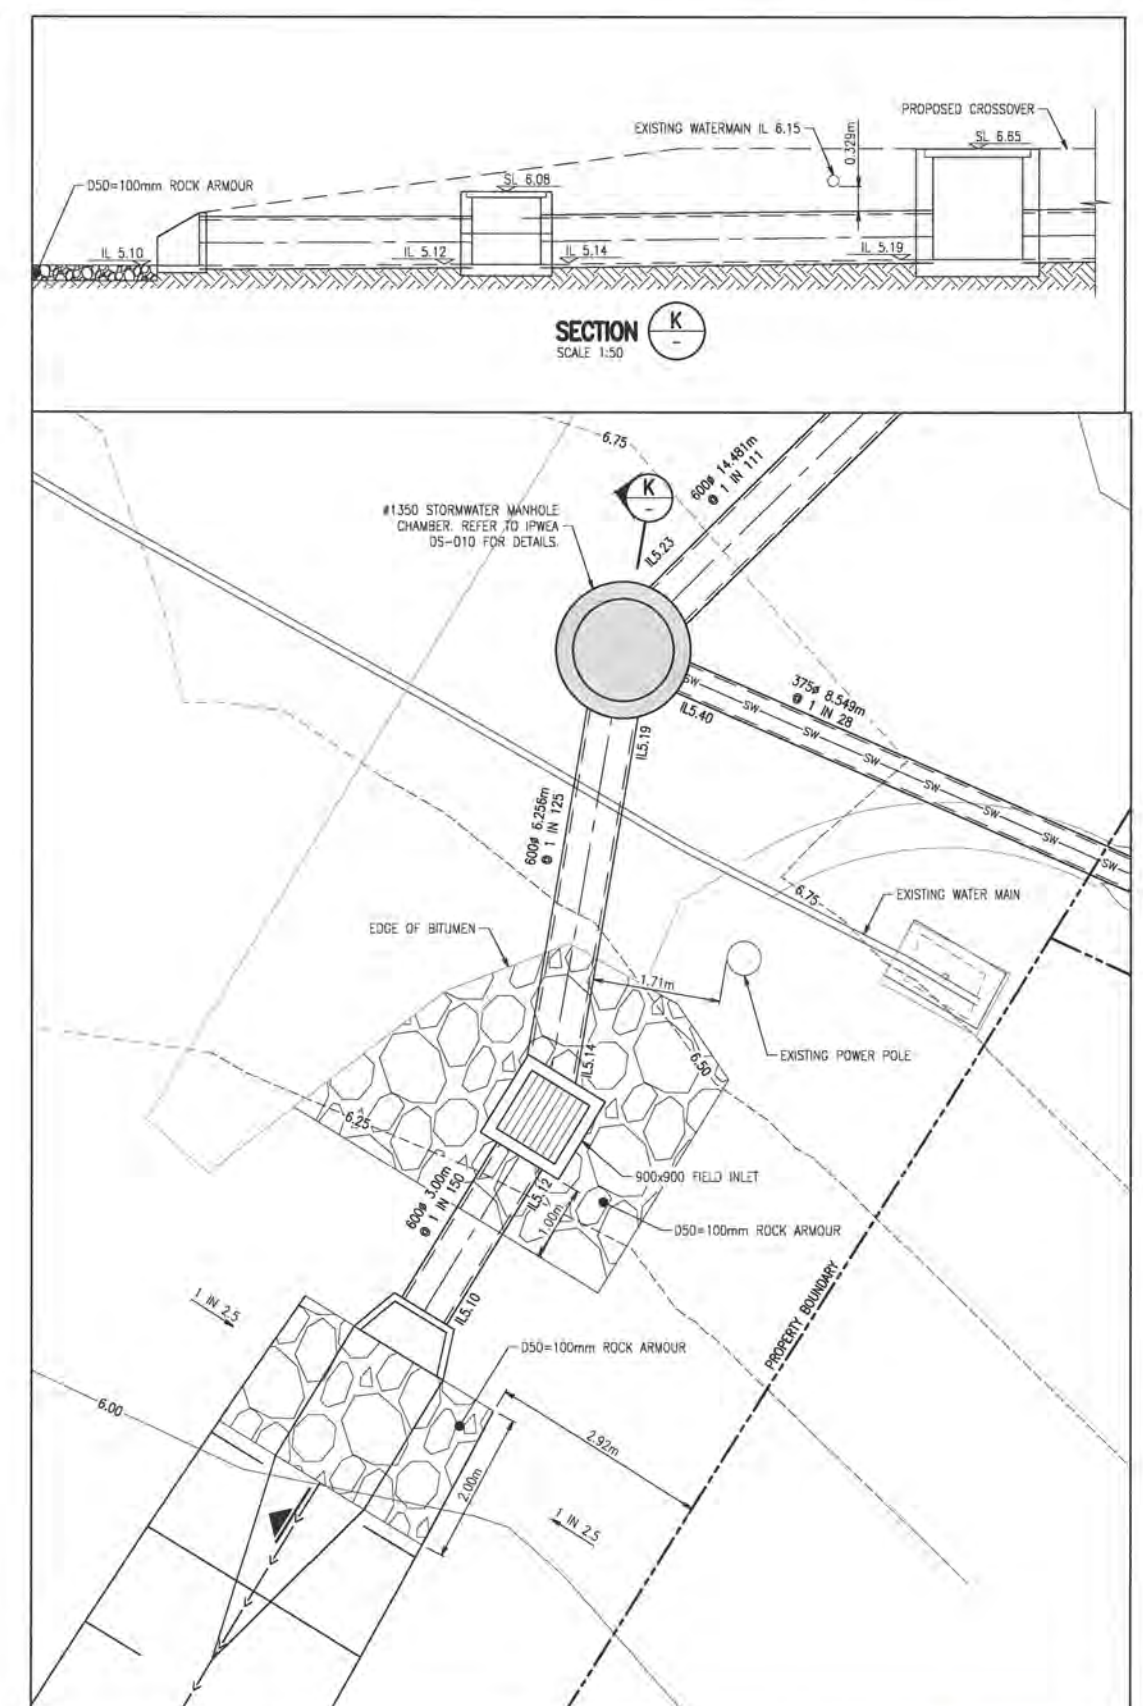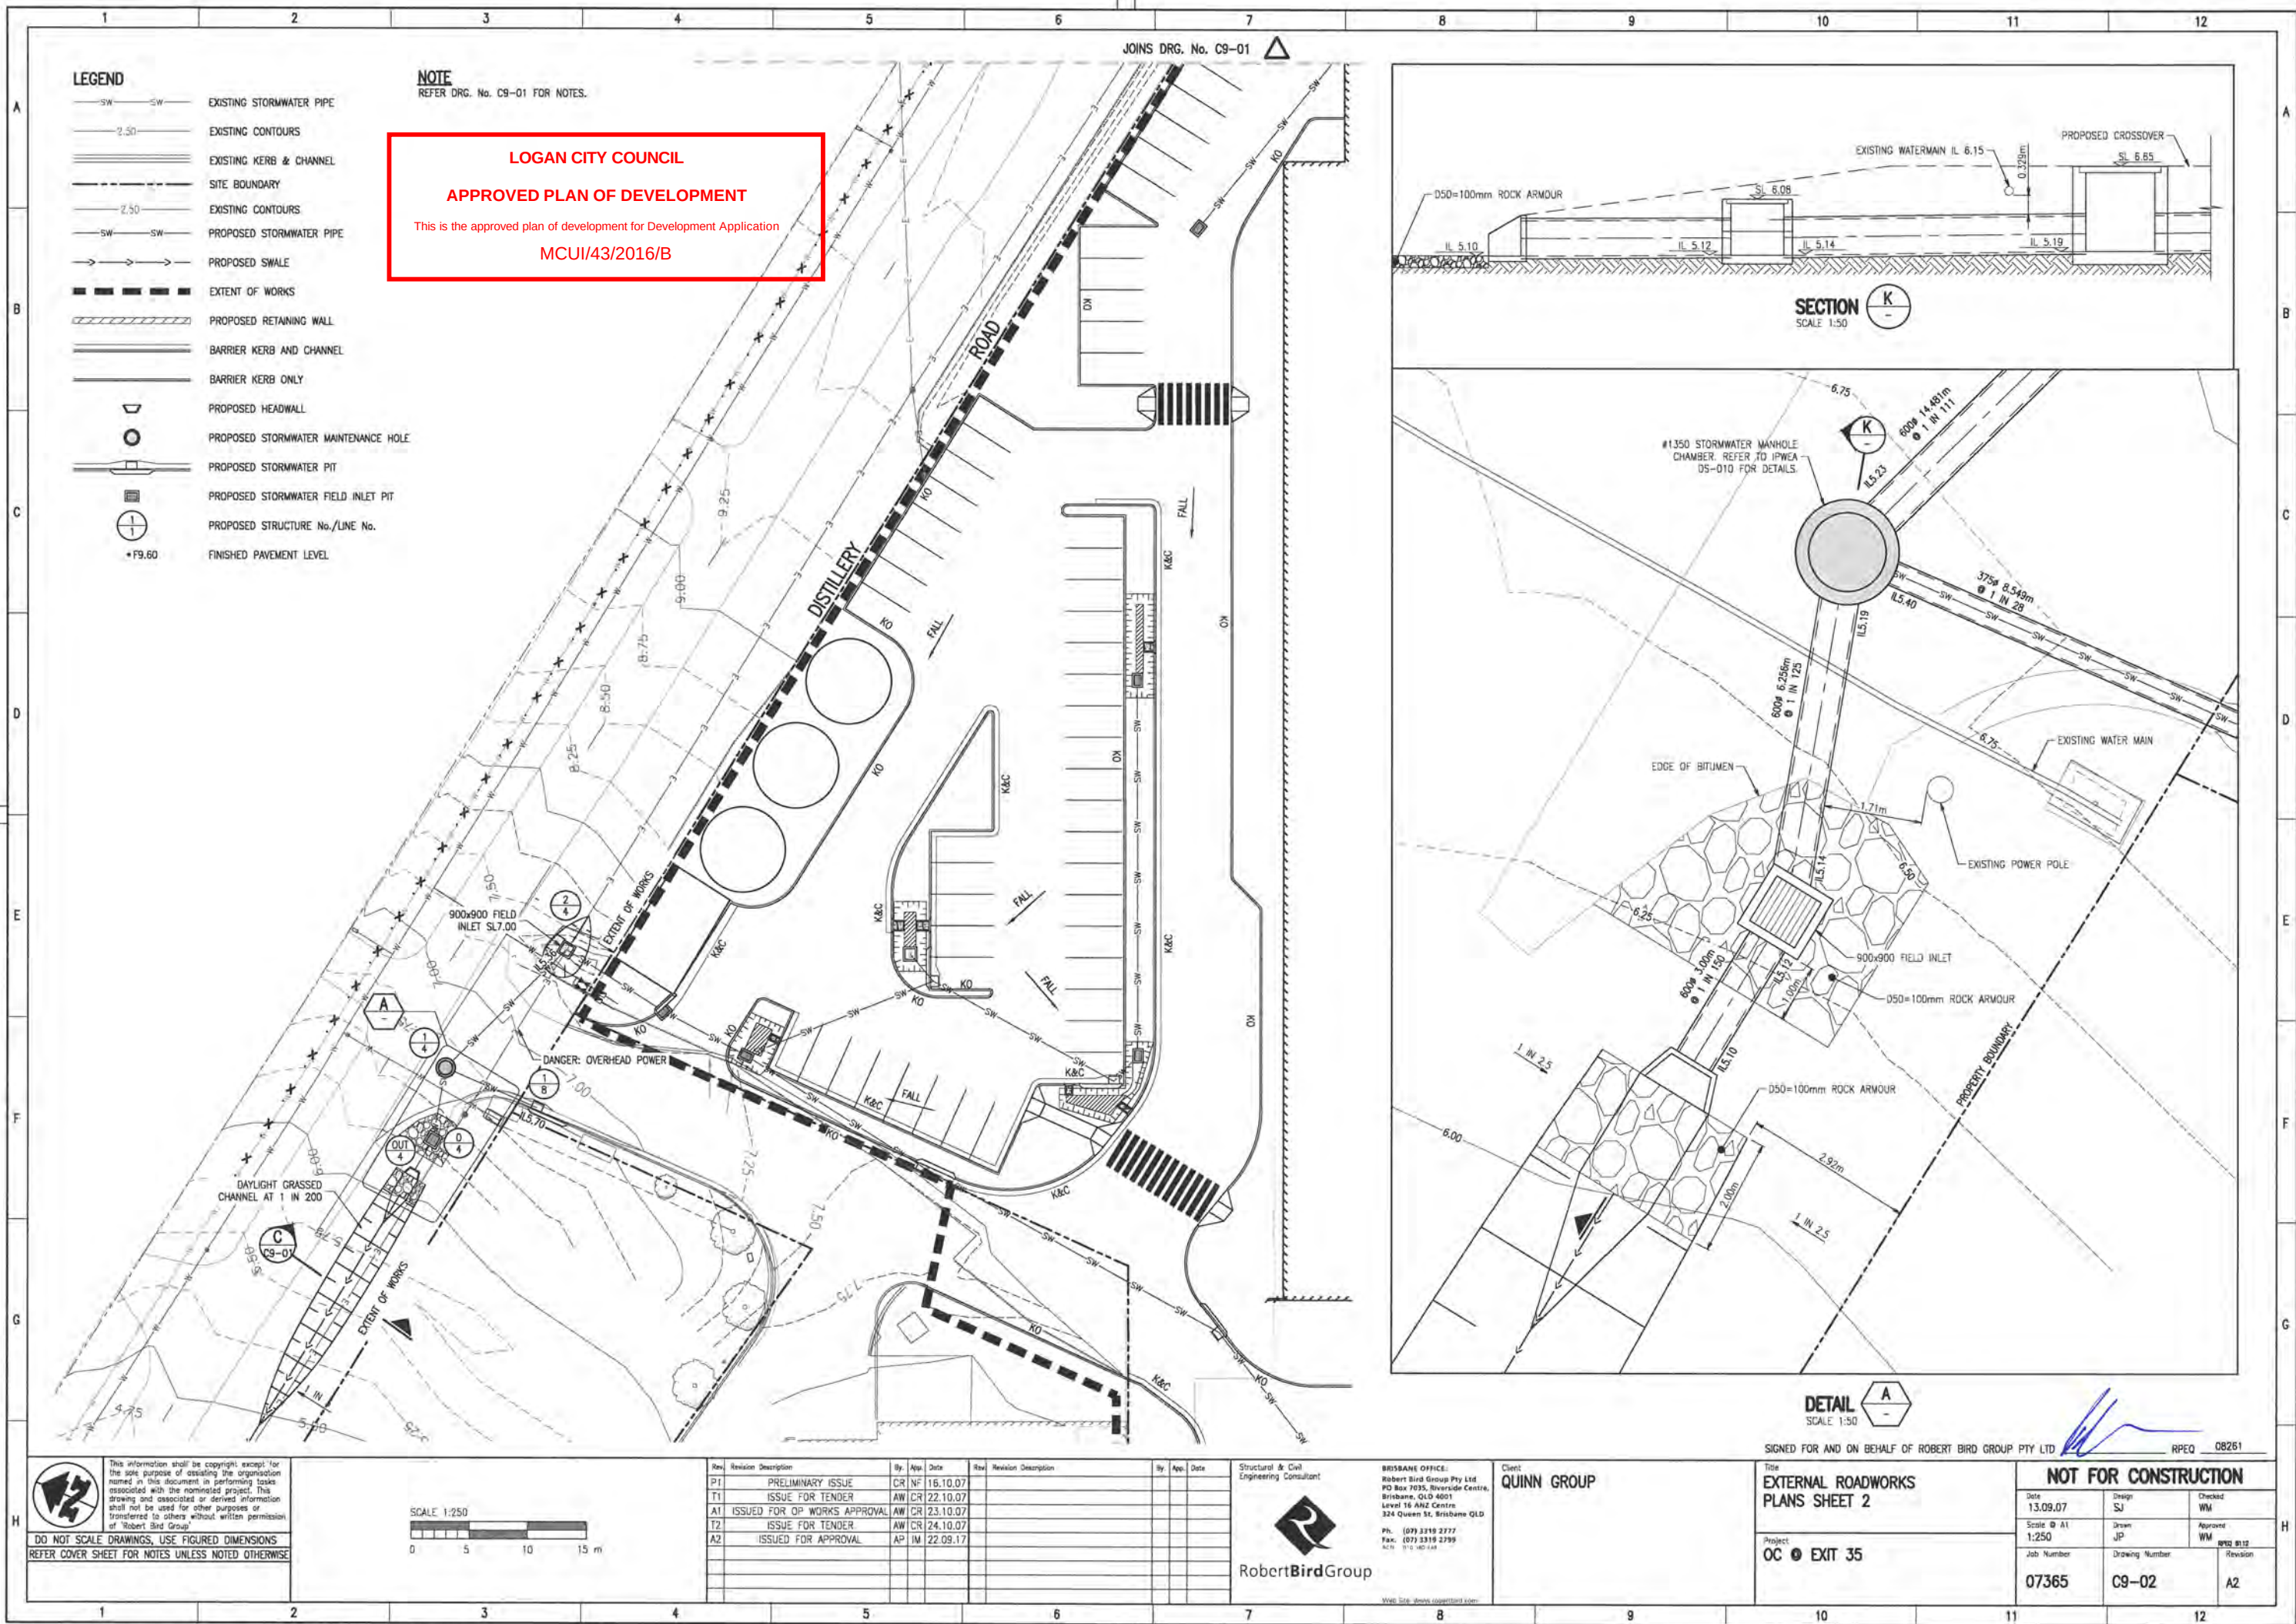

DO NOT SCALE DRAWINGS, USE FIGURED DIMENSIONS
REFER COVER SHEET FOR NOTES UNLESS NOTED OTHERWISE

Rev	Revision Description	By	App	Date	Rev	Revision Description	By	App	Date
P1	PRELIMINARY ISSUE	CR	NF	16.10.07					
T1	ISSUE FOR TENDER	AW	CR	22.10.07					
A1	ISSUED FOR OP WORKS APPROVAL	AW	CR	23.10.07					
T2	ISSUE FOR TENDER	AW	CR	24.10.07					
A2	ISSUED FOR APPROVAL	AP	IM	22.09.17					

Robert Bird Group

BRISBANE OFFICE:
Robert Bird Group Pty Ltd
PO Box 7035, Riverside Centre,
Brisbane, QLD 4001
Level 16 A&Z Centre
324 Queen St, Brisbane QLD

Ph: (07) 2319 2777
Fax: (07) 3319 2799
ALN: 9110 160 148

WWD: See: www.robertbird.com.au

Client: QUINN GROUP

SIGNED FOR AND ON BEHALF OF ROBERT BIRD GROUP PTY LTD RPEQ CB261

EXTERNAL ROADWORKS PLANS SHEET 2		NOT FOR CONSTRUCTION	
Date 13.09.07	Design SJ	Checked WM	
Scale @ A1 1:250	Drawn JP	Approved WM	REV 01/12
Job Number 07365	Drawing Number C9-02	Revision A2	

TYPE 1 - CONCRETE FOOTPATH
REFER GCCC STANDARD DRAWING 05-02-401 FOR DETAILS

TYPE 2 - BITUMEN HEAVY DUTY PAVEMENT
40mm THICK AC DG10 IN ACCORDANCE WITH MRS11.30 OF DMR
7mm BITUMINOUS SURFACE SEAL
125mm THICK CRUSHED ROCK TYPE 2.1 CBR 80 ON
100mm THICK CRUSHED ROCK TYPE 2.3 CBR 45 ON
350mm THICK TYPE 2.5 CBR 15 SUBGRADE REPLACEMENT
BASED ON ASSUMED SUBGRADE CBR 2

PAVEMENT NOTES

1. FINAL PAVEMENT DEPTHS SHALL BE DETERMINED BY THE ENGINEER AFTER SUBGRADE CBR TESTING RESULTS (4 DAY SOAKED) HAVE BEEN CARRIED OUT BY THE CONTRACTOR.
2. ALL PAVEMENT WORKS SHALL BE CARRIED OUT IN ACCORDANCE WITH CIVIL SPECIFICATIONS AND G.C.C.C. STANDARD DRAWINGS UNLESS SHOWN OTHERWISE.
3. THE CONTRACTOR SHALL BE RESPONSIBLE FOR AND INCLUDE COSTS FOR ALL COUNCIL PERMIT FEES AND INSPECTION FEES.
4. PAVEMENT DESIGN IS PROVISIONAL ONLY AND IS SUBJECT TO THE SOAKED CBR TEST. THE SUBGRADE PRELIMINARY PAVEMENT DESIGN ABOVE IS BASED ON AN ASSUMED SUBGRADE OF CBR 2.
5. CONCRETE TO BE GRADE N32, 20 MAX. AGGREGATE SIZE CONCRETE TO BE BROOM FINISHED. REINFORCEMENT TO COMPLY WITH AS1303 FOR PLAIN BARS AND AS1304 FOR WELDED FABRIC. LAP MESH AT 400 & TIE AT SPACING 500mm.
6. FOR DETAILS OF LANDSCAPING TO LANDSCAPED AREAS AND BATTERS REFER TO LANDSCAPE ARCHITECT'S PLANS.

EXTERNAL KERB SETOUT NUMBERS

NUMBER	Position X	Position Y
01	785.289	2935.223
02	796.885	2925.412
03	800.322	2922.222
04	803.444	2918.724
05	806.084	2915.472
06	808.803	2911.966
07	811.364	2908.343
08	816.384	2897.930
09	819.255	2896.637
10	820.127	2895.344
11	825.474	2891.100
12	832.289	2890.711
13	833.951	2891.212
14	843.640	2878.375
15	841.183	2870.243
16	843.879	2862.187

EXISTING TELSTRA PIT DETAIL


SCALE 1:100

JOINS INSET 1 ON DRG. No. C3-02

PROPOSED BUILDING



PROPOSED RETAINING WALL

LINEMARKING LEGEND

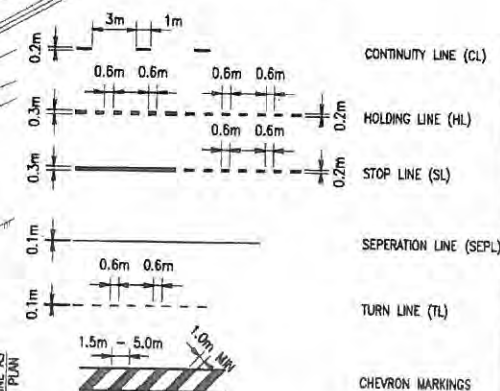

LEGEND

- SITE BOUNDARY
- 2.50- EXISTING CONTOURS
- PROPOSED RETAINING WALL
- K&C BARRIER KERB AND CHANNEL
- KO BARRIER KERB ONLY
- EXISTING KERB & CHANNEL
- +F9.60 FINISHED PAVEMENT LEVEL
- EXTENT OF WORKS

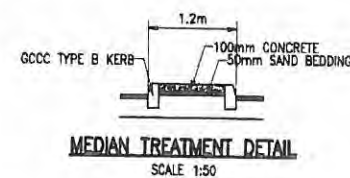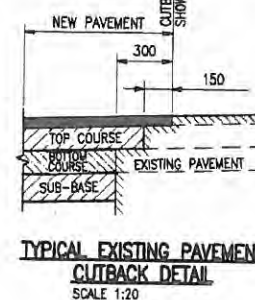

NOTES:

1. PAVEMENT MARKINGS SHALL BE IN ACCORDANCE WITH AS1742 PART 1 - 1975, AS1743 - 1975 AND D.O.T. MANUAL OF UNIFORM TRAFFIC CONTROL DEVICES.
2. ALL SIGNS ARE TO BE IN ACCORDANCE WITH THE D.O.T. MANUAL OF UNIFORM TRAFFIC CONTROL DEVICES.
3. ISLAND NOSES TO BE PAINTED WITH REFLECTORIZED PAINT (TYPICAL).
4. RRPV'S TO BE PLACED AS PER MUTCD PART 2 SECTION 4.6.
5. EXISTING LINEMARKING TO BE REMOVED AS REQUIRED.

LOGAN CITY COUNCIL

APPROVED PLAN OF DEVELOPMENT

This is the approved plan of development for Development Application

MCUW43/2016/B

This information shall be copyright except for the sole purpose of enabling the organization named in this document in performing tasks associated with the nominated project. This drawing and associated or derived information shall not be used for other purposes or transferred to others without written permission of Robert Bird Group.

DO NOT SCALE DRAWINGS. USE FIGURED DIMENSIONS. REFER COVER SHEET FOR NOTES UNLESS NOTED OTHERWISE.

SCALE 1:250



Rev.	Revision Description	By	App.	Date	Rev.	Revision Description	By	App.	Date
P1	PRELIMINARY ISSUE	CR	MF	16.10.07					
T1	ISSUE FOR TENDER	AW	CR	22.10.07					
A1	ISSUED FOR OP WORKS APPROVAL	AW	CR	23.10.07					
T2	ISSUE FOR TENDER	AW	CR	24.10.07					
A2	ISSUE FOR OP WORKS APPROVAL	AW	CR	26.11.07					
C1	ISSUED FOR CONSTRUCTION	AW	CR	12.03.07					
C2	ISSUED FOR CONSTRUCTION	AW	CR	21.05.08					

Structural & Civil Engineering Consultant

Robert Bird Group

BRISBANE OFFICE:
Robert Bird Group Pty Ltd
PO Box 7015, Riverside Centre,
Brisbane, QLD 4001
Level 14, ABC Centre
324 Queen St, Brisbane QLD


Ph: (07) 3219 2777
Fax: (07) 3219 2799
A/C: 0 10 11

Client: **QUINN GROUP**

Title: **EXTERNAL ROADWORKS
PLAN SHEET 3 OF 4**

Project: **OC @ EXIT 35**


APPROVED FOR CONSTRUCTION			
Date 13.09.07	Design SJ	Checked CR	
Scale @ A1 1:250	Drawn JP	Approved	
Job Number 07365	Drawing Number C9-03	Revision C2	

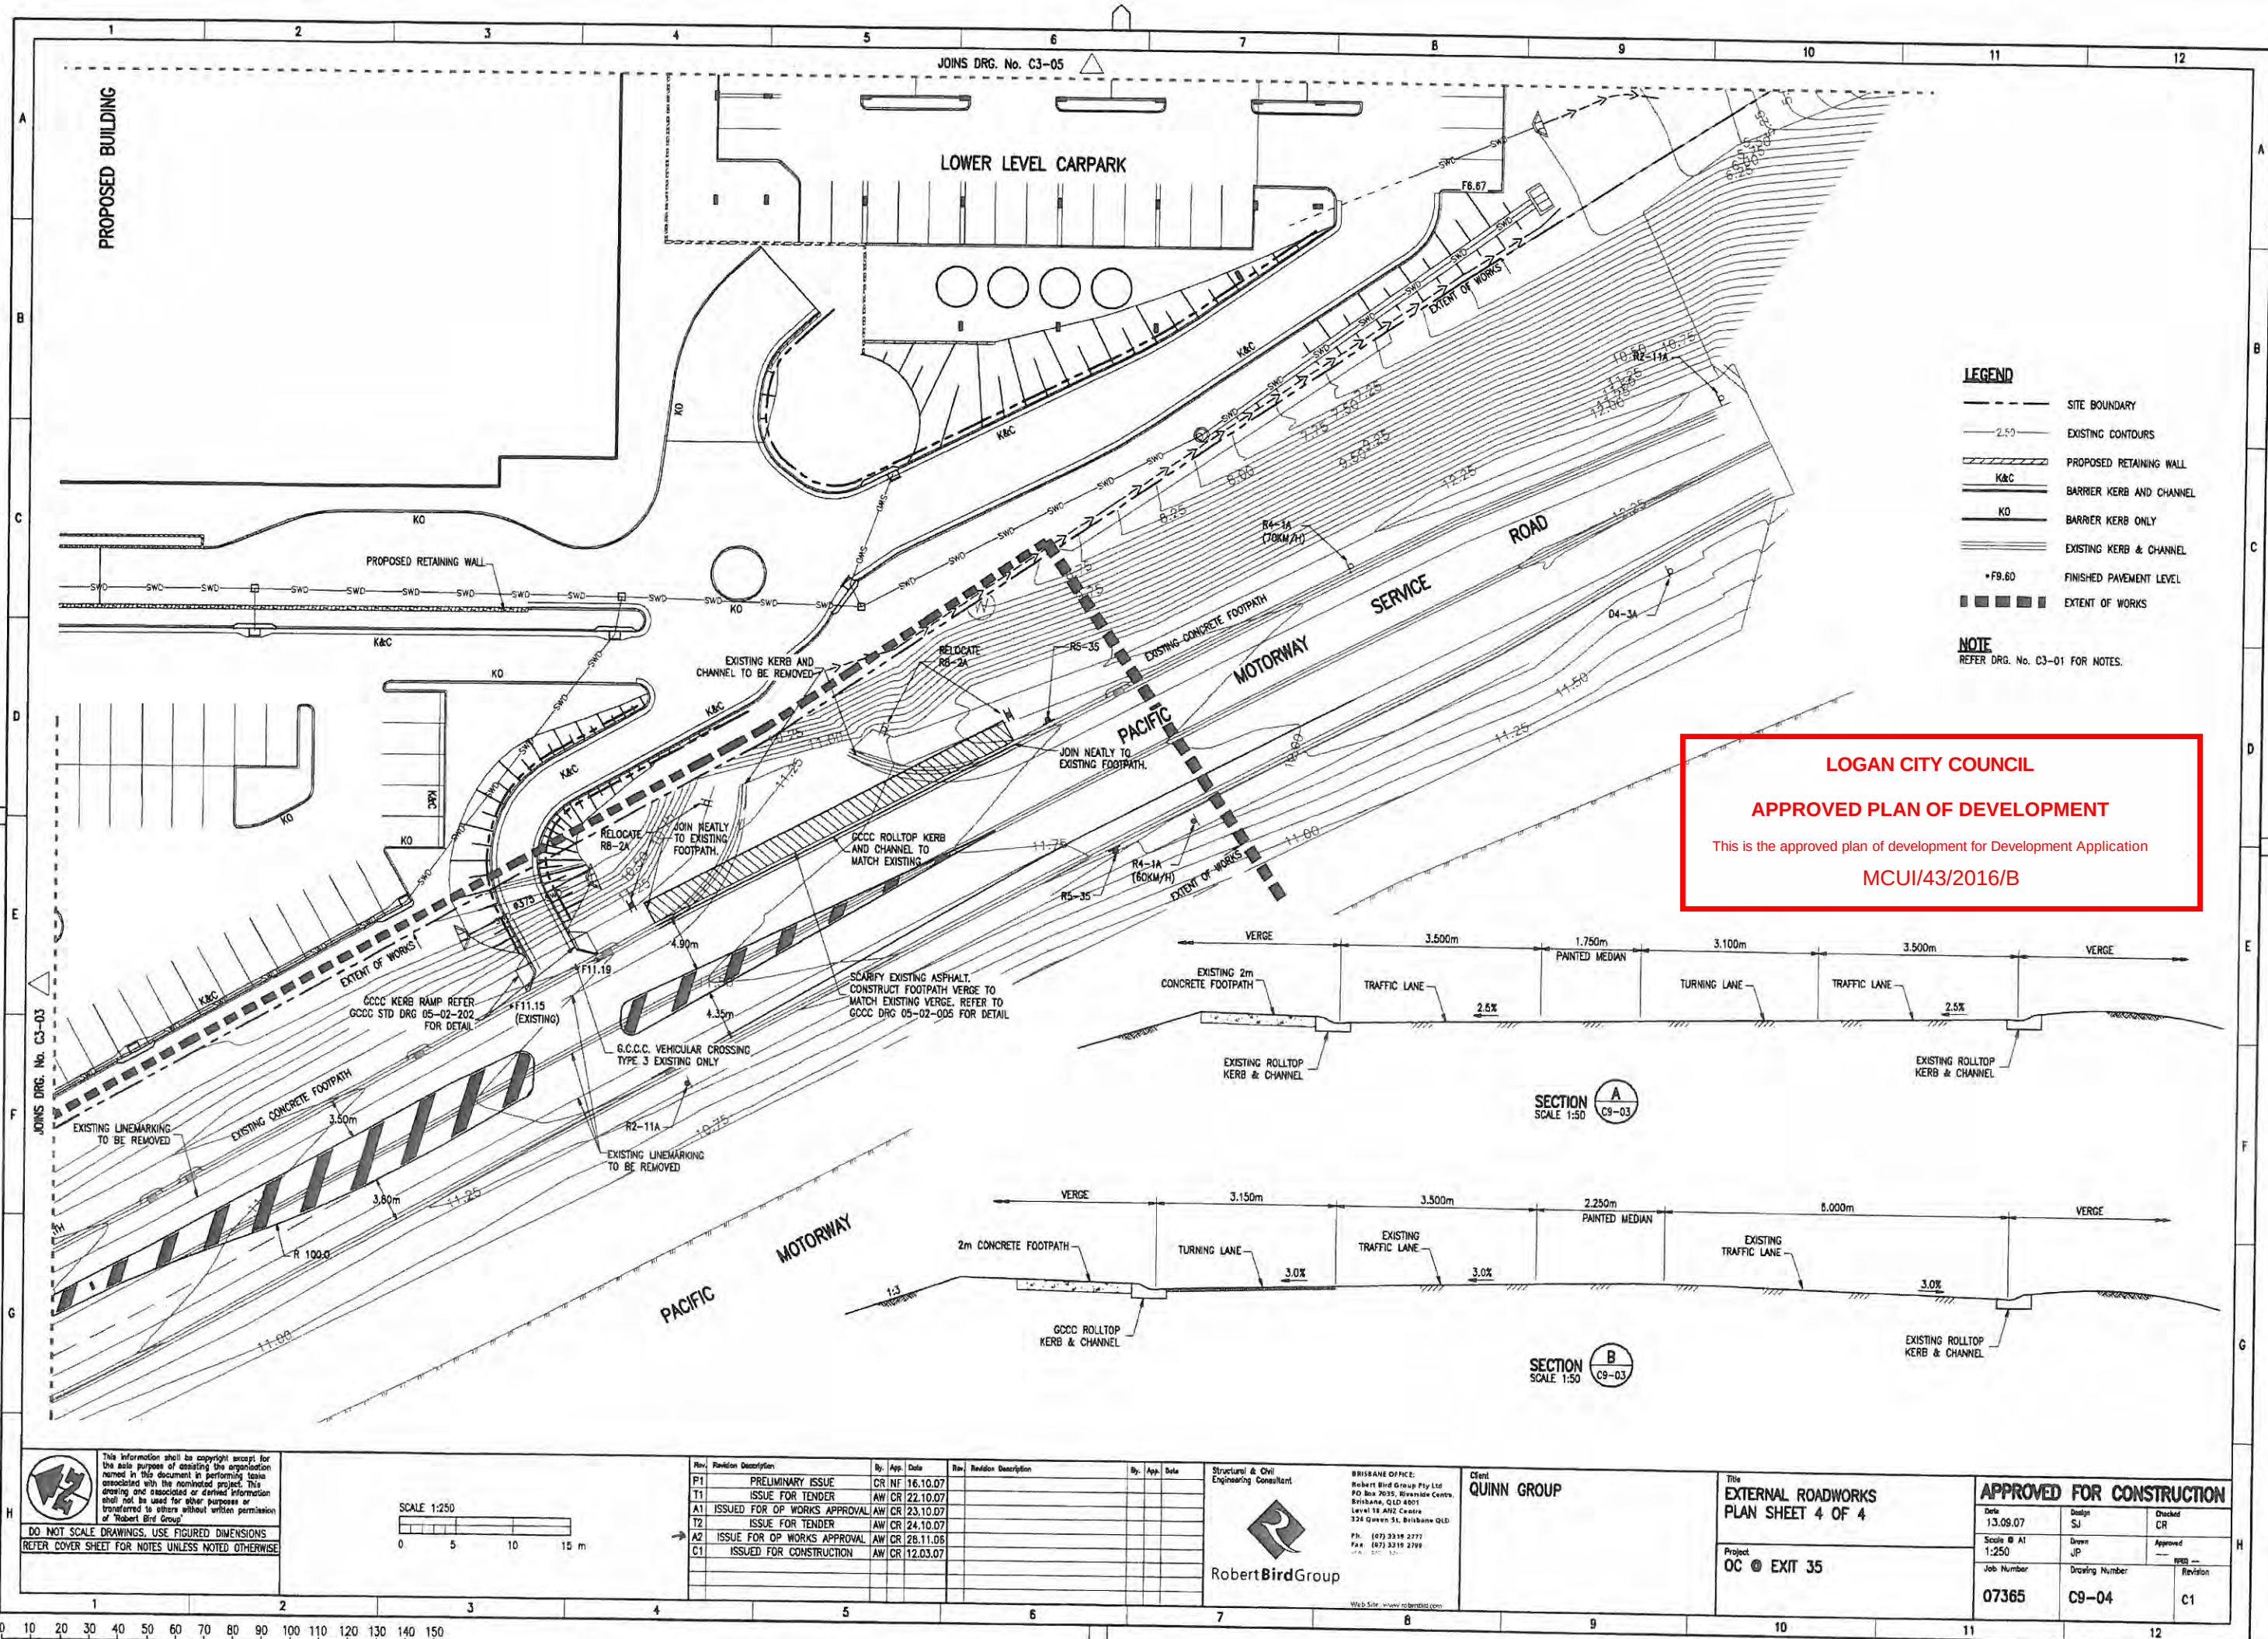

LOGAN CITY COUNCIL
APPROVED PLAN OF DEVELOPMENT
This is the approved plan of development for Development Application
MCUI/43/2016/B

This information shall be copyright except for the sole purpose of assisting the organisation named in this document in performing tasks associated with the nominated project. This drawing and associated or derived information shall not be used for other purposes or transferred to others without written permission of Robert Bird Group.

DO NOT SCALE DRAWINGS, USE FIGURED DIMENSIONS
REFER COVER SHEET FOR NOTES UNLESS NOTED OTHERWISE

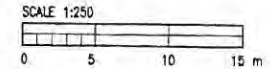

Rev.	Revision Description	By	App. Date	Rev.	Revision Description	By	App. Date
P1	PRELIMINARY ISSUE	CR	16.10.07				
T1	ISSUE FOR TENDER	AW	22.10.07				
A1	ISSUED FOR OP WORKS APPROVAL	AW	23.10.07				
T2	ISSUE FOR TENDER	AW	24.10.07				
A2	ISSUE FOR OP WORKS APPROVAL	AW	28.11.06				
C1	ISSUED FOR CONSTRUCTION	AW	12.03.07				

Structural & Civil Engineering Consultant

Robert Bird Group


BRISBANE OFFICE:
Robert Bird Group Pty Ltd
PO Box 2635, Riverside Centre,
Brisbane, QLD 4001
Level 18 AND Centre
324 Queen St, Brisbane QLD
Ph: (07) 3310 2777
Fax: (07) 3310 2788
Web Site: www.rbg.com.au


Client: **QUINN GROUP**

Project: **OC @ EXIT 35**

Title: **EXTERNAL ROADWORKS
PLAN SHEET 4 OF 4**

Date: 13.09.07	Design: SJ	Checked: CR
Scale: A1 1:250	Drawn: JP	Approved: [Signature]
Job Number: 07365	Drawing Number: C9-04	Revision: C1

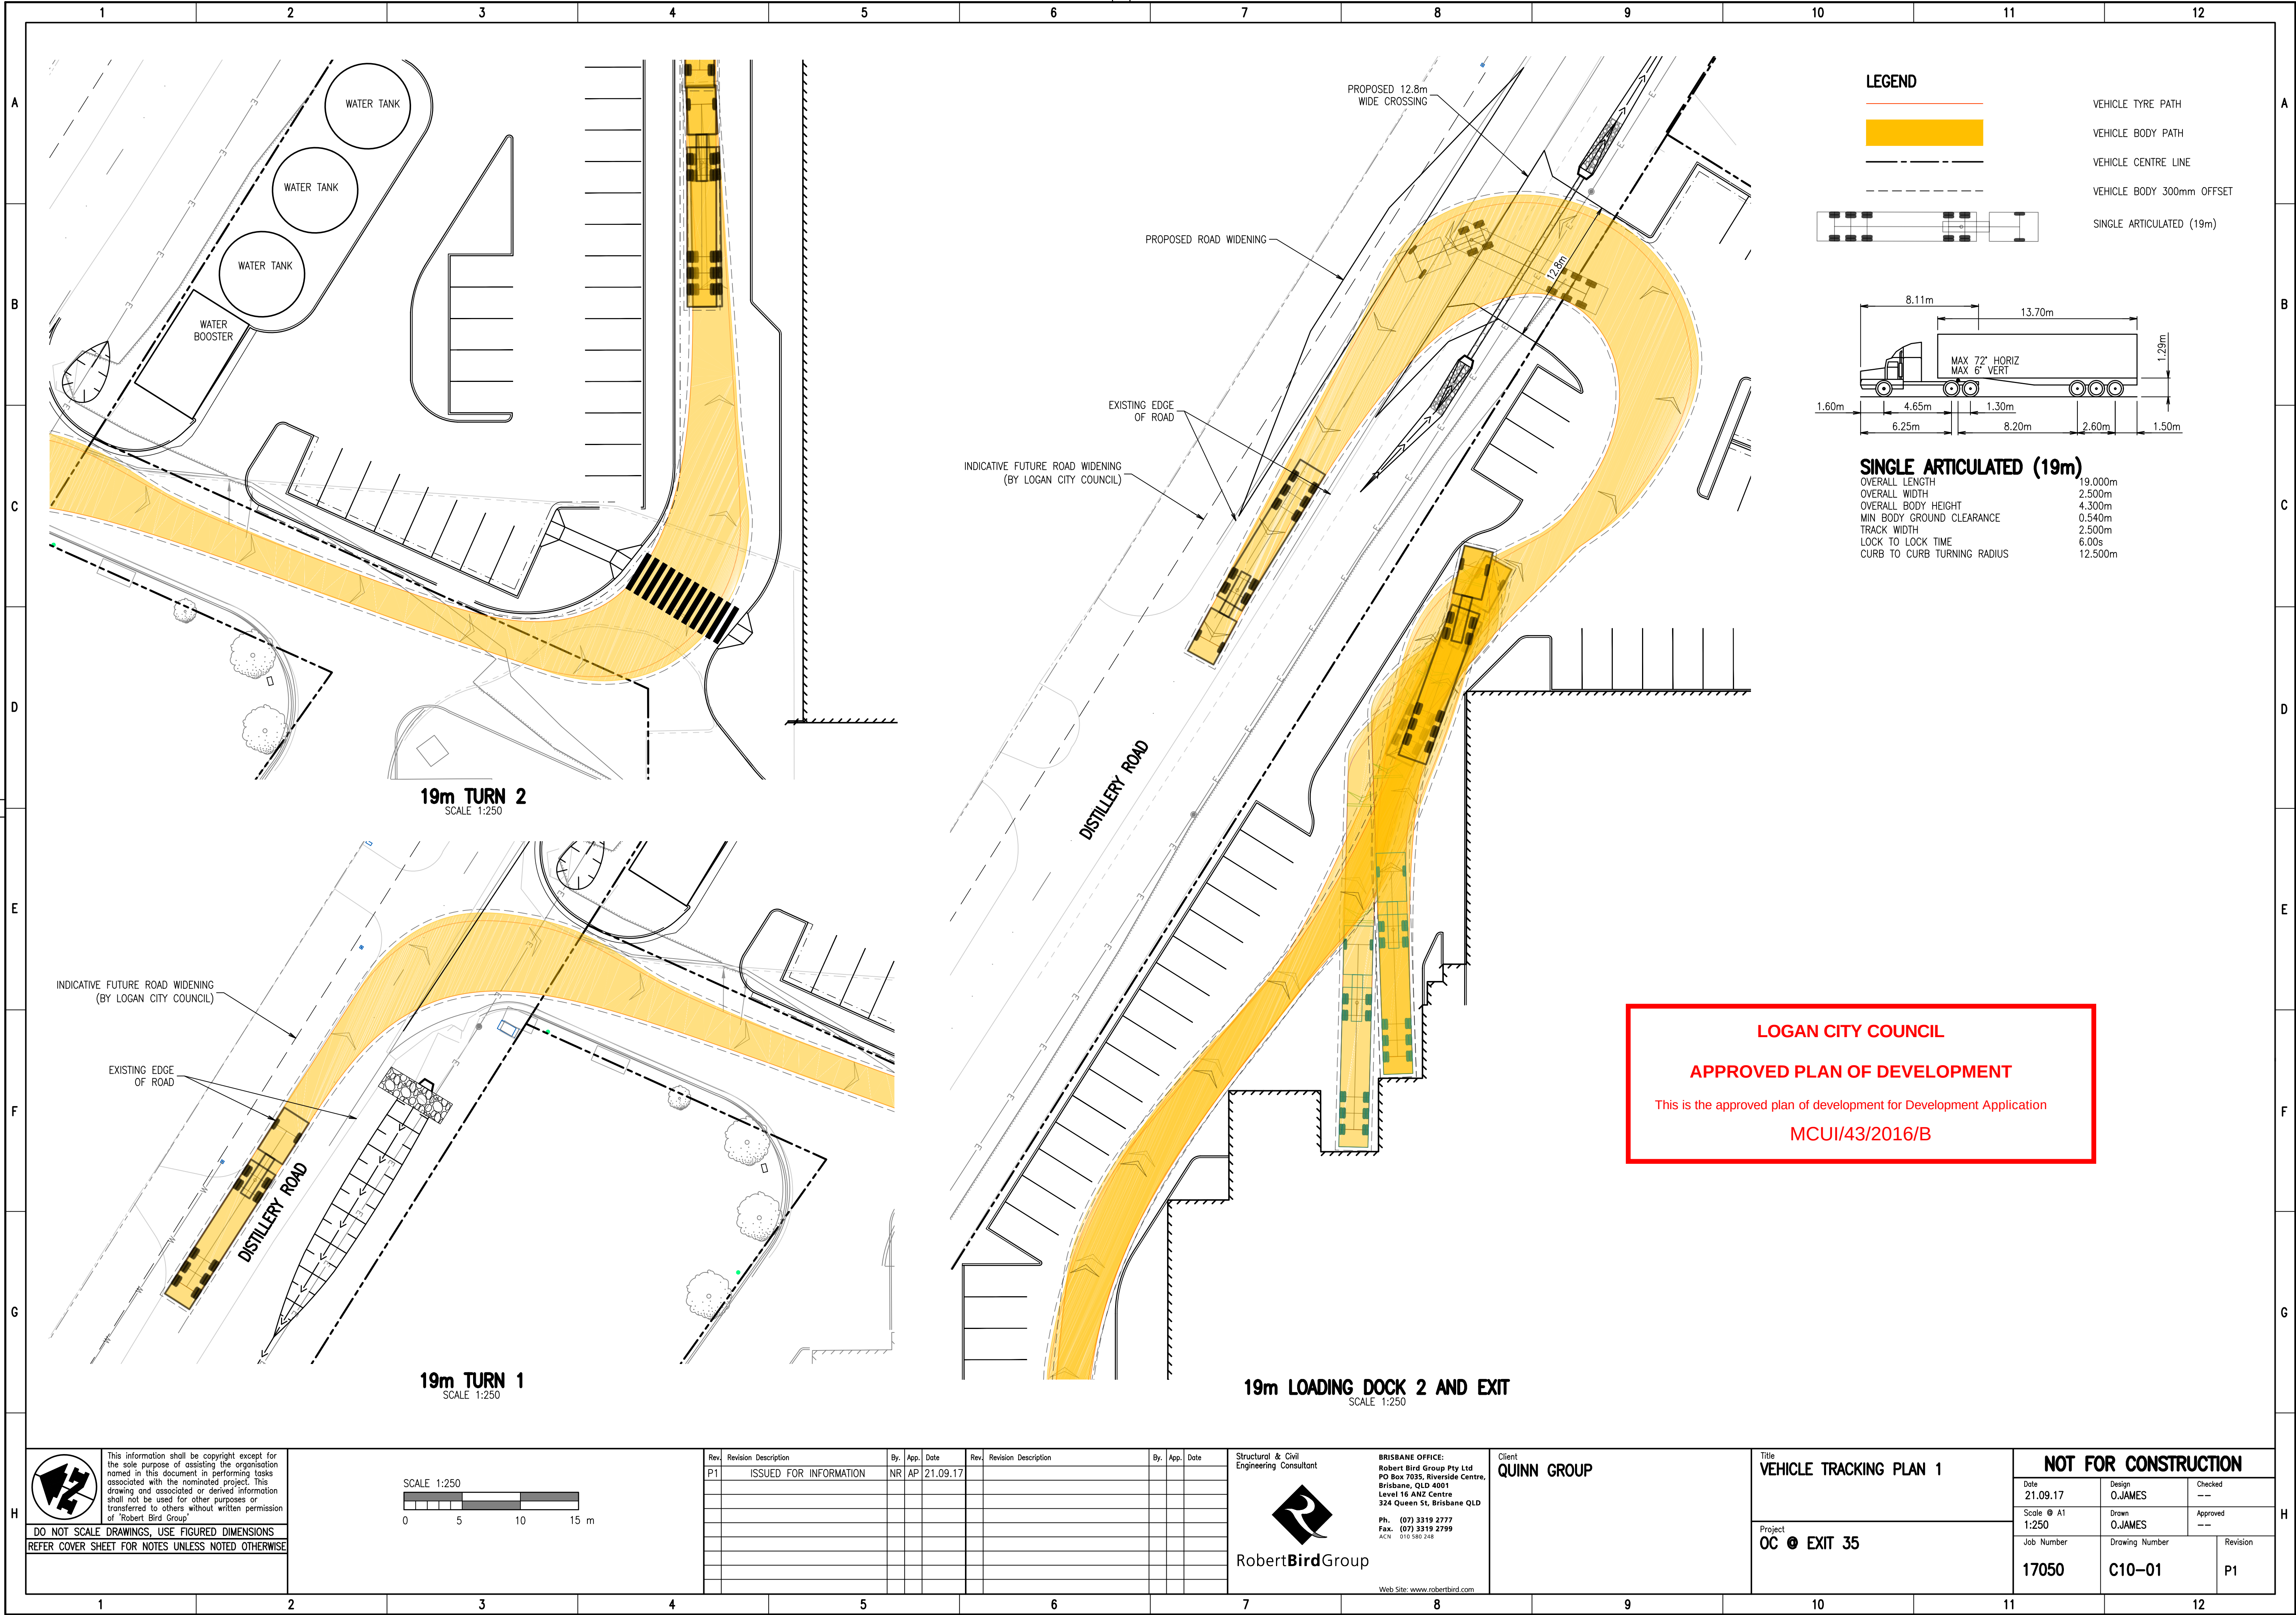


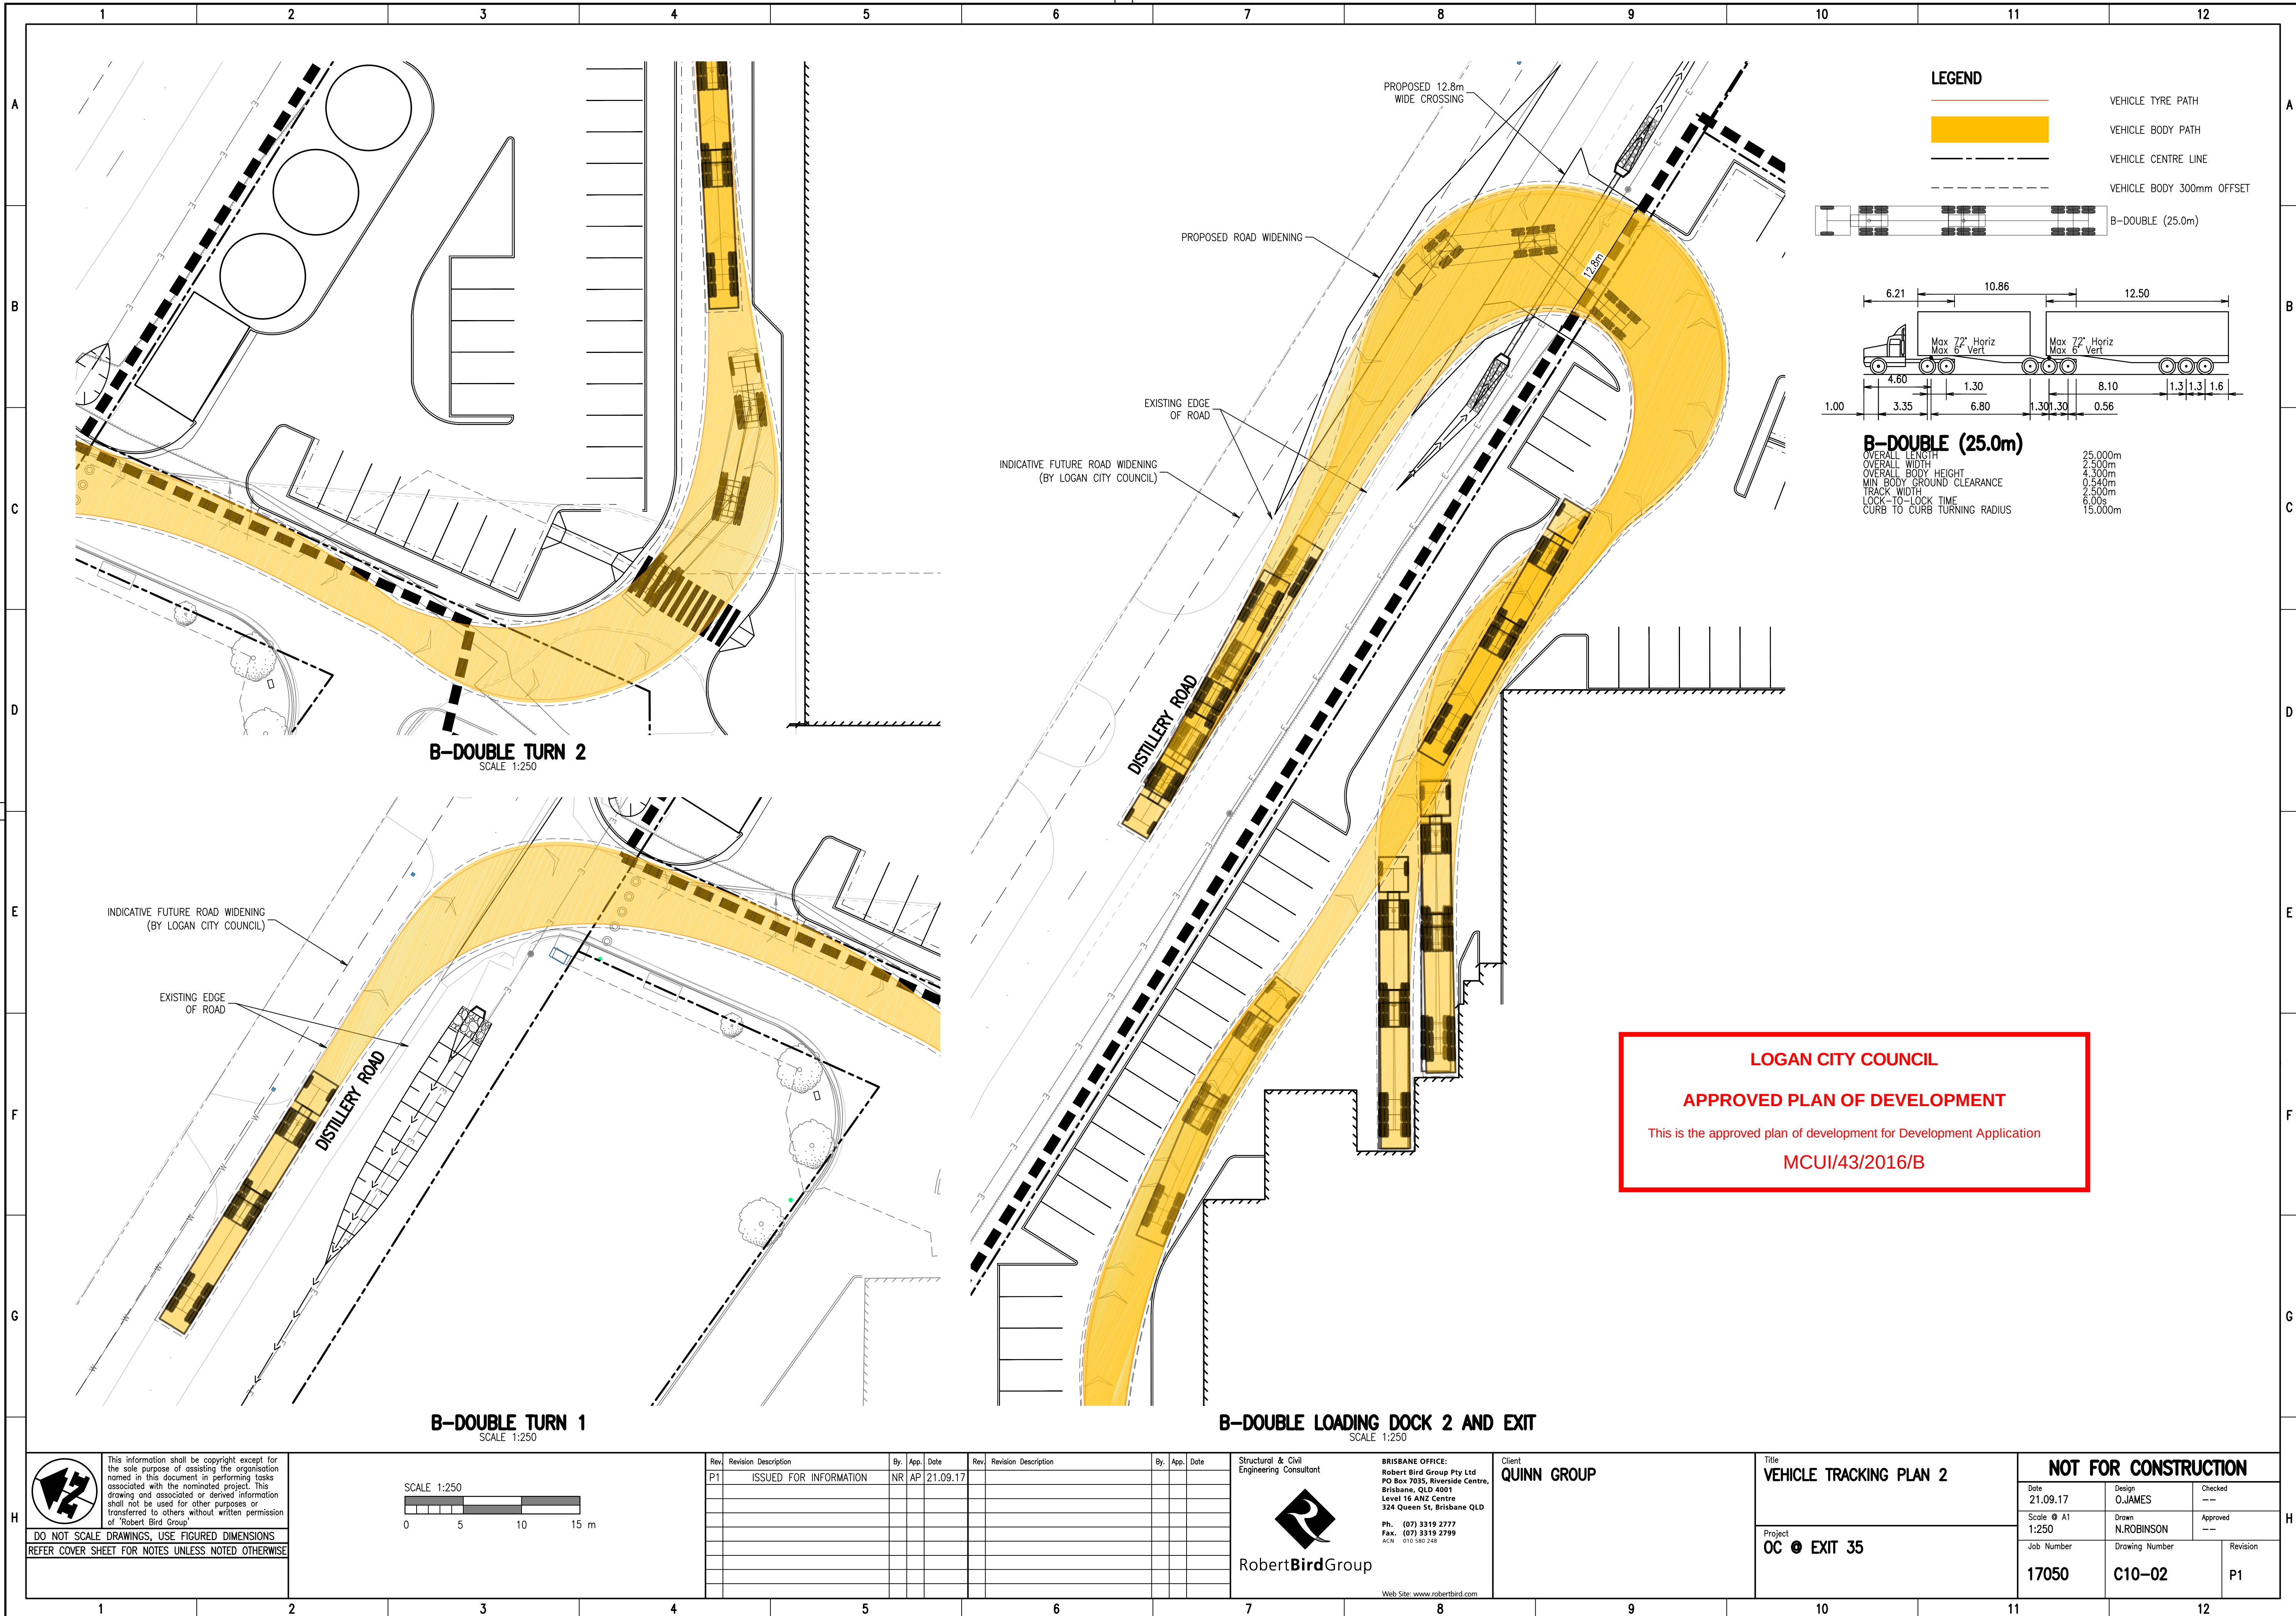

This information shall be copyright except for the sole purpose of assisting the organisation named in this document in performing tasks associated with the nominated project. This drawing and associated or derived information shall not be used for other purposes or transferred to others without written permission of Robert Bird Group

DO NOT SCALE DRAWINGS, USE FIGURED DIMENSIONS

REFER COVER SHEET FOR NOTES UNLESS NOTED OTHERWISE

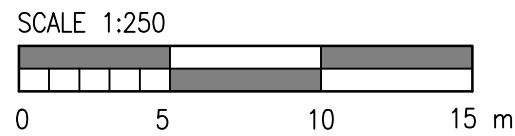

Rev.	Revision Description	By.	App.	Date	Rev.	Revision Description	By.	App.	Date
P1	ISSUED FOR INFORMATION	NR	AP	21.09.17					

Structural & Civil
Engineering Consultant



RobertBirdGroup

BRISBANE OFFICE:
Robert Bird Group Pty Ltd
PO Box 7035, Riverside Centre,
Brisbane, QLD 4001
Level 16 ANZ Centre
324 Queen St, Brisbane QLD

Ph. (07) 3319 2777
Fax. (07) 3319 2799
ACN 010 580 248

Web Site: www.robertbird.com

Client
QUINN GROUP

Title
VEHICLE TRACKING PLAN 2

Project
OC @ EXIT 35

NOT FOR CONSTRUCTION

Date 21.09.17	Design O.JAMES	Checked ---
Scale @ A1 1:250	Drawn N.ROBINSON	Approved ---
Job Number 17050	Drawing Number C10-02	Revision P1