


PLANNING SCHEDULE
10
B33722
BLACKWATER
HUMBOLDT
4201m²

Lot Number
Plan Number
Parish
County
Area

CONSTRUCTED

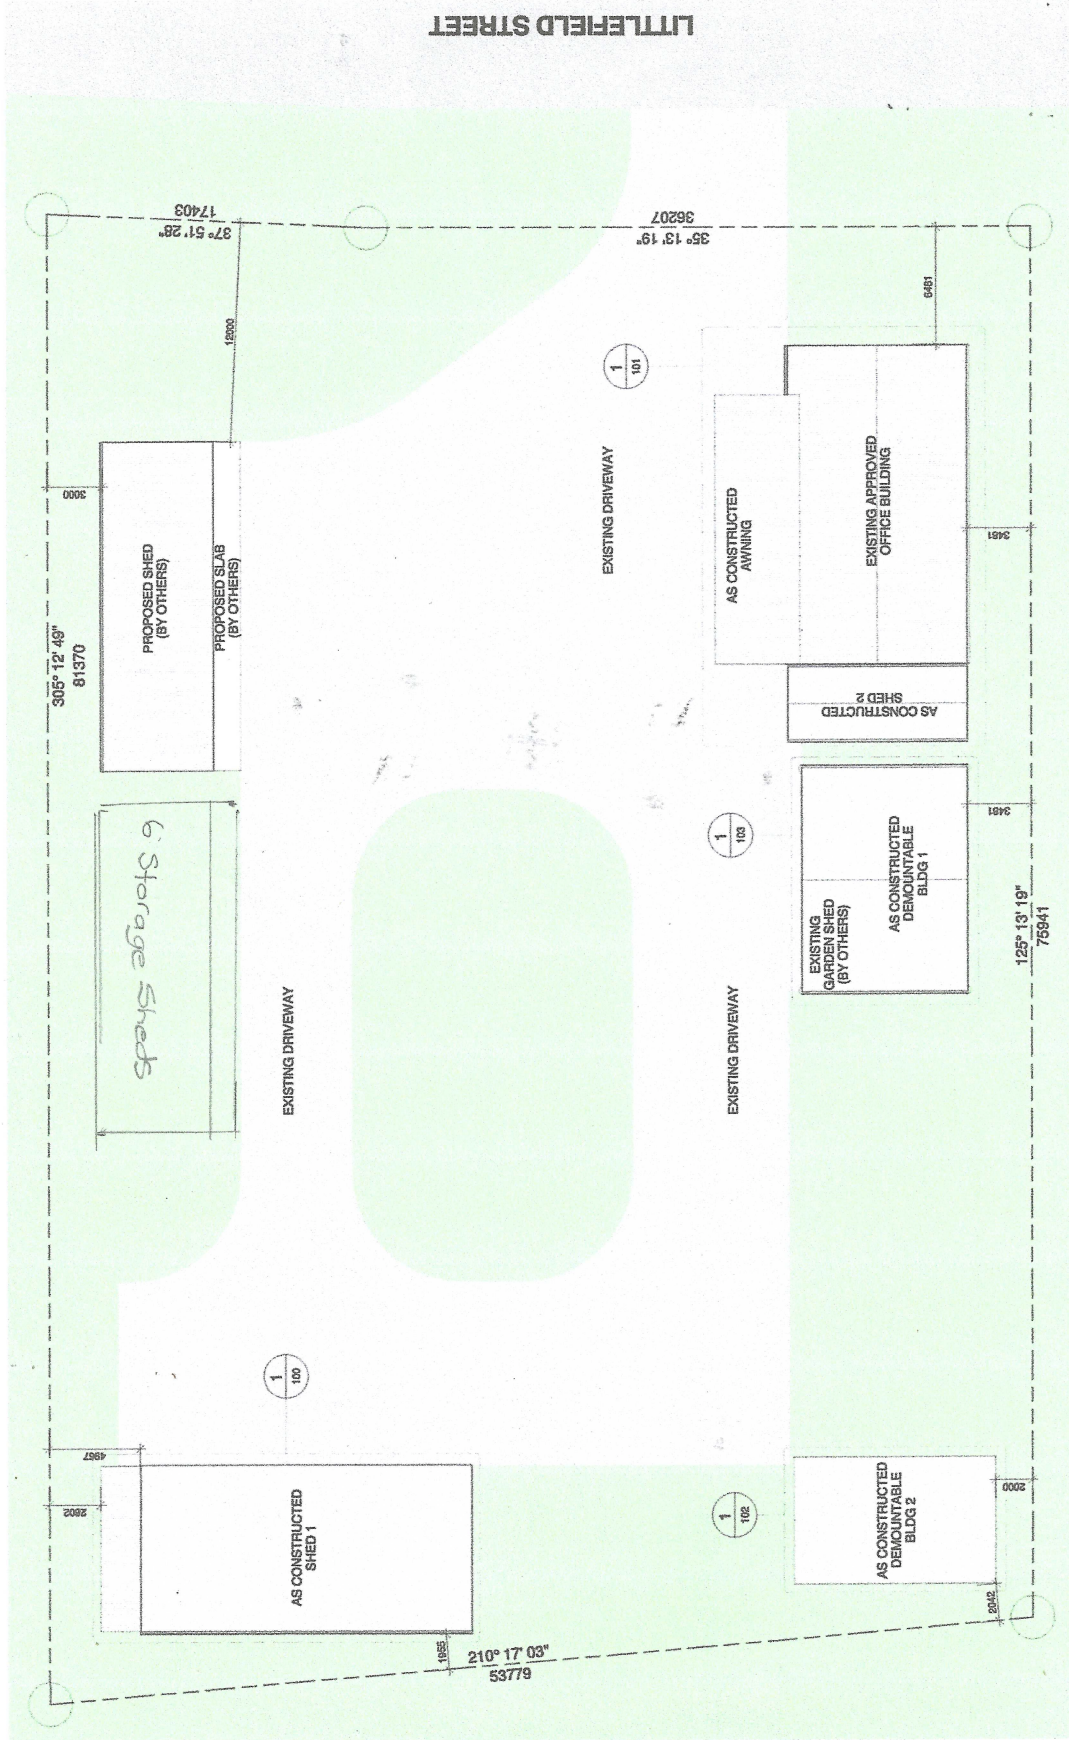

LITTLEFIELD STREET

Digitally signed by Hasha R.W.
DN: cn=Hasha R.W.,
o=Greiner Developments
PY Ltd. ou,
email=hasha@greiner.co
mail=C=AU
Date: 2018.10.31 23:11:50
+1000'



AS CONSTRUCTED

Structures for Trevor Renata

ADDRESS

18 Littlefield St, Blackwater

DRAWING

Site Plan

CAPRICORN ENGINEERING
AND DRAFTING SERVICES

PO Box 1724, Yeppoon, QLD, 4703
(07) 4662 2222
www.capricorn-engineering.com.au
BRAB - 1132854

DRAWN BY: TJE
CHECKED BY: HRW
DATE: 23.10.18

SCALE: As Indicated
PROJECT STATUS: As Constructed

DRAWING No: 18-220-C
SHEET No: 001