


**CERTIFICATES OF COMPLIANCE ARE NOT TRANSFERABLE
AS CONSTRUCTED DRAWING**

RECORD COMPLETE YES / NO

OWNER JOHN SMITH HOUSE No. LOT No. 731 STREET BROWN AVENUE SUBURB GREENTOWN TIE TO CROSS STREET SOUTH WEST CORNER OF GREY TERRACE	<p align="center"><u>SUITABLY QUALIFIED PERSON</u></p> PRINT NAME DARREN BLACK DATE SUBMITTED 10/10/2013 TRADING NAME DARREN BLACK PLUMBING TELEPHONE / MOBILE 0444 444 444 <hr/> <div style="display: flex; justify-content: space-between;"> <div> LICENCE NUMBER <div style="border: 1px solid black; padding: 2px; display: inline-block;">246822</div> </div> <div> CERTIFICATE NUMBER <div style="border: 1px solid black; padding: 2px; display: inline-block;">765432A</div> </div> </div>
--	---

I certify that this plan shows the layout and dimensions of the property wastewater system as measured and drawn by me or under my supervision at the above address.

Signature *D. Black*

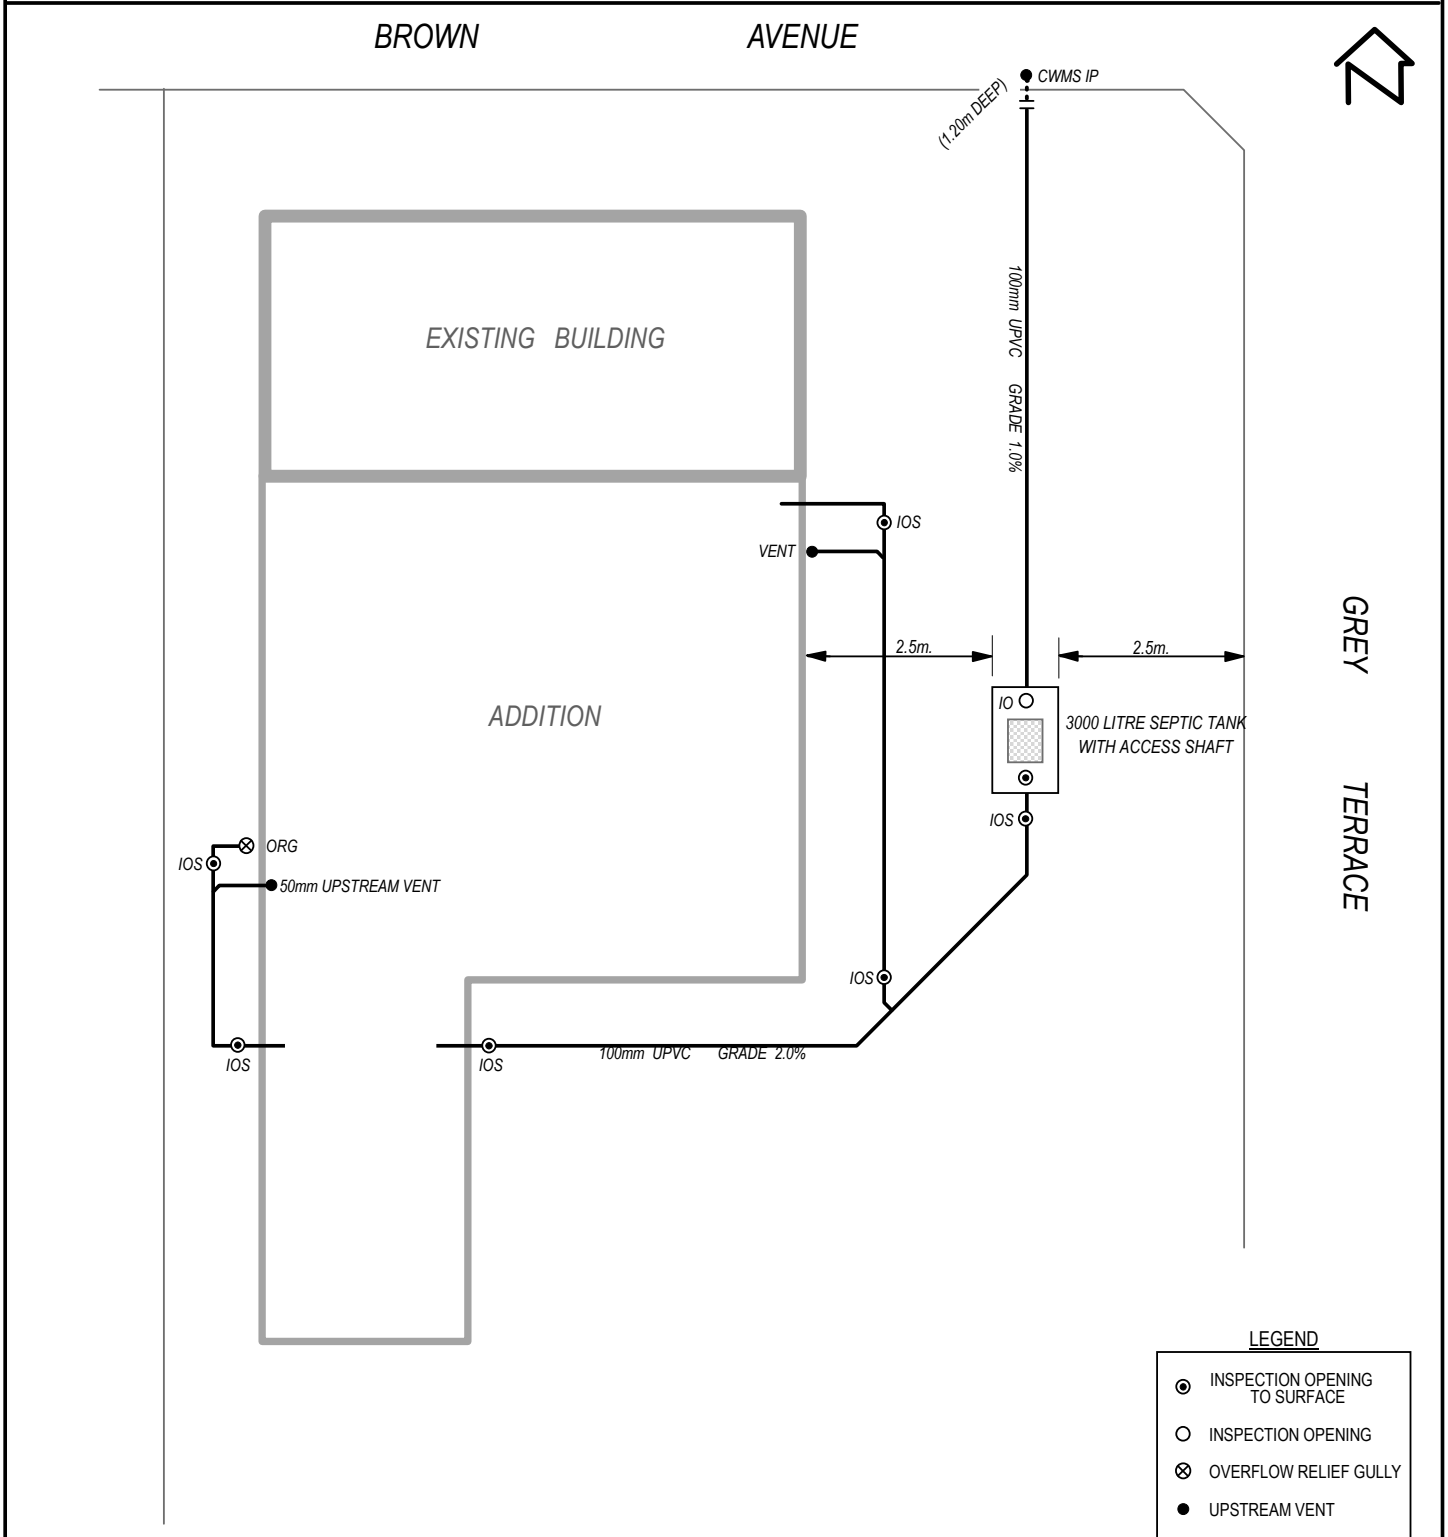

LEGEND

- ⊙ INSPECTION OPENING TO SURFACE
- INSPECTION OPENING
- ⊗ OVERFLOW RELIEF GULLY
- UPSTREAM VENT

DATE RECEIVED	IMPORTANT: USE BLACK BALLPOINT PEN ONLY FORWARD DRAWING AND CERTIFICATE TO RELEVANT AUTHORITY	PAGE
----------------------	--	-------------


**CERTIFICATES OF COMPLIANCE ARE NOT TRANSFERABLE
AS CONSTRUCTED DRAWING**

RECORD COMPLETE YES / NO

OWNER JOHN SMITH HOUSE No. LOT No. 256 STREET BRISCOE STREET SUBURB BLACKBERRY TIE TO CROSS STREET	<p align="center"><u>SUITABLY QUALIFIED PERSON</u></p> PRINT NAME IAN PLUMBER DATE SUBMITTED 11/11/2012 TRADING NAME DRAIN PLUMBING SERVICES TELEPHONE / MOBILE 0432 123 123				
	<table border="1" style="width:100%; border-collapse: collapse;"> <tr> <td style="width:50%; text-align: center;">LICENCE NUMBER</td> <td style="width:50%; text-align: center;">CERTIFICATE NUMBER</td> </tr> <tr> <td align="center">1 4 3 8 5 2</td> <td align="center">8 1 2 3 4 5 A</td> </tr> </table>	LICENCE NUMBER	CERTIFICATE NUMBER	1 4 3 8 5 2	8 1 2 3 4 5 A
LICENCE NUMBER	CERTIFICATE NUMBER				
1 4 3 8 5 2	8 1 2 3 4 5 A				

I certify that this plan shows the layout and dimensions of the property wastewater system as measured and drawn by me or under my supervision at the above address.

Signature *I. Plumber*

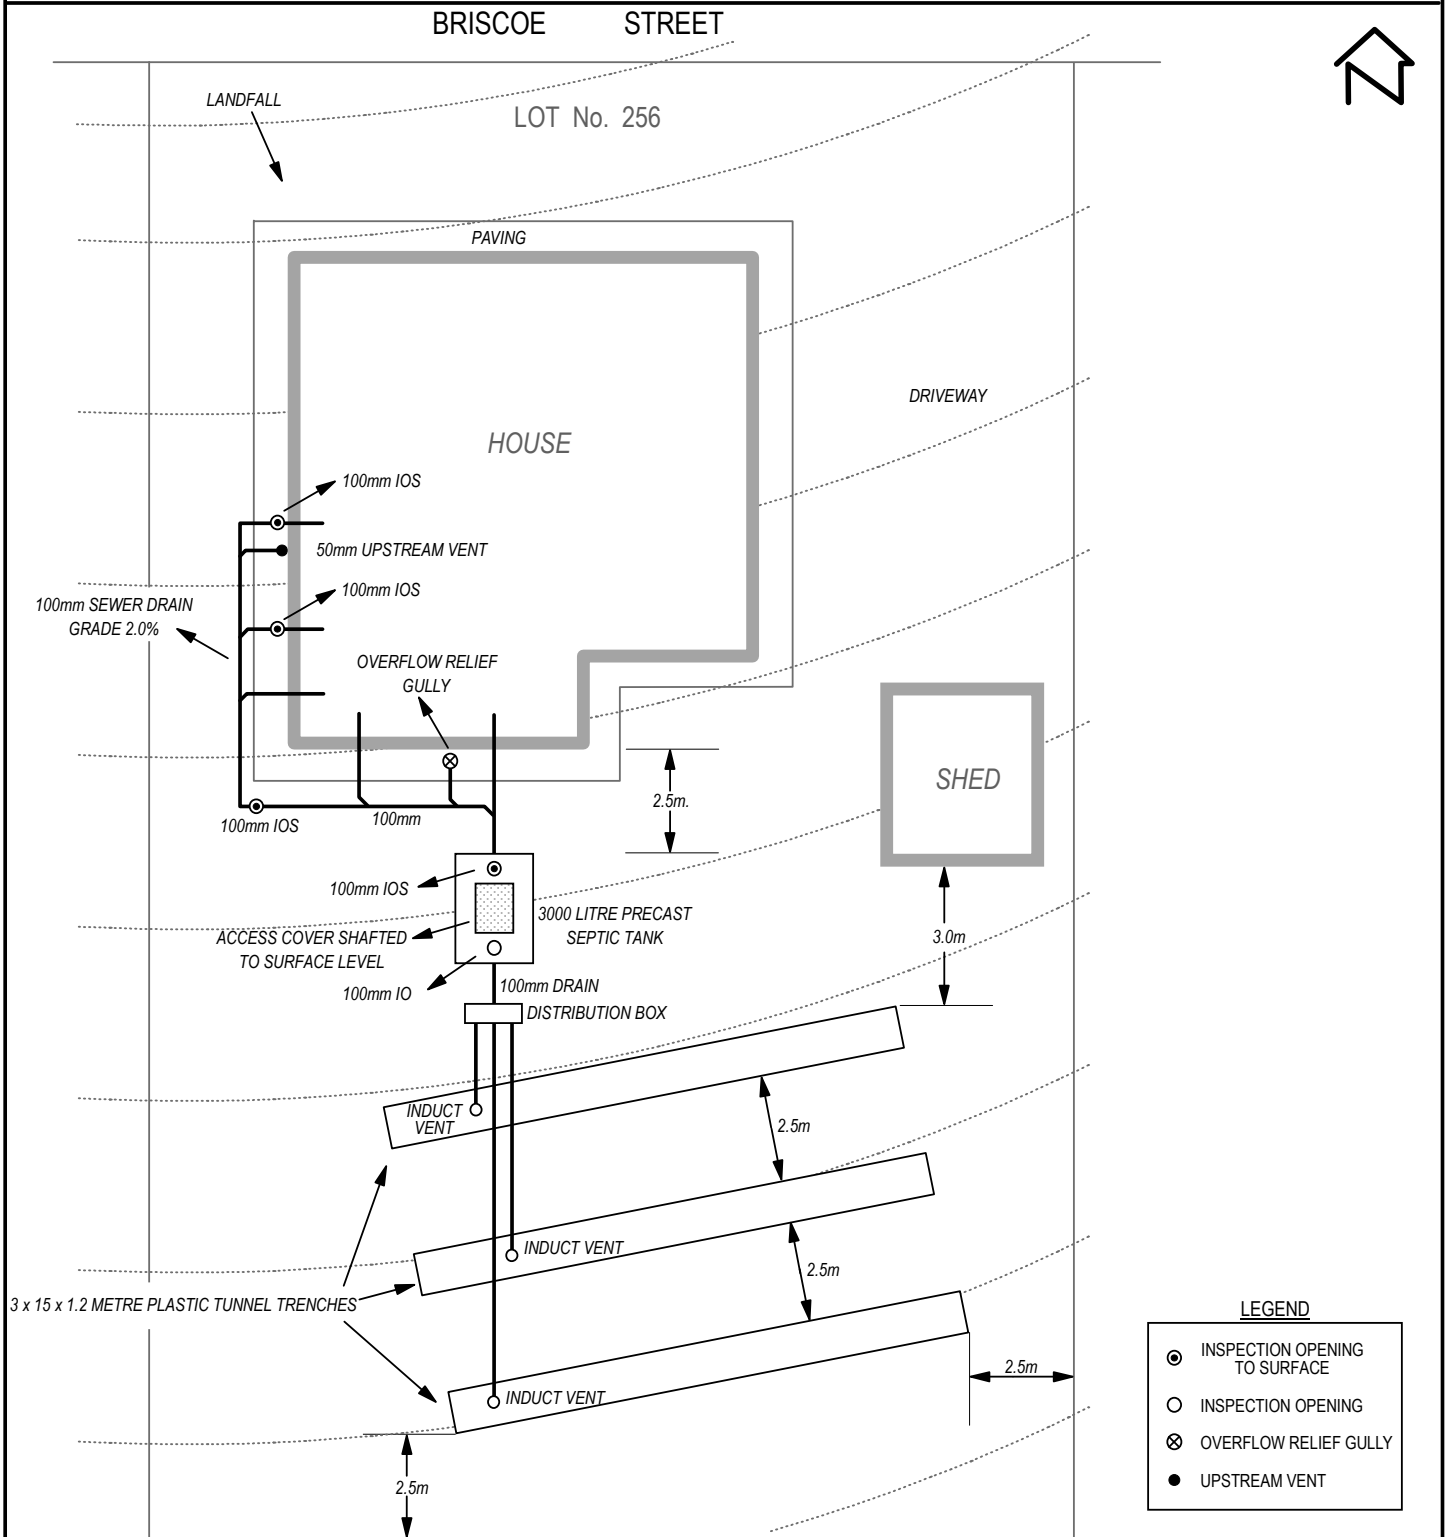

DATE RECEIVED	IMPORTANT: USE BLACK BALLPOINT PEN <u>ONLY</u> FORWARD DRAWING AND CERTIFICATE TO RELEVANT AUTHORITY	PAGE
----------------------	---	-------------


**CERTIFICATES OF COMPLIANCE ARE NOT TRANSFERABLE
AS CONSTRUCTED DRAWING**

RECORD COMPLETE YES / NO

OWNER JOHN CITIZEN HOUSE No. LOT No. 101 STREET SMITH ROAD SUBURB MARINO TIE TO CROSS STREET	SUITABLY QUALIFIED PERSON PRINT NAME IAN PLUMBER DATE SUBMITTED 22/10/2012 TRADING NAME DRAIN PLUMBING SERVICES TELEPHONE / MOBILE 0432 123 123 <div style="display: flex; justify-content: space-between;"> <div> LICENCE NUMBER <div style="border: 1px solid black; padding: 2px; display: inline-block;">1 4 3 8 5 2</div> </div> <div> CERTIFICATE NUMBER <div style="border: 1px solid black; padding: 2px; display: inline-block;">8 7 6 5 4 3 A</div> </div> </div>
---	---

I certify that this plan shows the layout and dimensions of the property wastewater system as measured and drawn by me or under my supervision at the above address.

Signature *I. Plumber*

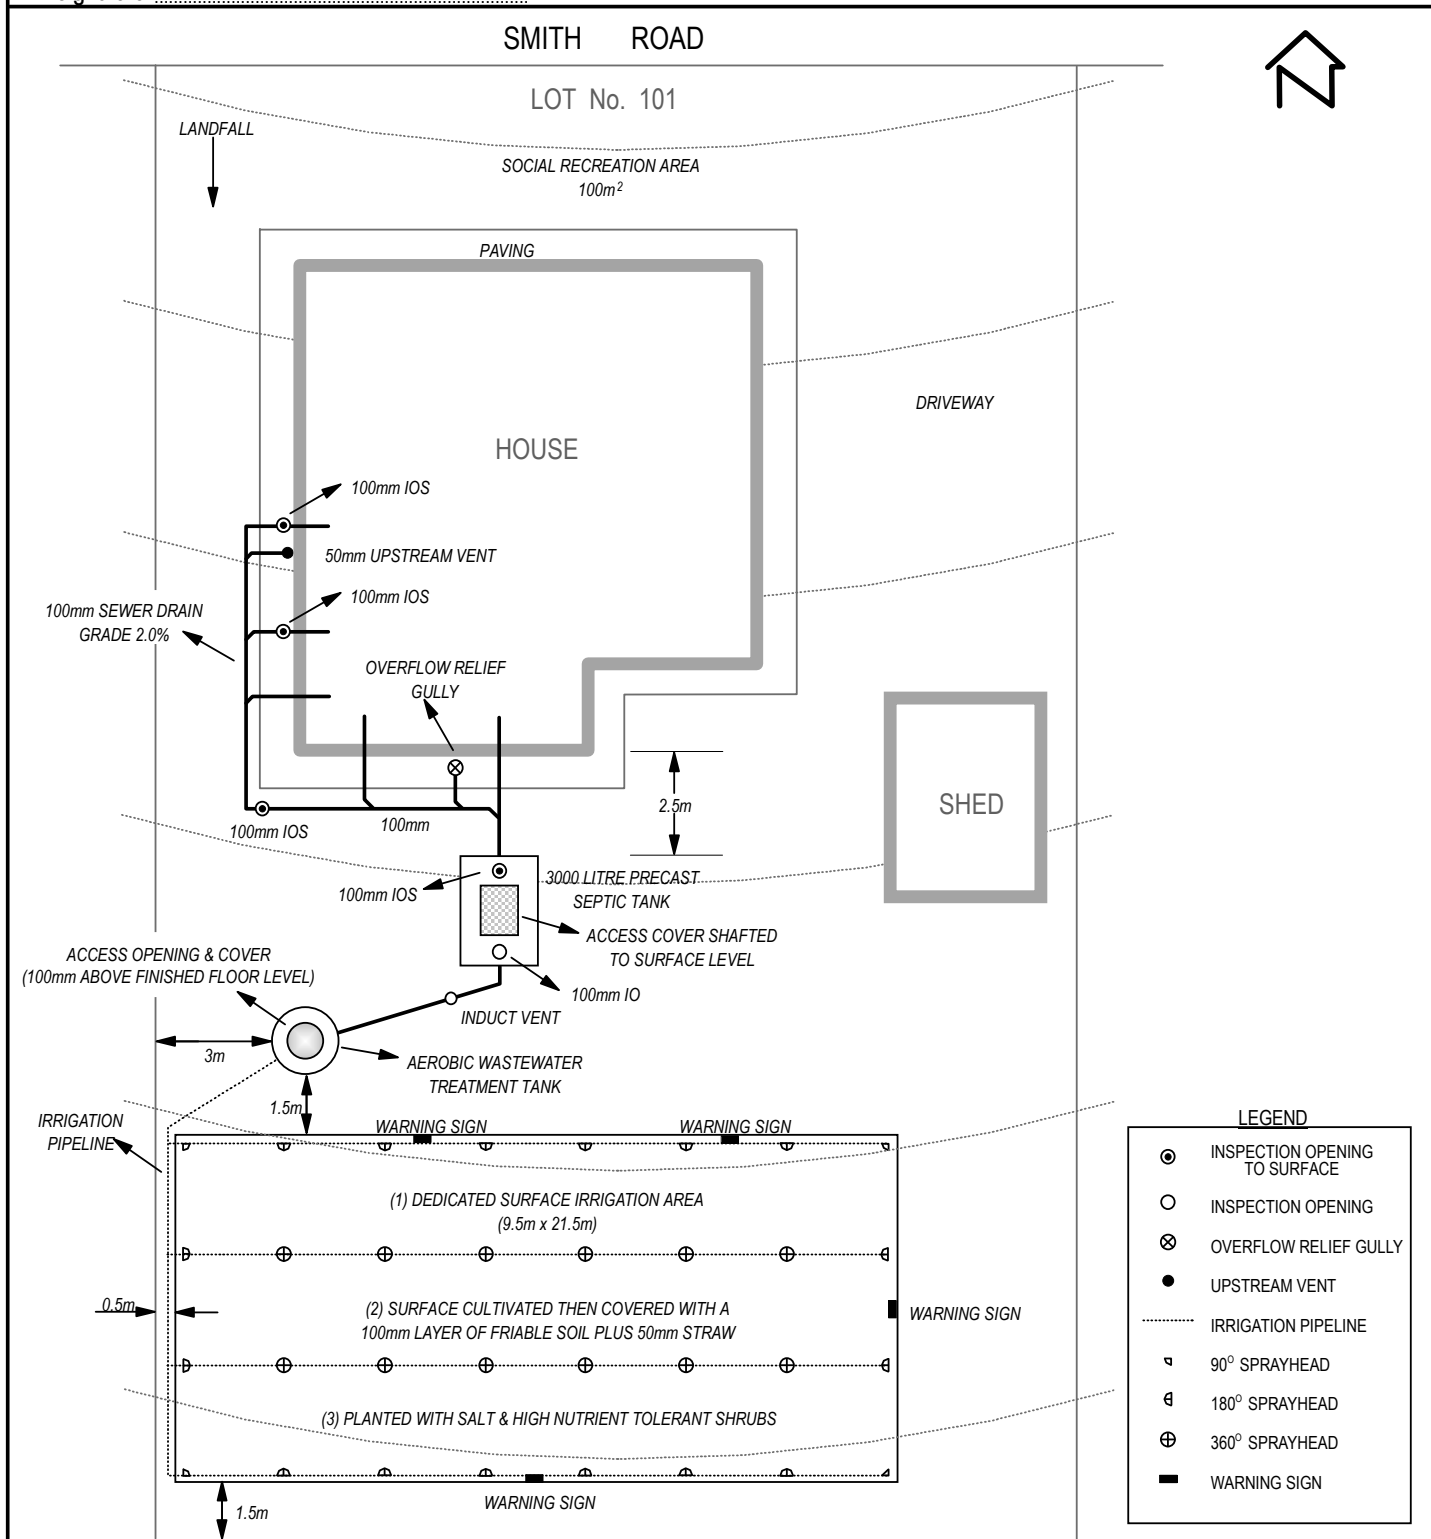

DATE RECEIVED	IMPORTANT: USE BLACK BALLPOINT PEN ONLY FORWARD DRAWING AND CERTIFICATE TO RELEVANT AUTHORITY	PAGE
----------------------	--	-------------